
PREPARED FOR:
LARRY HODGES REALTY
CENTURY 21
C/O RENIA LIVINGSTON
P.O. BOX 939
TWIN LAKES, WI 53181

PLAT OF SURVEY

- OF -

LOT 8 EXCEPT THE EAST 34 FEET AND LOT 9 BLOCK 1, OF ROSE NIPPERSINK GARDENS SUBDIVISION, TOWN 1 NORTH, RANGE 18 EAST, TOWN OF BLOOMFEILD, WALWORTH COUNTY, WISCONSIN.

J.K. SURVEYING INC.
N3705 WILLOW BEND LANE
LAKE GENEVA, WI. 53147
262-248-3697

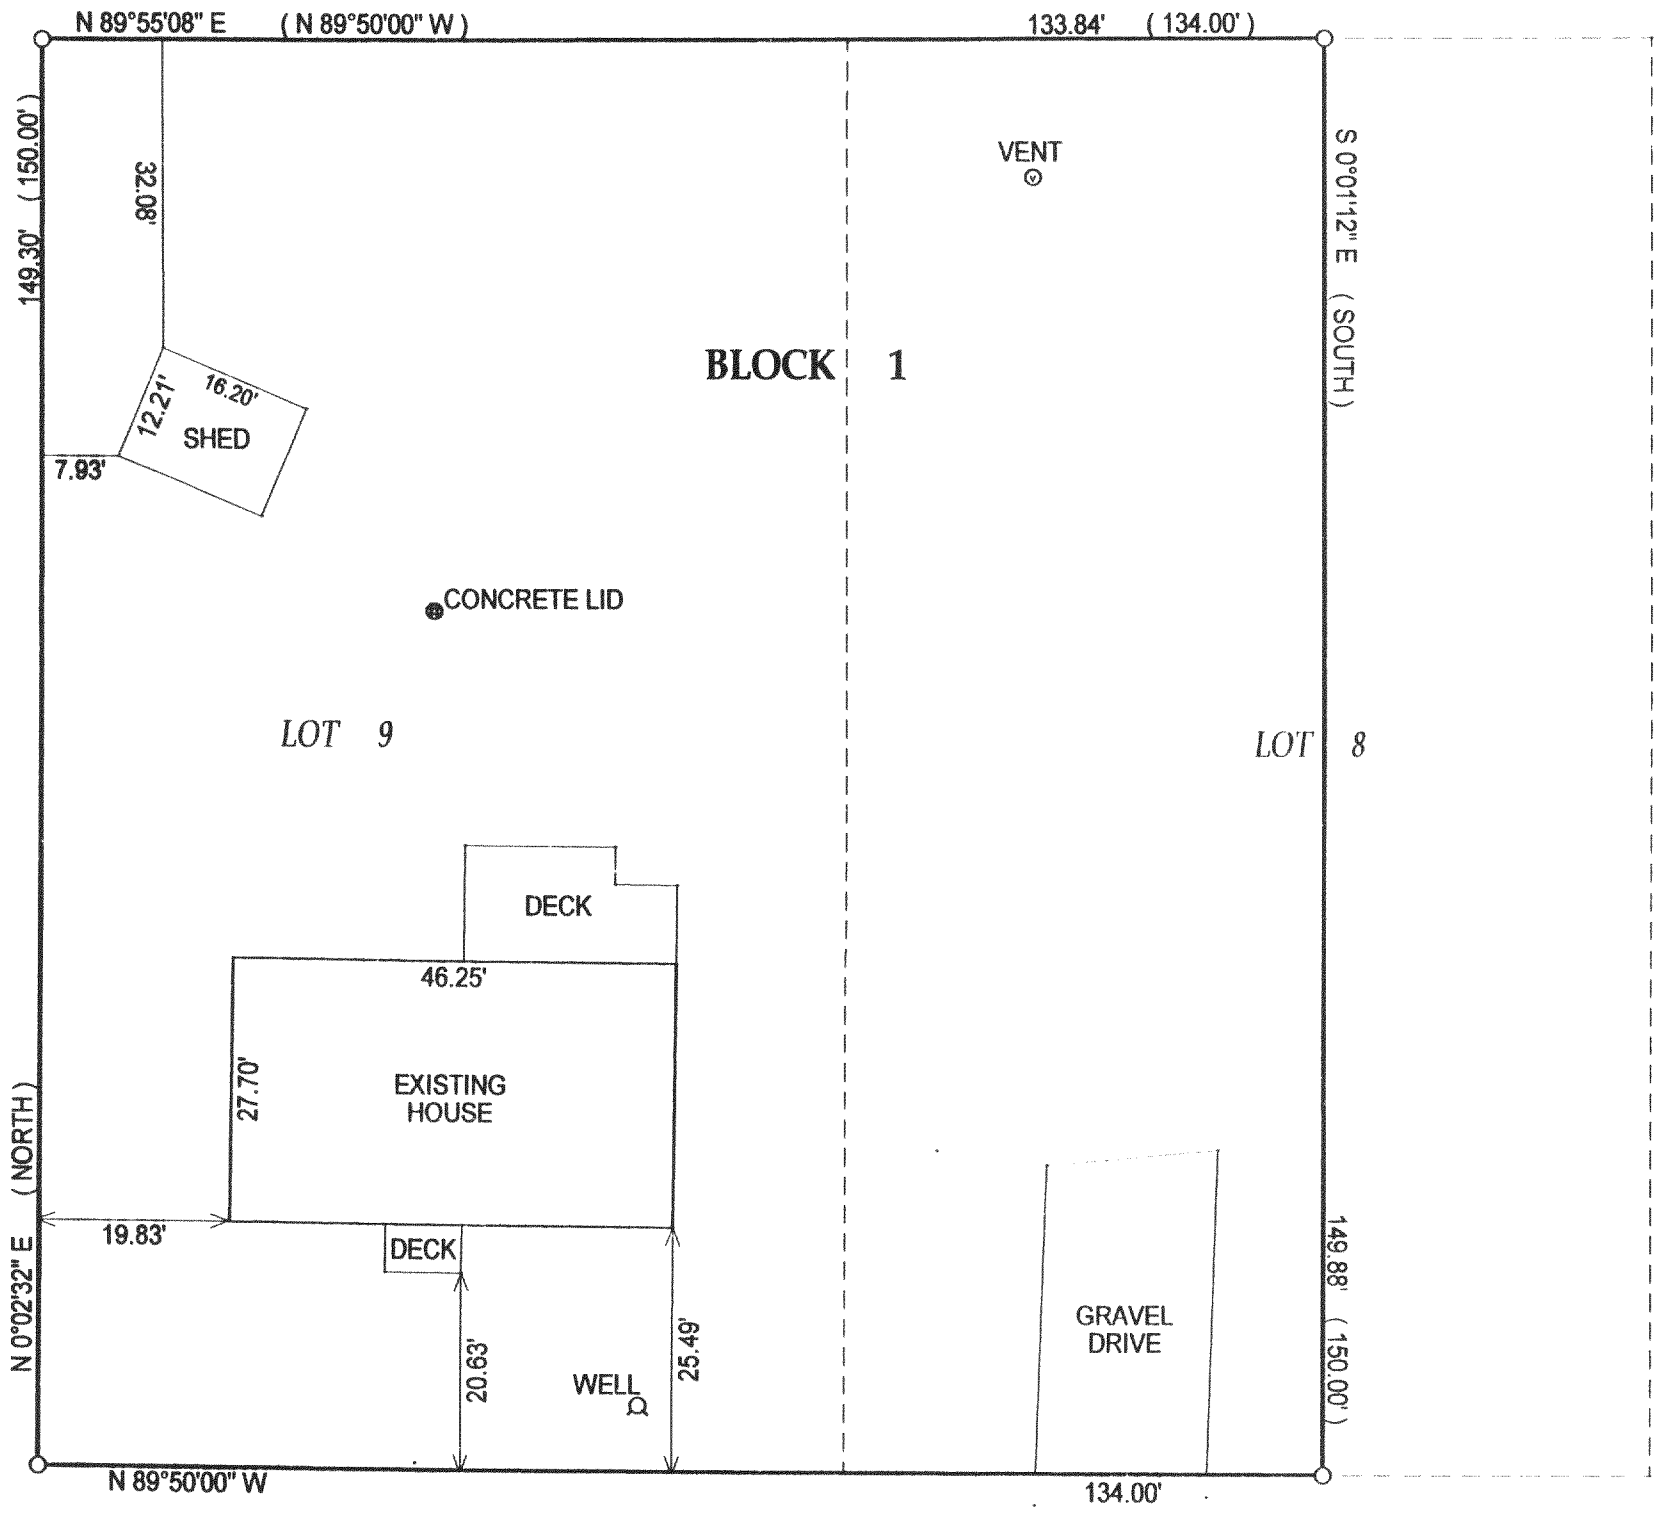

C.L. LILAC AVENUE

(50' WIDE ROAD)

N
W E
S

( )= recorded as

□ = found iron bar

○ = found iron pipe

● = set iron pipe

■ = set iron bar

SCALE 1" = 20'

JOB # 02-395

TAX ID # MRNG00007

COMPARE LEGAL DESCRIPTION ABOVE AND DRAWING WITH DEED. FOR BUILDING RESTRICTIONS AND EASEMENTS NOT SHOWN,REFER TO DEED, ABSTRACT SOURCES AND LOCAL MUNICIPAL CODES. NOTIFY THE SURVEYOR IMMEDIATELY OF ANY DISCREPANCY.

"I hereby certify that I have surveyed the above described property and that the above map is a true representation thereof and shows the size and location of all visible structures, apparent easements and encroachments if any."
This survey is made for the present owners of the property, and those who purchase, mortgage, or guarantee the title thereto, within one year from the date hereof.

DATED THIS THE 8th DAY OF AUGUST 2002.

RECEIVED
AUG 16 2002

WISCONSIN
JEFFERY L. KIMPS
2436
LAKE GENEVA, WIS.
LAND SURVEYOR

JEFFREY L KIMPS S - 2436
Wisconsin Registered Land Surveyor
(original if signed in red)

118-2140