PLAT OF SURVEY
–OF–

LOTS 9322, 9323, 9324, 9325 AND 9326 AS DESIGNATED AND DELINEATED ON THE MAP ENTITLED "MAP OF SECTION 'FIVE' OF PELL LAKE, WALWORTH COUNTY, WISCONSIN" AND RECORDED IN THE OFFICE OF THE REGISTER OF DEEDS IN AND FOR THE COUNTY OF WALWORTH, STATE OF WISCONSIN ON THE 2ND DAY OF SEPTEMBER, 1924. SAID REAL PROPERTY BEING SITUATED IN THE TOWN OF BLOOMFIELD, WALWORTH COUNTY, WISCONSIN.

SURVEY FOR: COLDWELL BANKER–PRIMUS REALTY OF GENEVA LAKES
SURVEY LOCATION: N1199 BEECH DRIVE

RECEIVED
FEB 2 0 2003

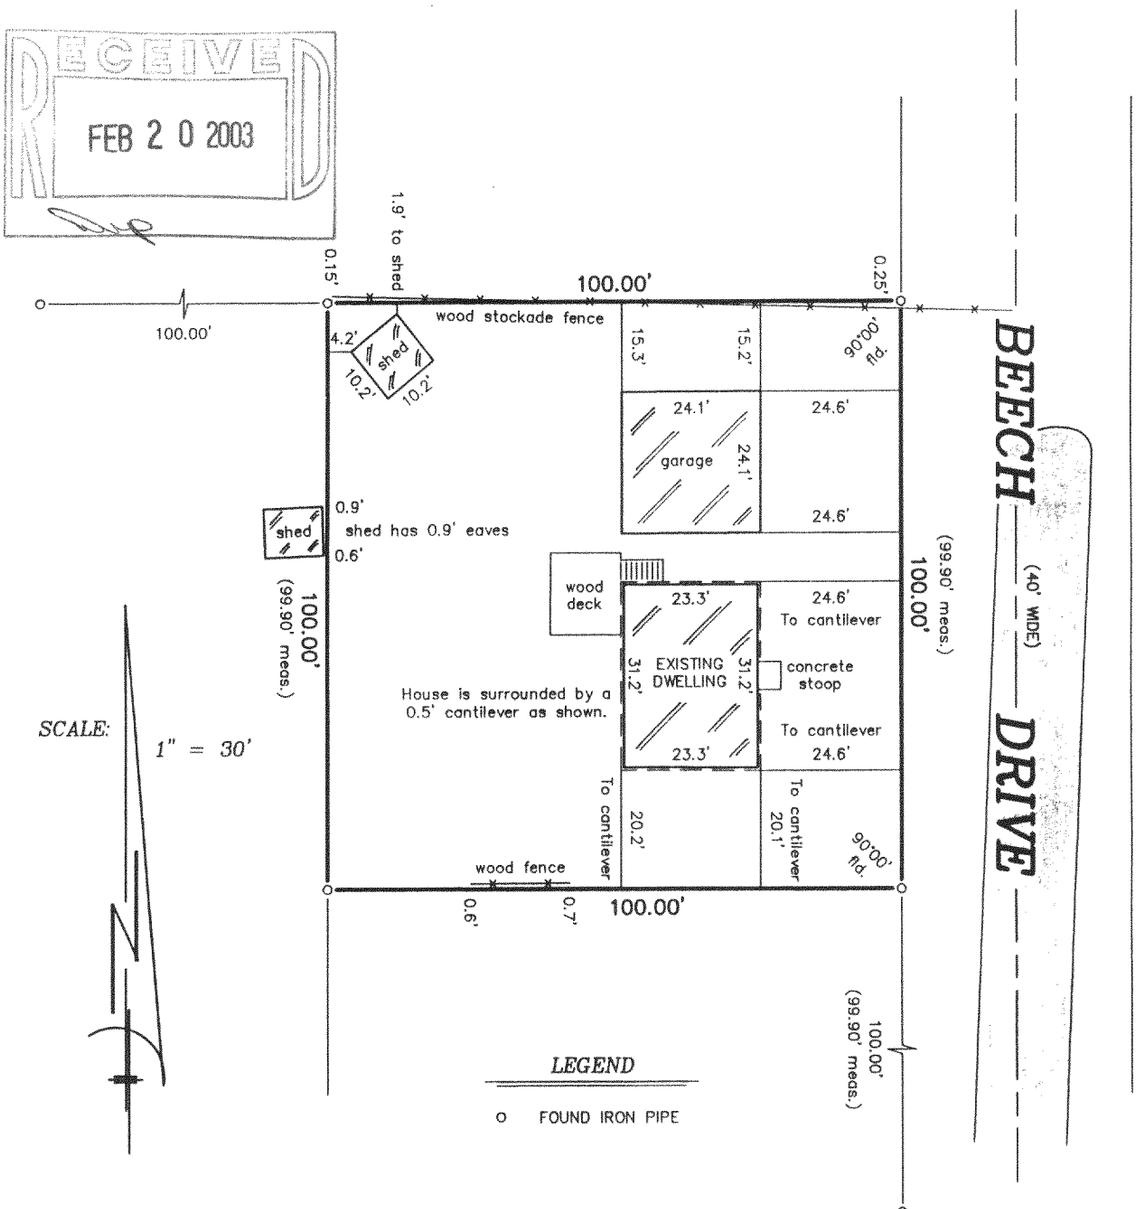

"I hereby certify that I have surveyed the above described property and that the above map is a correct representation thereof and shows the size and location of the property, its exterior boundaries, the location of all visible structures and dimensions of all principal buildings thereon, boundary fences, apparent easements, roadways and encroachments, if any."

"This survey is made for the use of the present owners of the property, and those who purchase, mortgage, or guarantee the title thereto within one year from date hereof."

WISCONSIN
ROBERT J. WETZEL
S-1778
BURLINGTON WIS.
LAND SURVEYOR

THIS IS NOT AN ORIGINAL PRINT UNLESS THIS SEAL IS RED.

B.W. SURVEYING, INC.
412 N. PINE STREET
BURLINGTON, WI 53105
(262)–767–0225

ROBERT J. WETZEL S-1778

JANUARY 29, 2003
DATE

5744
JOB NUMBER

MPL-1889

118-2215