


DUNHAM & RASMUSSEN
SURVEYING & ENGINEERING
DELAVER, WISCONSIN

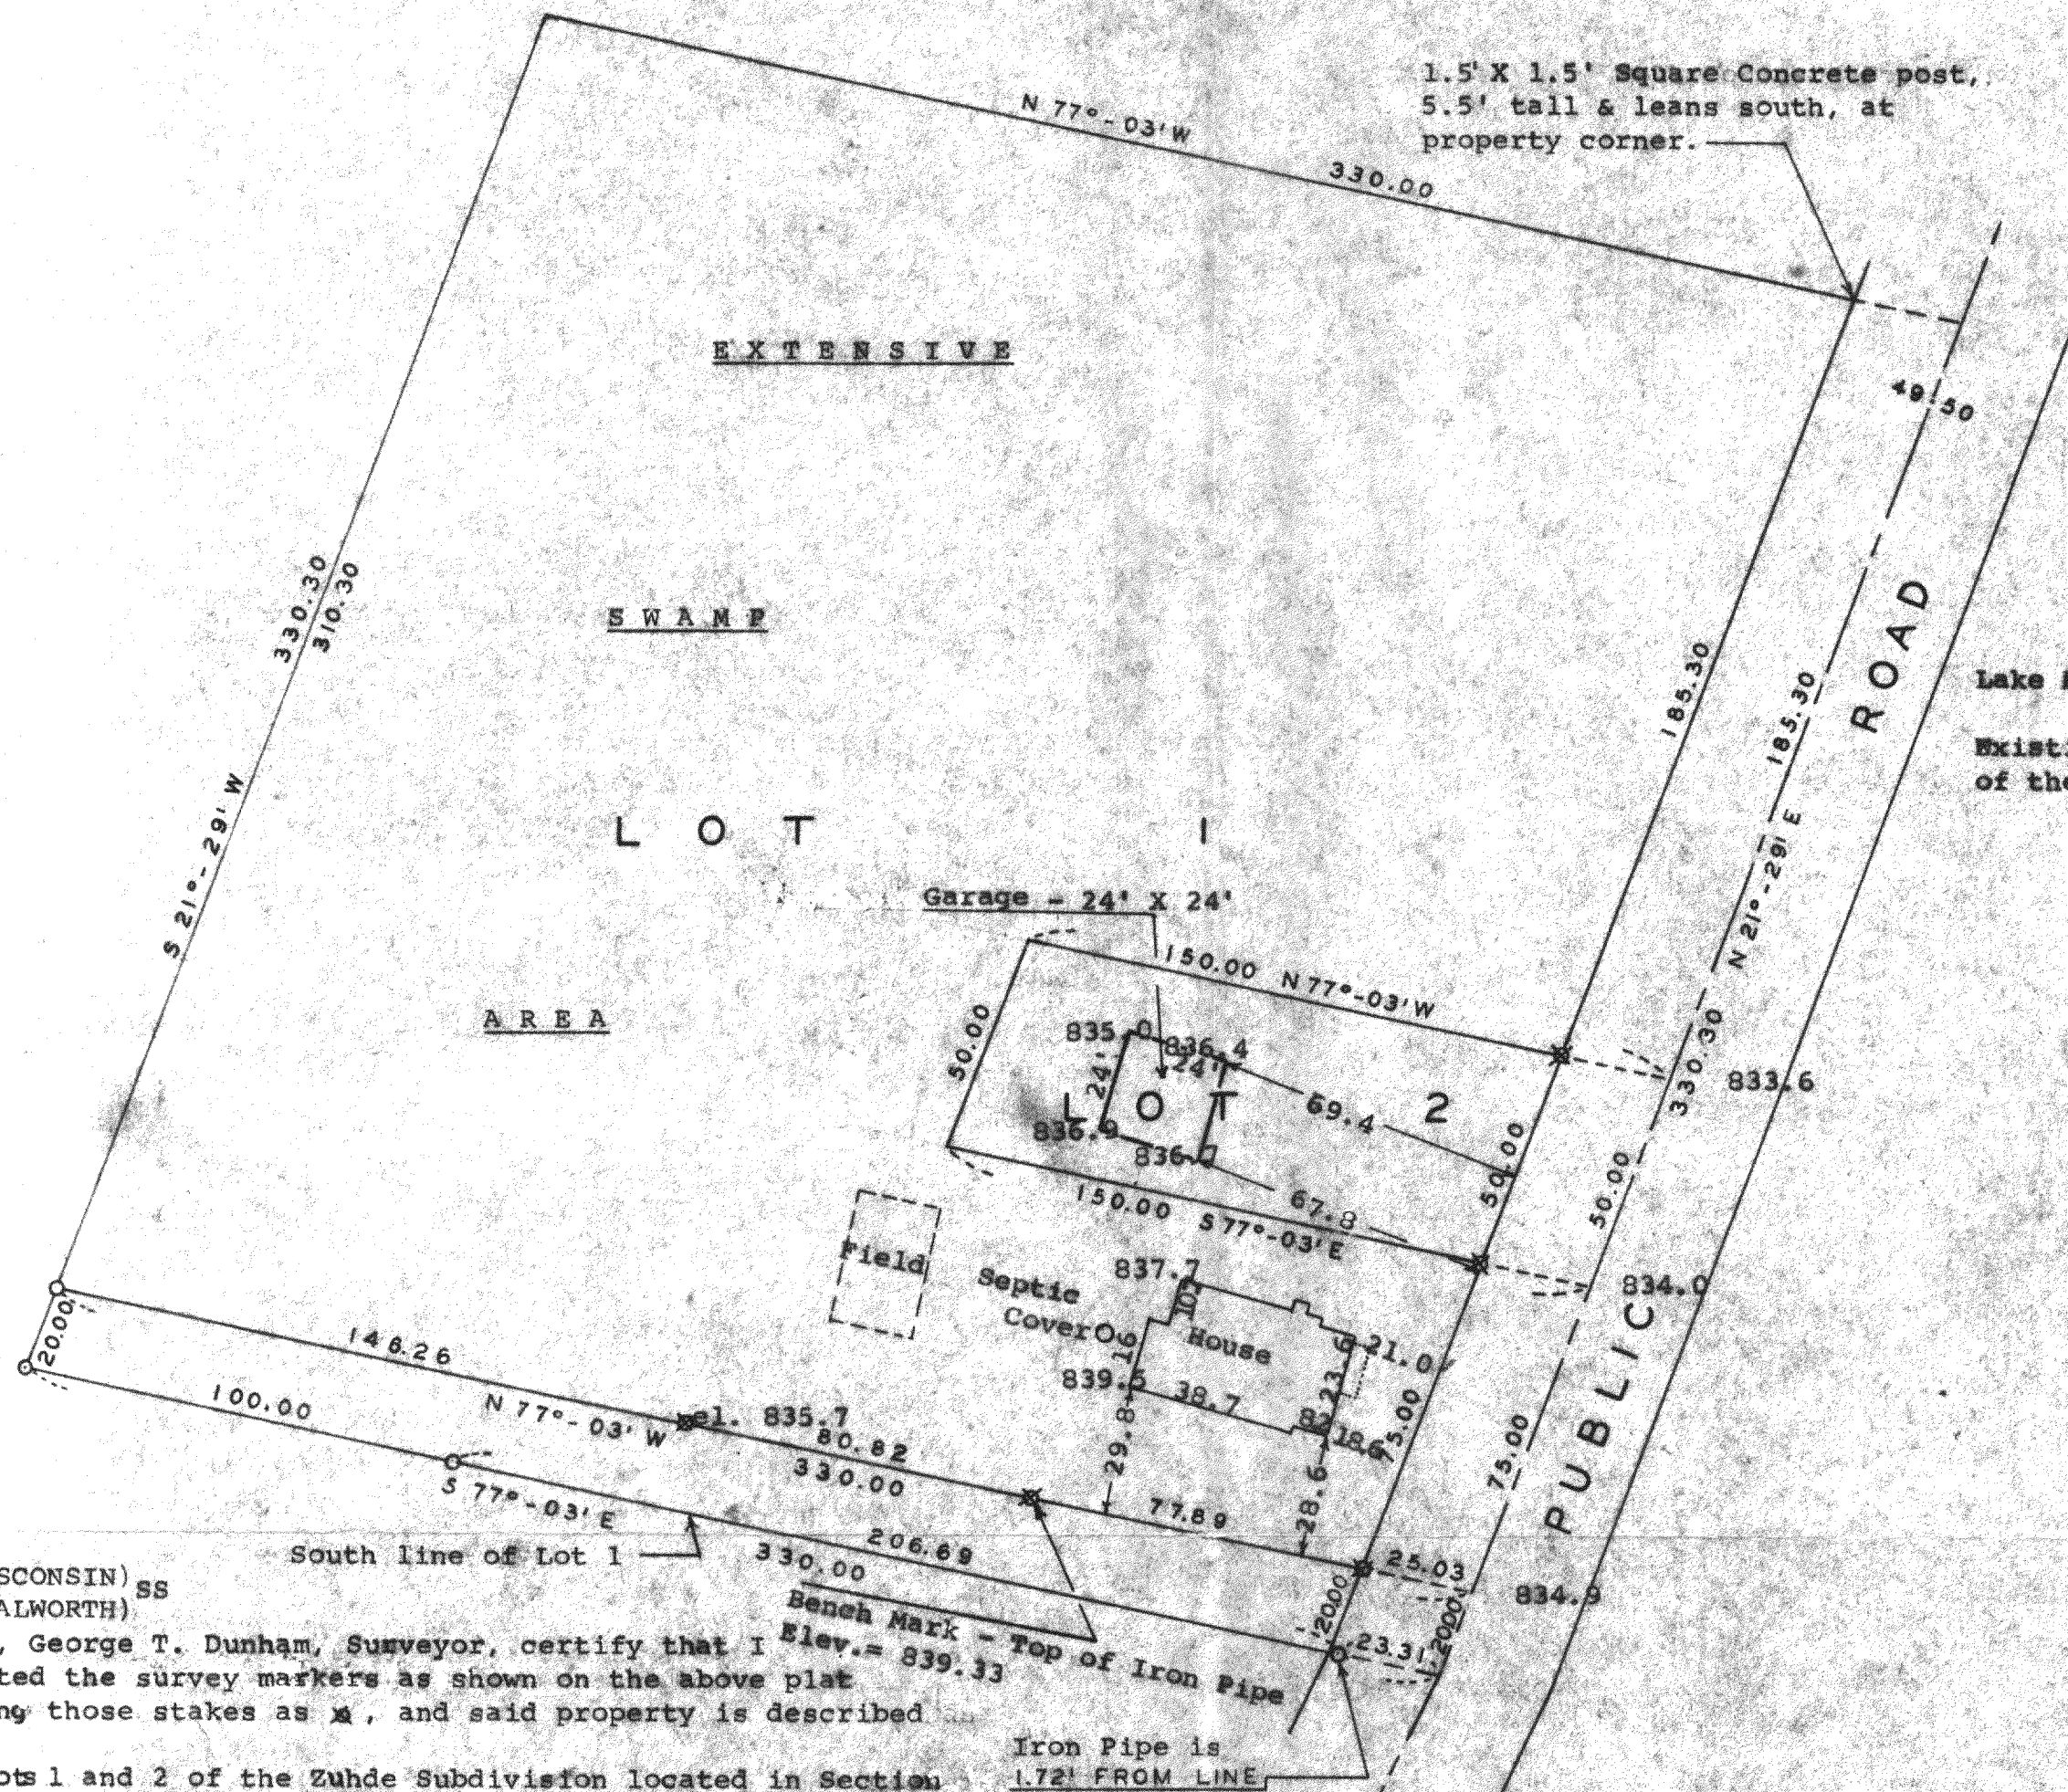

Assumed
Lake Elevation Sept. 9, 1991 = 830.0
Existing Well is located in the basement
of the house



SCALE = 1" = 40'
O = IRON PIPE

W = Iron Pipe relocated 9/9/91

Survey ordered 9/9/91 by
Donald Genens
P.O. Box 54
Powers Lake, WI 53159

STATE OF WISCONSIN) SS
COUNTY OF WALWORTH)


I, George T. Dunham, Surveyor, certify that I have relocated the survey markers as shown on the above plat by relocating those stakes as X, and said property is described as follows:

Lots 1 and 2 of the Zuhde Subdivision located in Section 13, T 1 N, R 18 E, Walworth County, Wisconsin, EXCEPTING THEREFROM, A parcel of land located in Lot 1 of the Zuhde Subdivision in Section 13, T 1 N, R 18 E of Walworth County, Wisconsin described as follows: Beginning in the centerline of the public road at the southeast corner of said Lot 1; thence N21°29'E along the centerline of said road 20.00 feet; thence N77°03'W parallel with the southerly line of said Lot 1, 330.00 feet; thence S21°29'W along the westerly line of said Lot 1, 20.00 feet to the southwest corner of said Lot 1; thence S77°03'E along the southerly line of said Lot 1, 330.00 feet to the place of beginning.

and that the plat shown hereon is a correct representation thereof and shows the size and location of the property, its exterior boundaries, the location of all visible structures and dimensions of all principal buildings thereon, boundary fences, apparent easements, roadways and visible encroachments, if any, and that I have surveyed the property hereon described, according to the official records, to the best of my knowledge and belief.

October 8, 1998

George T. Dunham
George T. Dunham, Surveyor

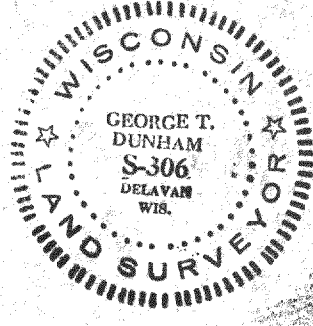

Plat of survey of a part of lot 1 of the Zuhde Subdivision in section 13, T 1 N R 18 E of Walworth County, Wisconsin, & Lot 2, Zuhde Subd. June 16, 1960

George T. Dunham
George T. Dunham, surveyor

STATE OF WISCONSIN) SS
COUNTY OF WALWORTH)

I, George T. Dunham, Surveyor, certify that on this date I did relocate the survey stakes marked as X. That the map shown hereon is a correct representation of all lot lines and shows the size and location of the property, its exterior boundaries, the location of all visible structures and dimensions of all principal buildings thereon, boundary fences, apparent easements, roadways and visible encroachments, if any, and the location of the proposed garage to be built on said property, elevations in relation to the existing water level on Powers Lake, and that I have surveyed the property shown on the above plat, according to the official records, to the best of my knowledge and belief.

September 9, 1991

George T. Dunham
George T. Dunham, Surveyor

