PLAT OF SURVEY AND LEGAL DESCRIPTIONS FOR PROPOSED PARCEL SPLIT

PARCEL 1:

LOTS 1285–1289, BLOCK 21, PELL LAKE ADDITION, ACCORDING TO THE RECORDED PLAT THEREOF. SAID LAND BEING IN THE TOWN OF BLOOMFIELD, COUNTY OF WALWORTH AND STATE OF WISCONSIN.

PARCEL 2:

LOTS 1283–1284 AND LOTS 1290–1294, BLOCK 21, PELL LAKE ADDITION, ACCORDING TO THE RECORDED PLAT THEREOF. SAID LAND BEING IN THE TOWN OF BLOOMFIELD, COUNTY OF WALWORTH AND STATE OF WISCONSIN.

SURVEY FOR: DEBBIE LEWIS

SURVEY ADDRESS: N1302 CHICAGO DRIVE

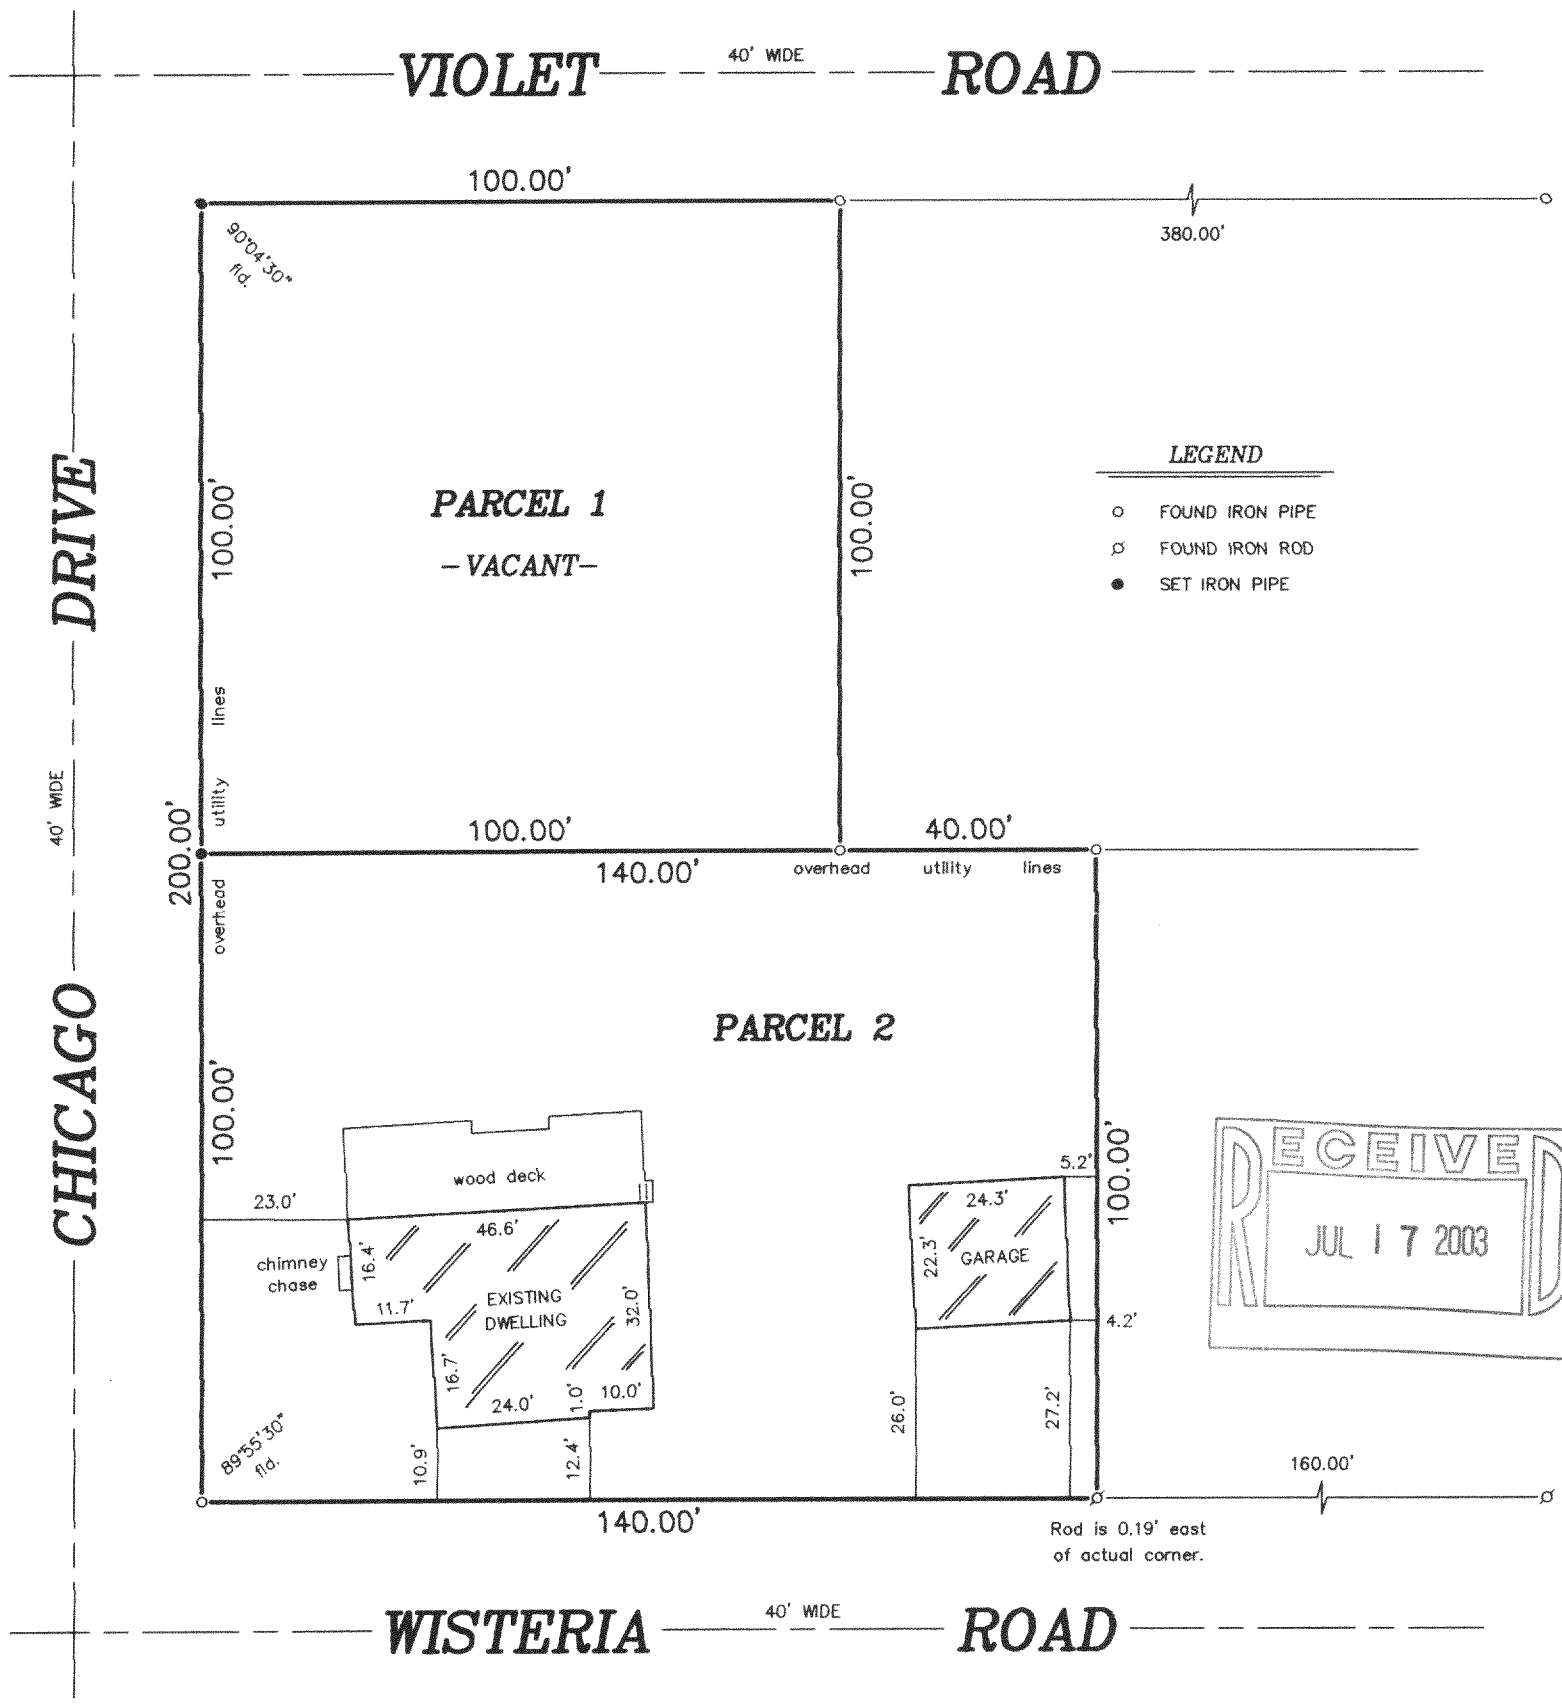

RECEIVED
JUL 17 2003

"I hereby certify that I have surveyed the above described property and that the above map is a correct representation thereof and shows the size and location of the property, its exterior boundaries, the location of all visible structures and dimensions of all principal buildings thereon, boundary fences, apparent easements, roadways and encroachments, if any."

"This survey is made for the use of the present owners of the property, and those who purchase, mortgage, or guarantee the title thereto within one year from date hereof."

SCALE: 1" = 30'

WISCONSIN
ROBERT J. WETZEL
S-1778
BURLINGTON WIS.
LAND SURVEYOR

THIS IS NOT AN ORIGINAL PRINT UNLESS THIS SEAL IS RED.

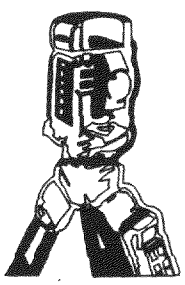

B.W. SURVEYING, INC.

LAND SURVEYS
MAPPING AND PLANNING
412 N. PINE STREET
BURLINGTON, WI 53105
(262)–767–0225

ROBERT J. WETZEL S-1778

MAY 28, 2003 — DATE

5908 — JOB NUMBER

MPLA-263

118-2291