


AMBIT LAND SURVEYING
P. O. Box 42
Bassett, Wisconsin 53101-0042

PLAT OF SURVEY OF

PHONE: 262-537-4674
FAX: 262-537-4221

PARCEL 1: All the North Half of the Southeast Quarter of Section 26, Township 1 North, Range 18 East of the 4th Principal Meridian, Town of Bloomfield, Walworth County, Wisconsin, that lies West of GRA DEN WOODS Subdivision.

PARCEL 2: Lots 7, 8, 9, 10, 11 and 12 of GRA DEN WOODS, located in the North Half of the Southeast Quarter of Section 26, Township 1 North, Range 18 East of the 4th Principal Meridian, Town of Bloomfield, Walworth County, Wisconsin.

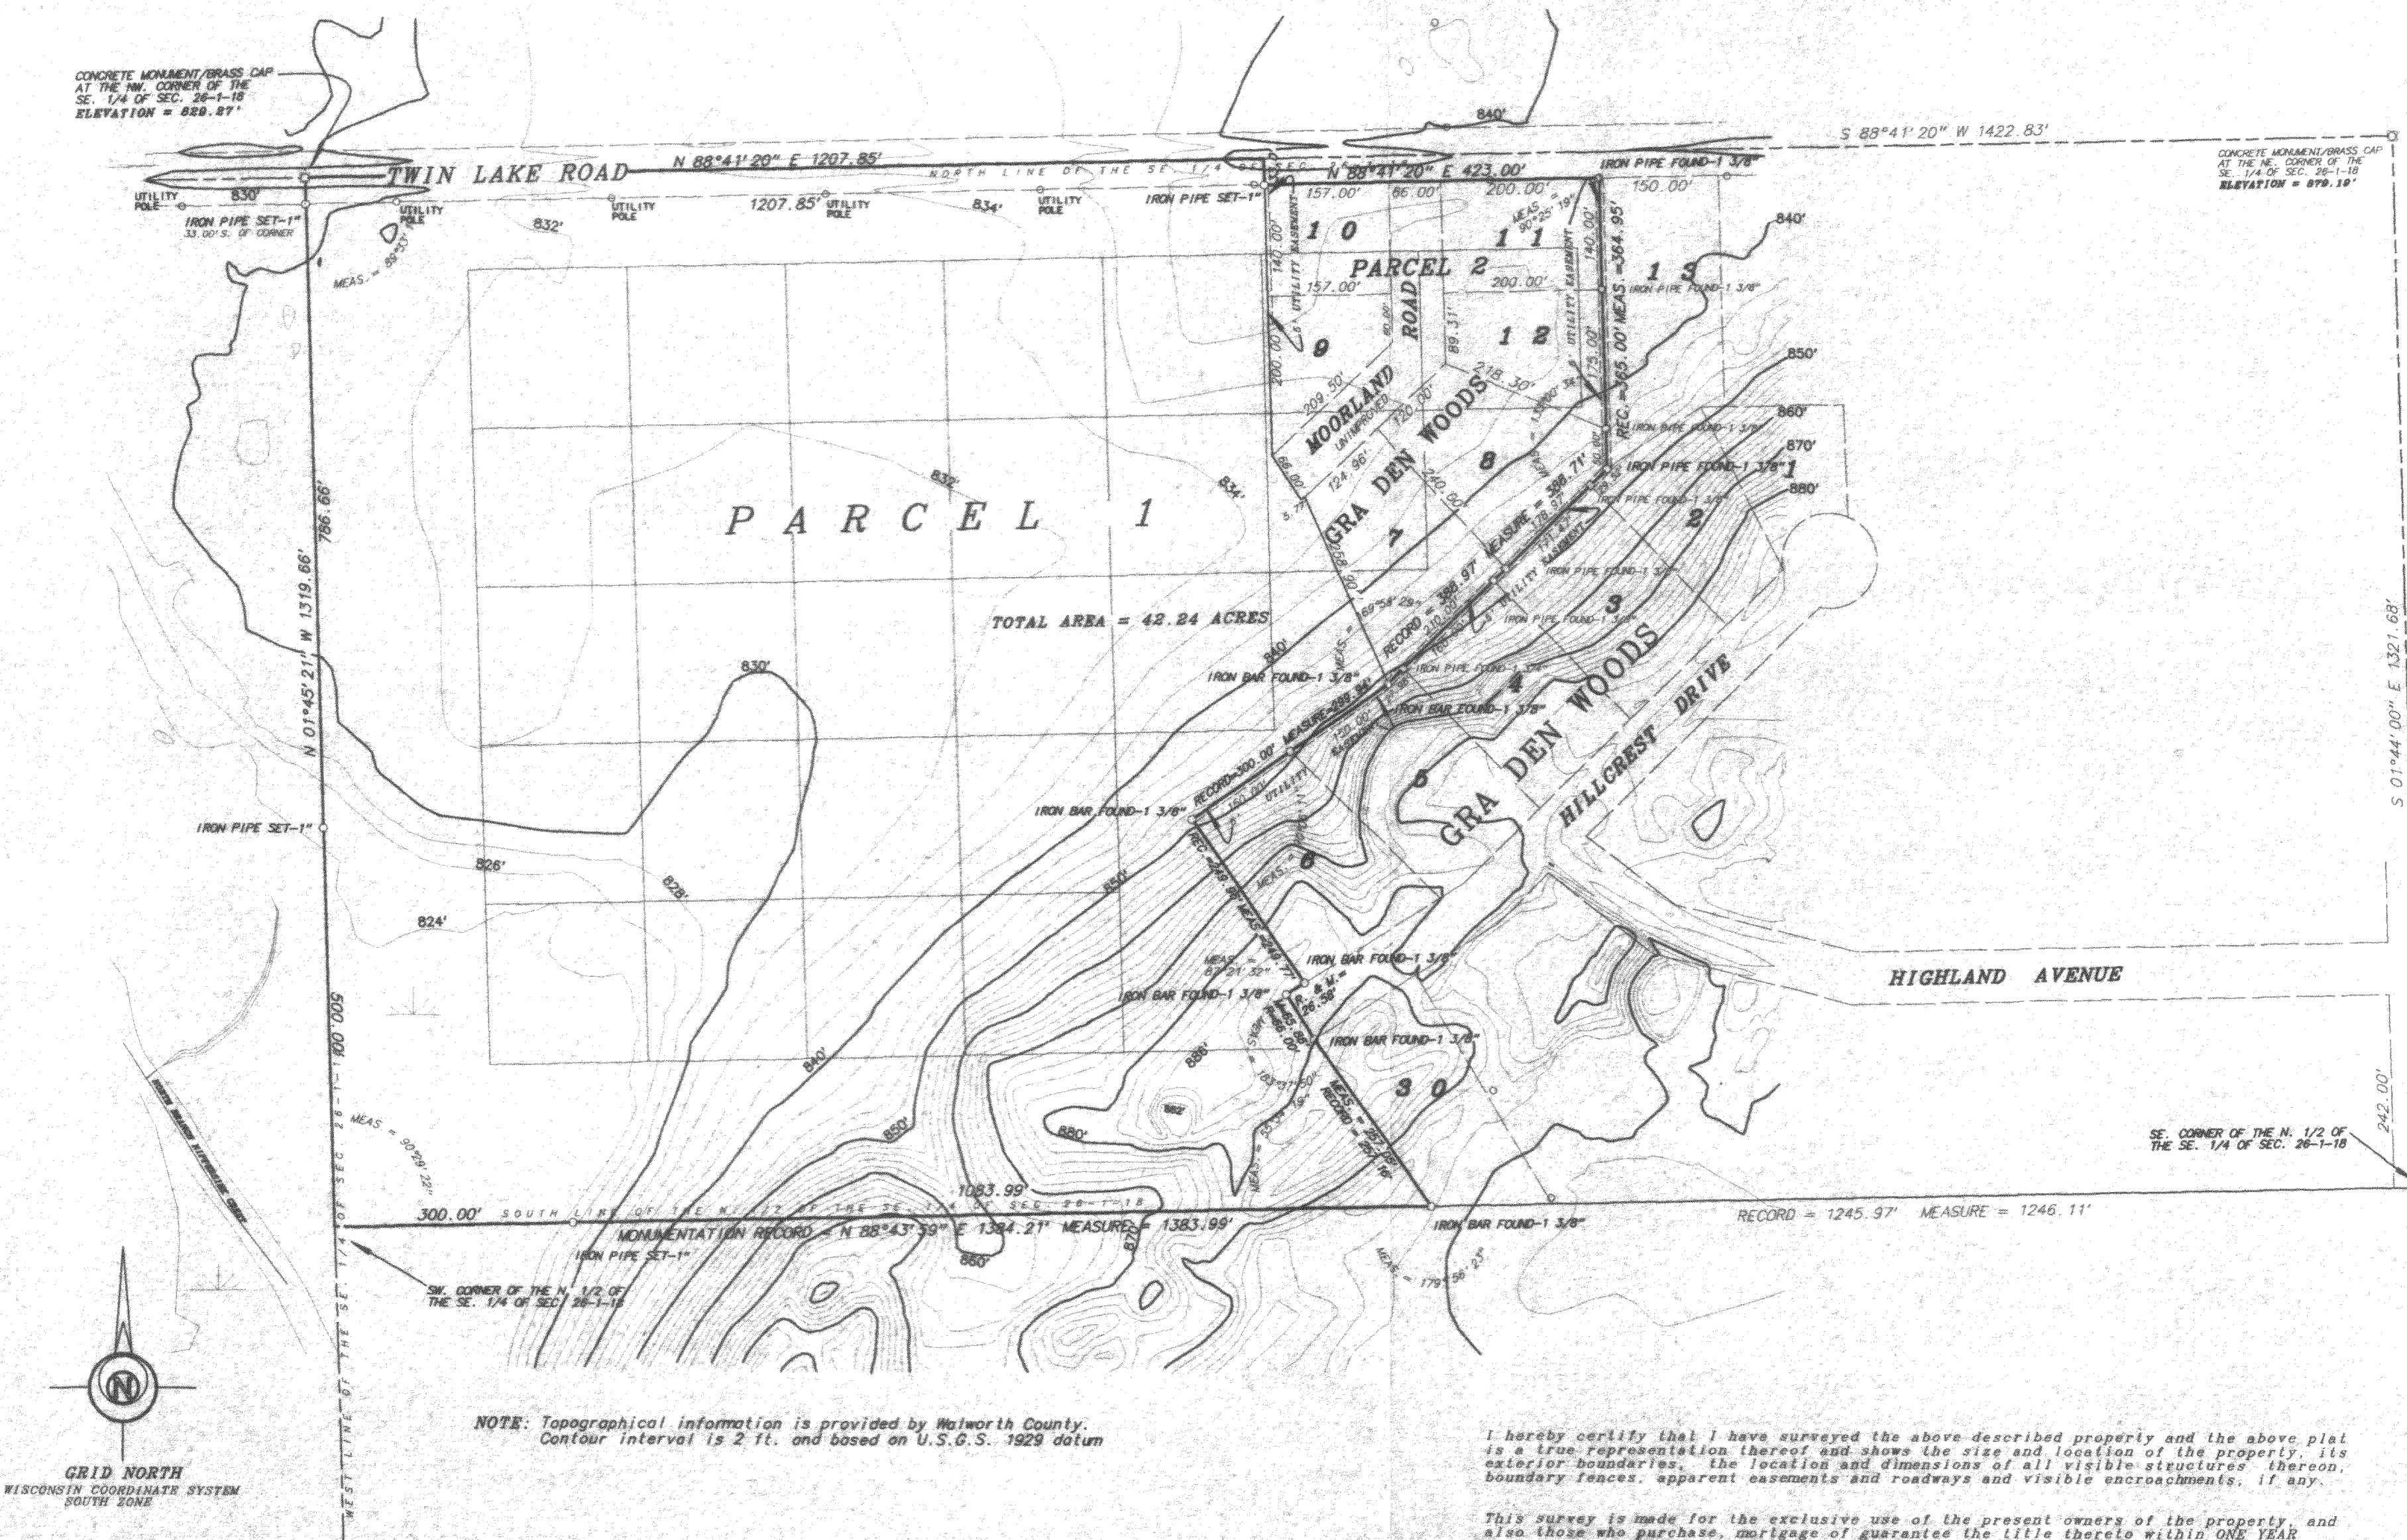


SCALE 1 inch = 160 feet

ORDERED BY D. Laurine

JOB NO. 03204

MGDW-7 MGDW-11
MGDW-8 MGDW-12
MGDW-9 MB26-8
MGDW-10

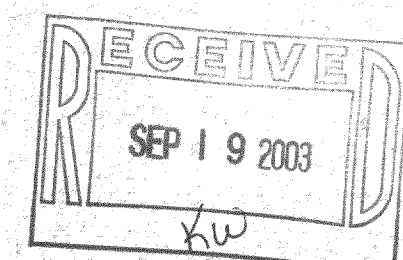

118-2316