


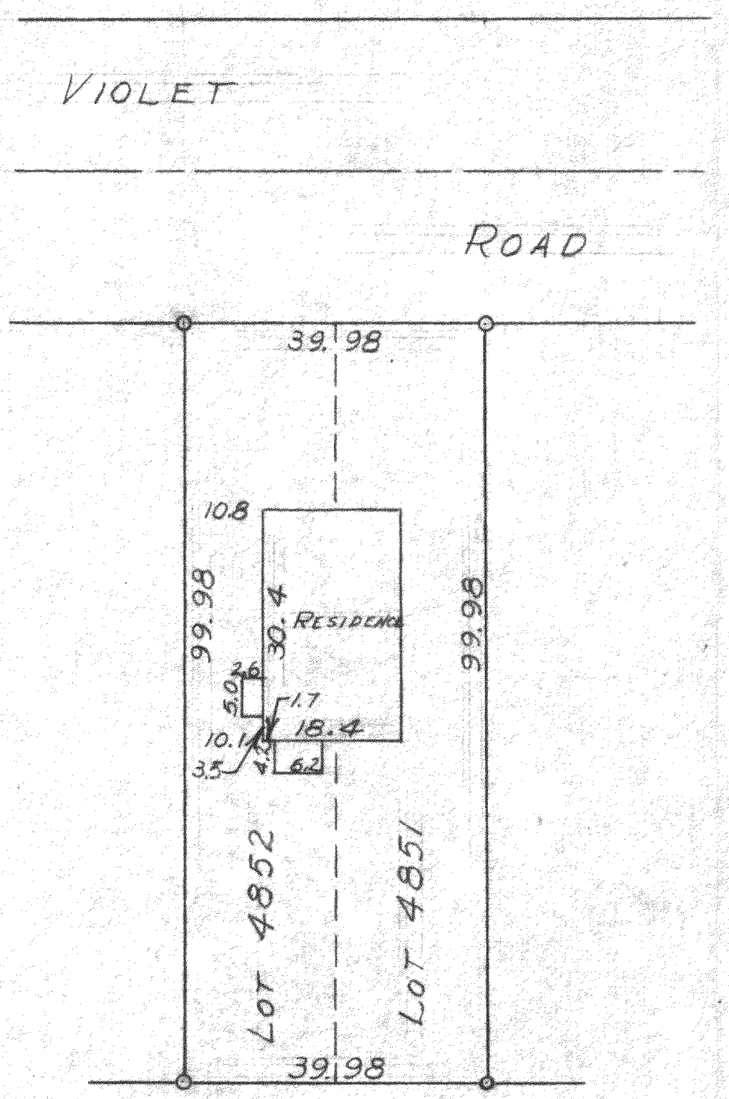

SCALE ~ 1" = 20'
O ~ IRON PIPE

PLAT OF SURVEY OF LOTS 4851 AND 4852, SECTION 3 OF PELL LAKE SUBDIVISIONS LOCATED IN TINRIBE, WALWORTH COUNTY, WISCONSIN
JULY 20, 1957

George T. Dunham

GEORGE T. DUNHAM, SURVEYOR
DELAVAN, WISCONSIN

118-24