037321
037321S1.DWG

DEGEN-FOAT SURVEYING LLC

100 SOUTH SECOND STREET
WATERFORD, WISCONSIN
(262)534-5404 (FAX)534-2022

PLAT OF SURVEY

LOTS 3364 THRU 3368, BLOCK 72, SECTION 3 OF PELL LAKE SUBDIVISION, LOCATED IN SECTION 15, TOWN 3 NORTH, RANGE 18 EAST, TOWNSHIP OF BLOOMFIELD, WALWORTH COUNTY, WISCONSIN.

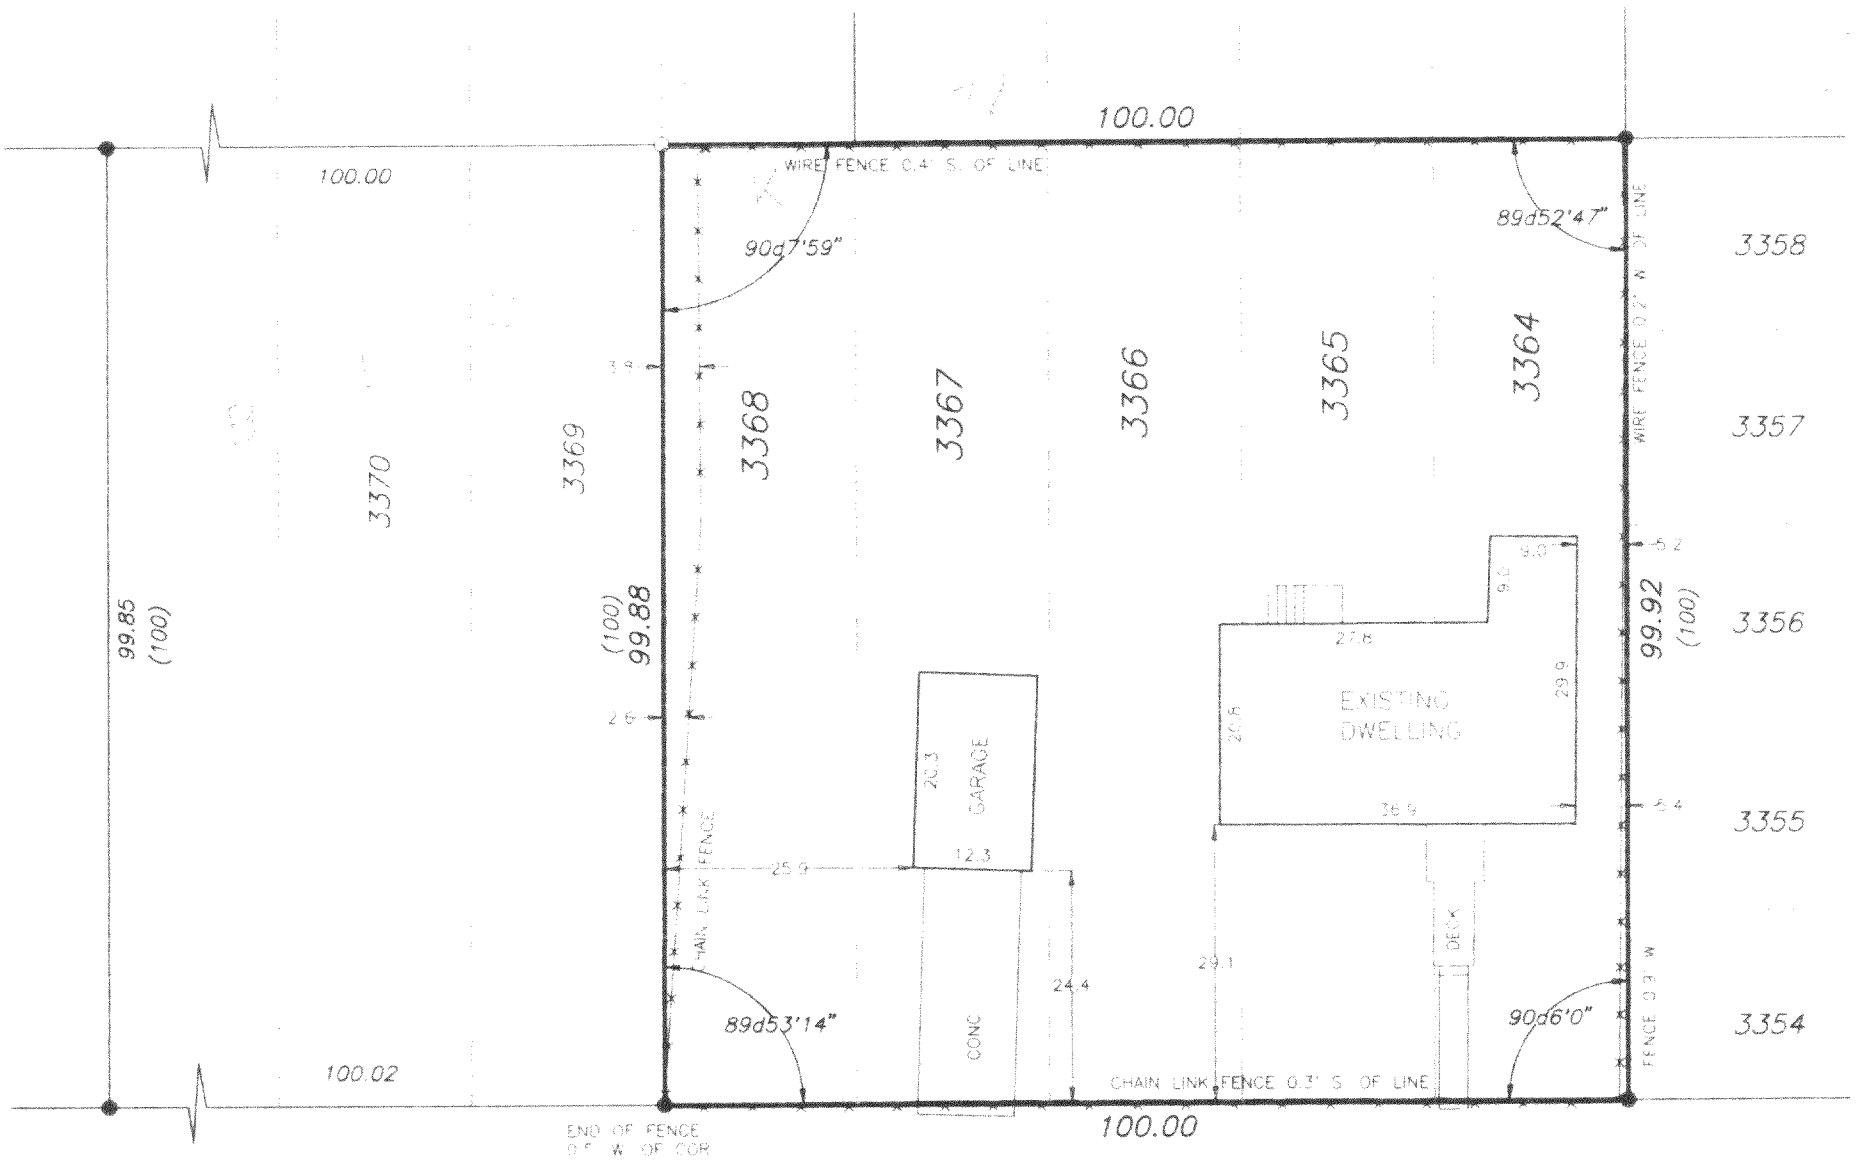

LEGEND

- ● – FOUND IRON PIPE
- ○ – SET IRON PIPE
- –x–x– – FENCE
- ( ) – RECORDED AS

SURVEY PREPARED FOR: MIKE NELLESEN
RE/MAX SOUTHERN LAKES
112 ELIZABETH LANE
GENOA CITY, WISCONSIN 53128

RECEIVED
FEB 14 2005

SCALE: 1" = 20'

WISCONSIN
GARY B. FOAT
S-1998
Waterford, Wis.
REGISTERED LAND SURVEYOR

I HEREBY CERTIFY THAT I HAVE SURVEYED THE ABOVE DESCRIBED PROPERTY AND THE ABOVE MAP IS A TRUE REPRESENTATION THEREOF AND SHOWS THE SIZE AND LOCATION OF THE PROPERTY, THE LOCATION OF ALL VISIBLE STRUCTURES AND DIMENSIONS OF ALL PRINCIPAL BUILDINGS THEREON, BOUNDARY FENCES, APPARENT EASEMENTS, ROADWAY AND VISIBLE ENCROACHMENTS, IF ANY.

THIS SURVEY IS MADE FOR THE PRESENT OWNERS OF THE PROPERTY, AND ALSO THOSE WHO PURCHASE OR GUARANTEE THE TITLE THERETO WITHIN (1) YEAR FROM THE DATE HEREOF

DATED AT WATERFORD, WI THIS 5th DAY OF NOVEMBER 20 03

RECERTIFIED _____

Gary B Foat

MPL-699

118-2556