PLAT OF SURVEY

LOT S 8919-8929, BLOCK 160, PELL LAKE SUBDIVISION, being a part of the Section 22, Town 1 North, Range 18 East, Town of Bloomfield, Walworth County, Wisconsin.

Survey address: W1198 Blue Bell Drive

Surveyed for: Garth and Susan Dixon

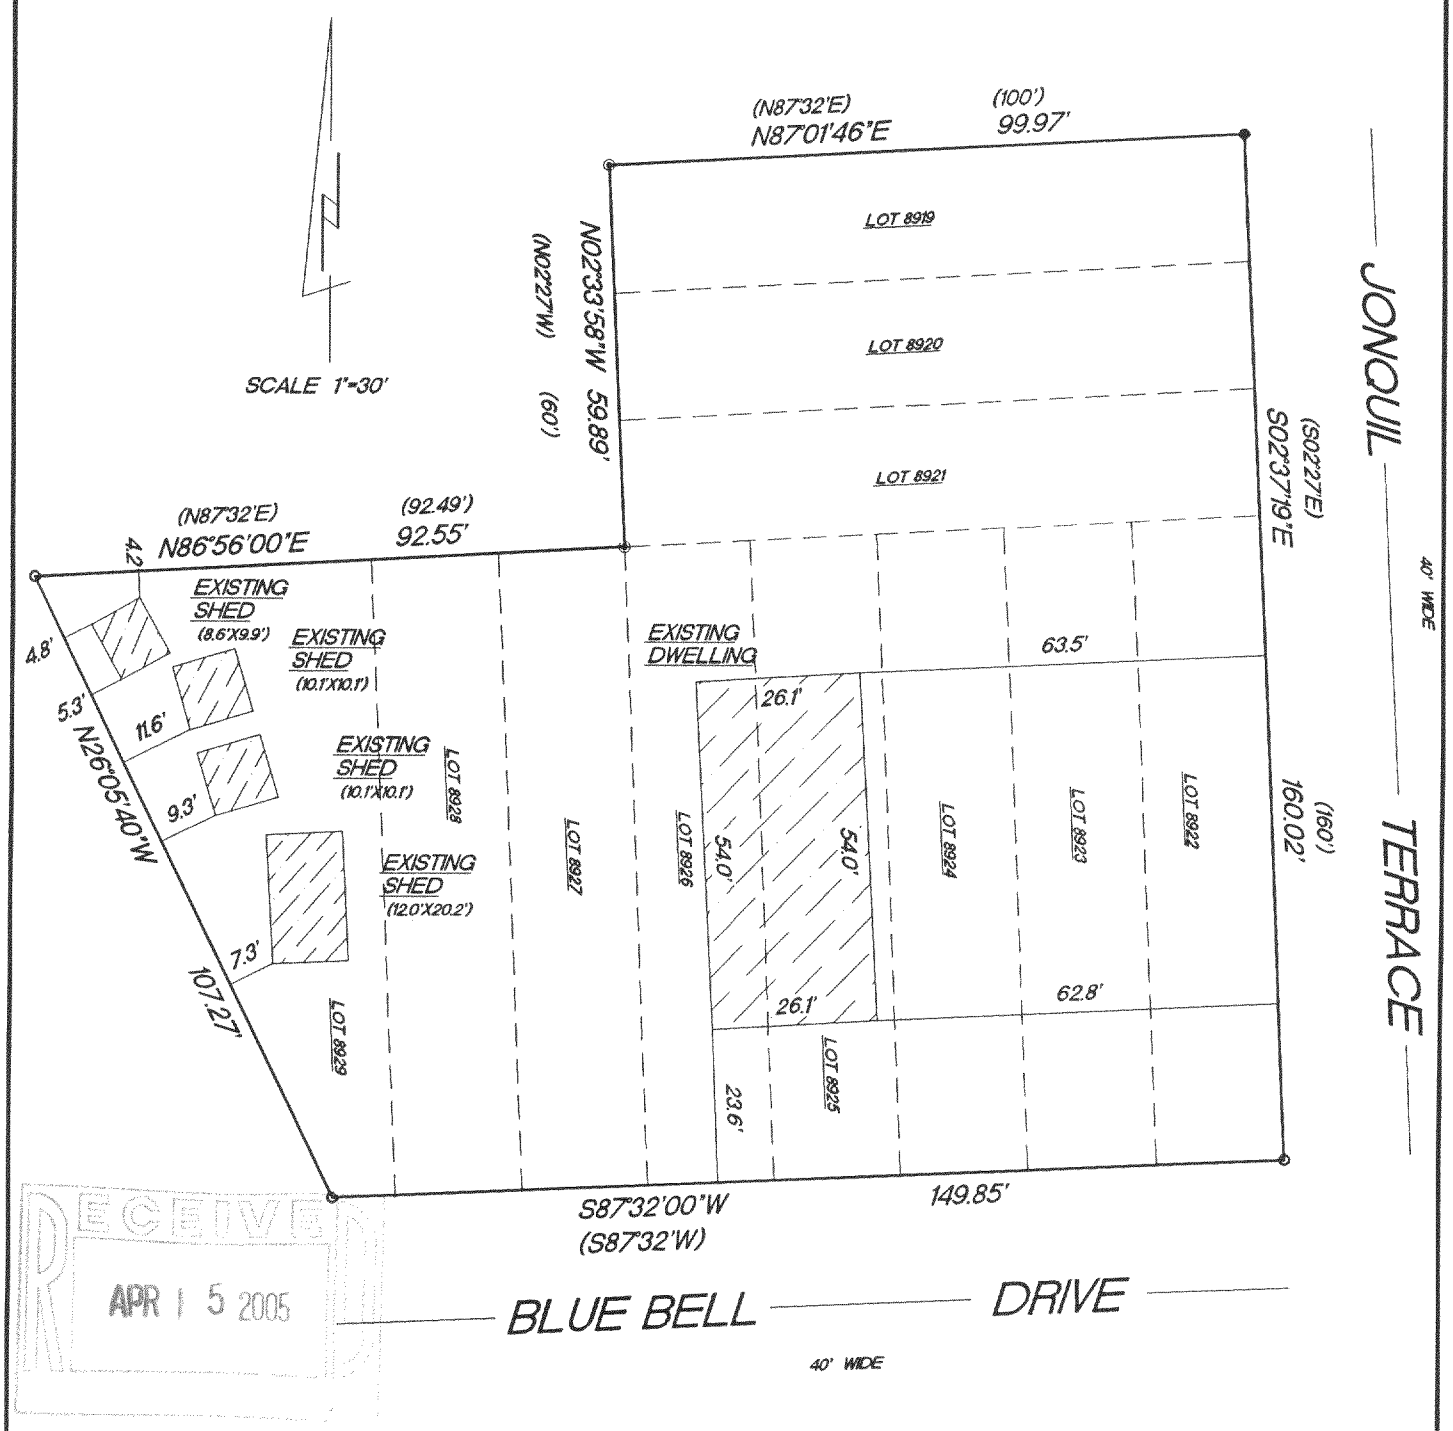

RECEIVED
APR 15 2005

- ● FOUND 2" IRON PIPE
- ◉ FOUND 1 1/2" IRON PIPE
- ○ FOUND 1" IRON PIPE
- ( ) RECORDED AS DIMENSIONS

NOTE: PLAT IS NOT LEDGEBLE ENOUGH TO READ RECORDED AS DIMENSIONS ON CERTAIN LINES.

"I hereby certify that I have surveyed the above described property and that the above map is a true representation thereof and shows the size and location of the property, its exterior boundaries, the location of all visible structures and dimension of all principal buildings thereon, boundary fences, apparent easements, roadways and encroachments if any."

"This survey is made for the use of the present owners of the property, and also those who purchase, mortgage or guarantee the title thereto within one year from date hereof."

KETTLE MORAINE SURVEYING INC.
W356 S9050 Godfrey Lane
Eagle Wisconsin 53119
P.O. Box 357
(262) 594-3484
Terrance E. Pisarek R.L.S.

WISCONSIN TERRANCE E. PISAREK S-1930 EAGLE, WISCONSIN LAND SURVEYOR

THIS IS NOT AN ORIGINAL SURVEY UNLESS THE SEAL IS RED.

12/2/04	TEP/DW	TEP	04215
DATE	FIELD WORK BY	DRAWN BY	JOB NUMBER

MPL-6773

118-2591