


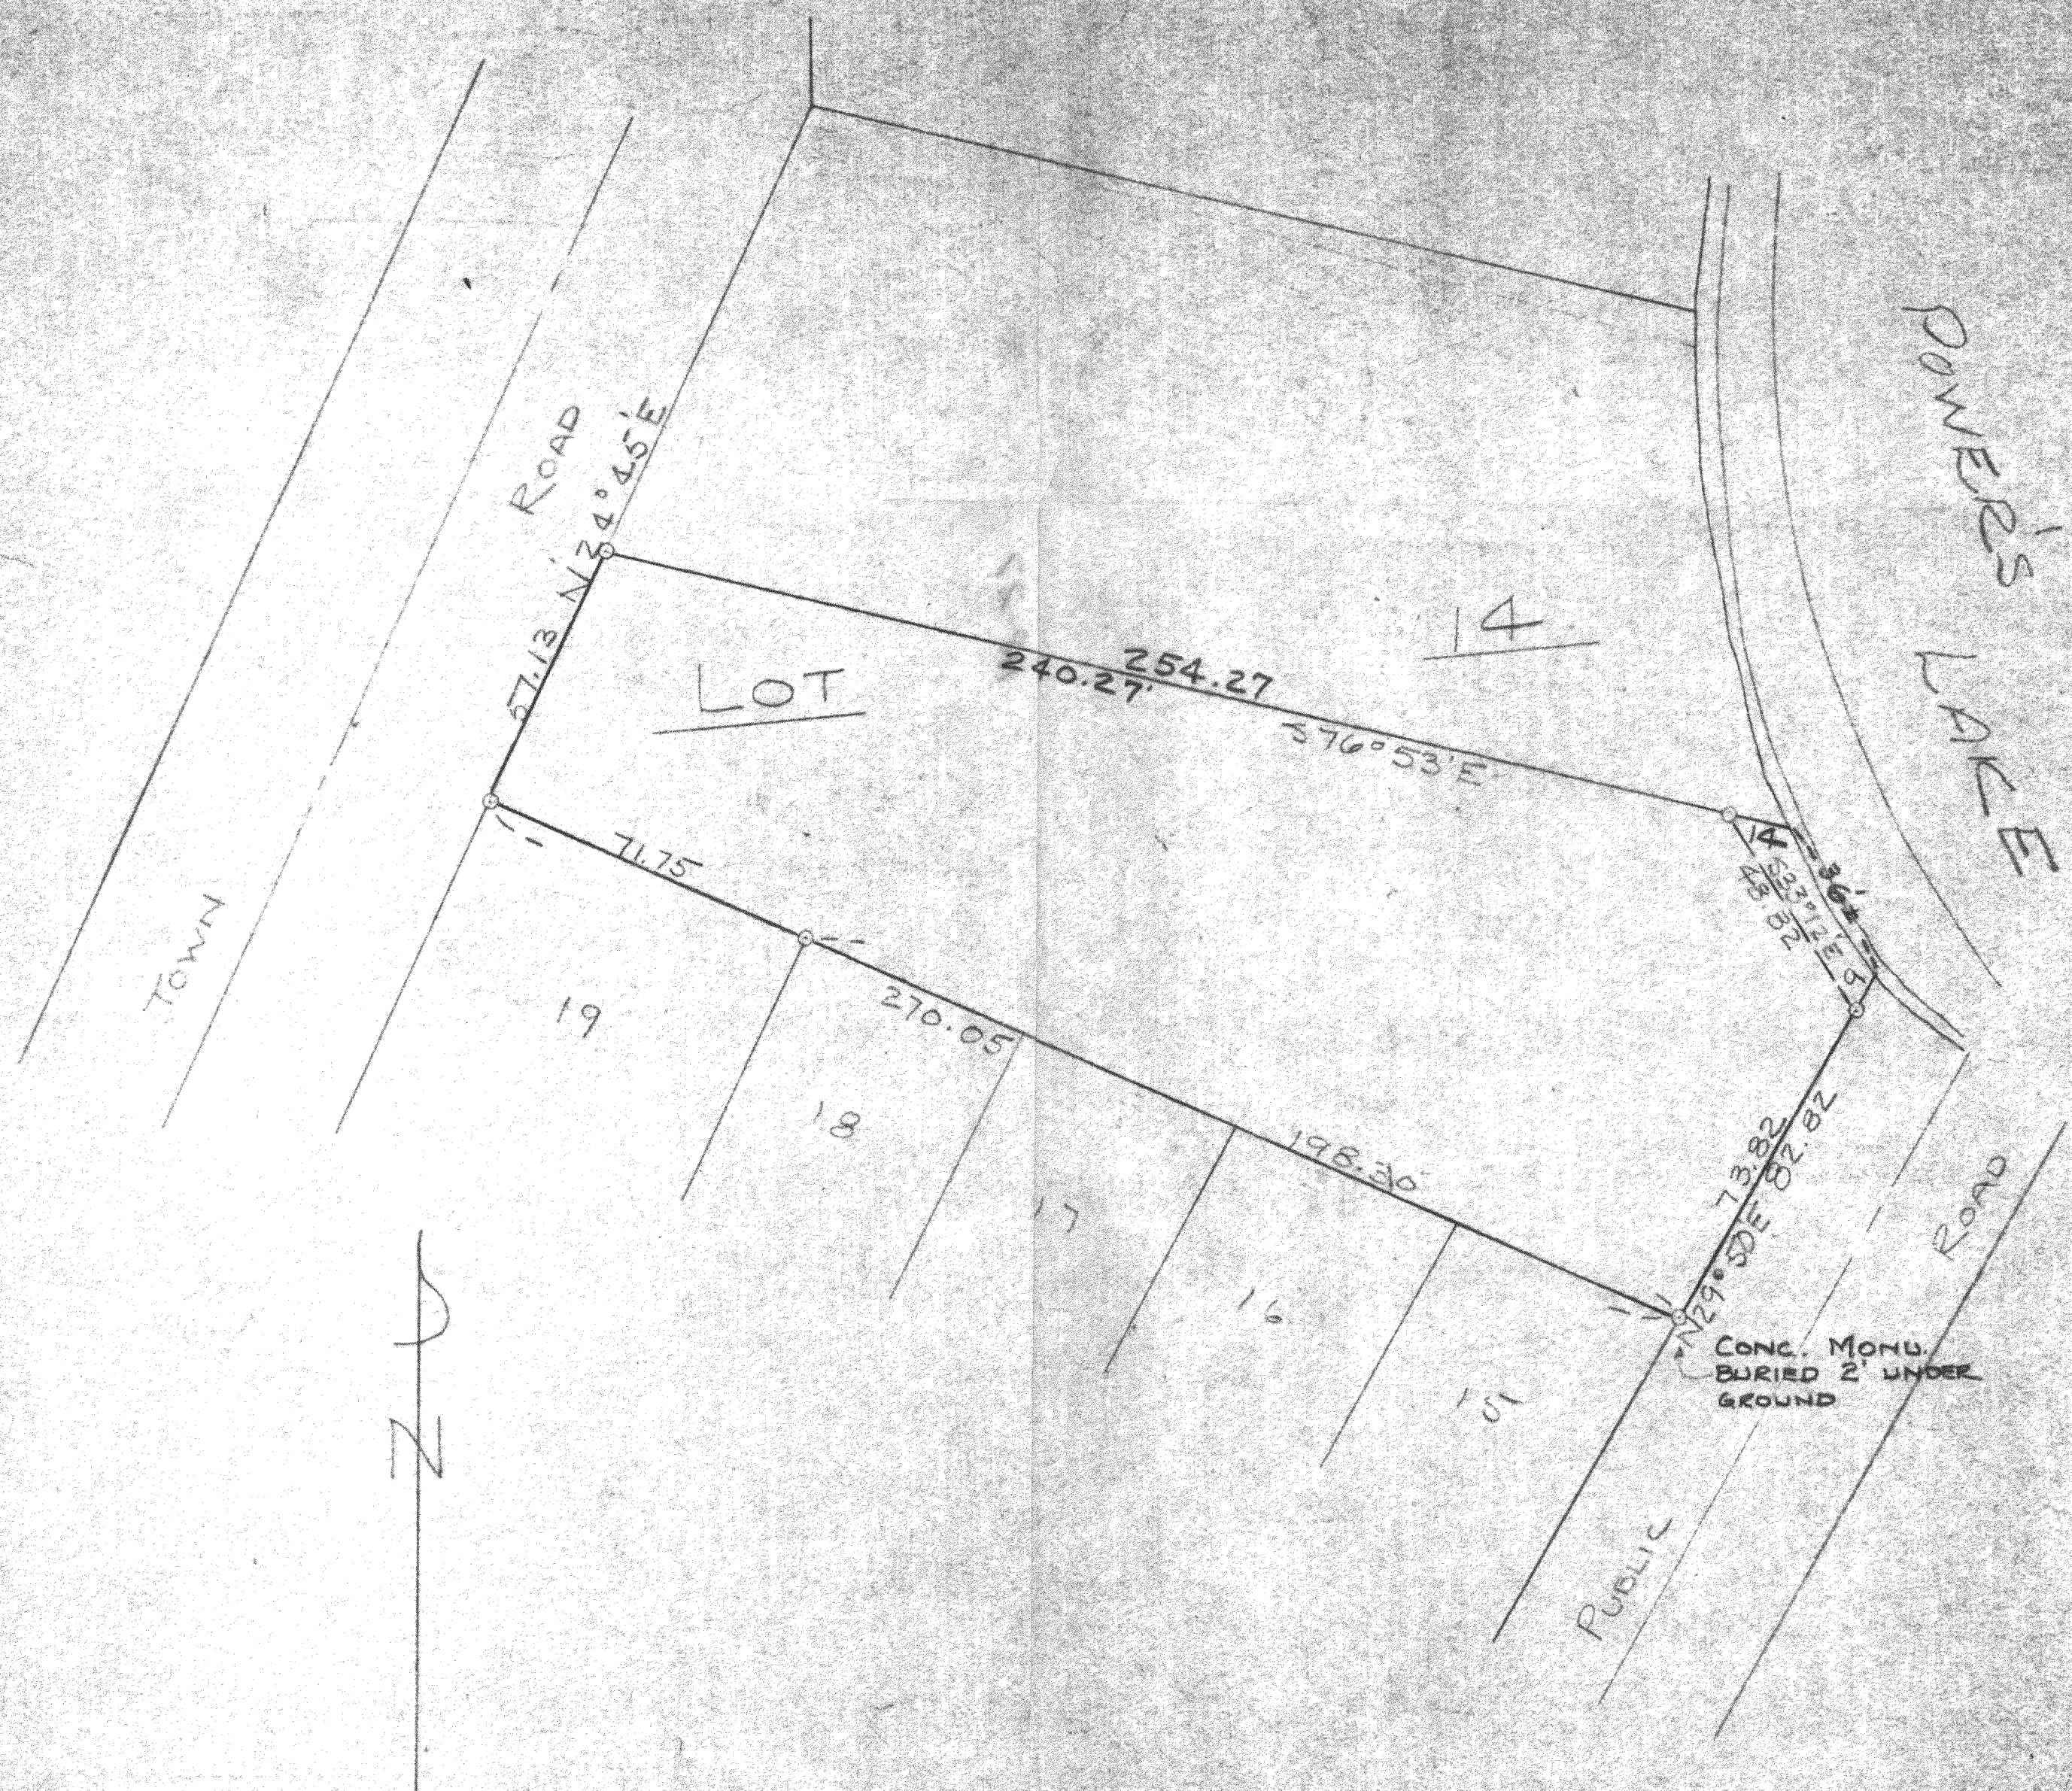

SCALE 1" = 30'
O = IRON PIPE

PLAT OF SURVEY OF PART OF LOT 14
OF WM ELLIOTT'S POWER'S LAKE SUB-
DIVISION LOCATED IN THE NORTHEAST 1/4
OF SECTION 13, T1N R1E, WALWORTH
COUNTY, WISCONSIN.

SEPT. 1950

Lloyd L. Jensen
COUNTY SURVEYOR 118-271

ME - 14A