PLAT OF SURVEY
-OF-

LOTS 3384 THRU 3393, BLOCK 72 OF PELL LAKE SUBDIVISION, ACCORDING TO THE RECORDED PLAT THEREOF. SAID LAND BEING IN THE TOWN OF BLOOMFIELD, COUNTY OF WALWORTH AND STATE OF WISCONSIN.

SURVEY FOR: CECIL MONTEITH

SURVEY ADDRESS: W948 VIOLET DRIVE

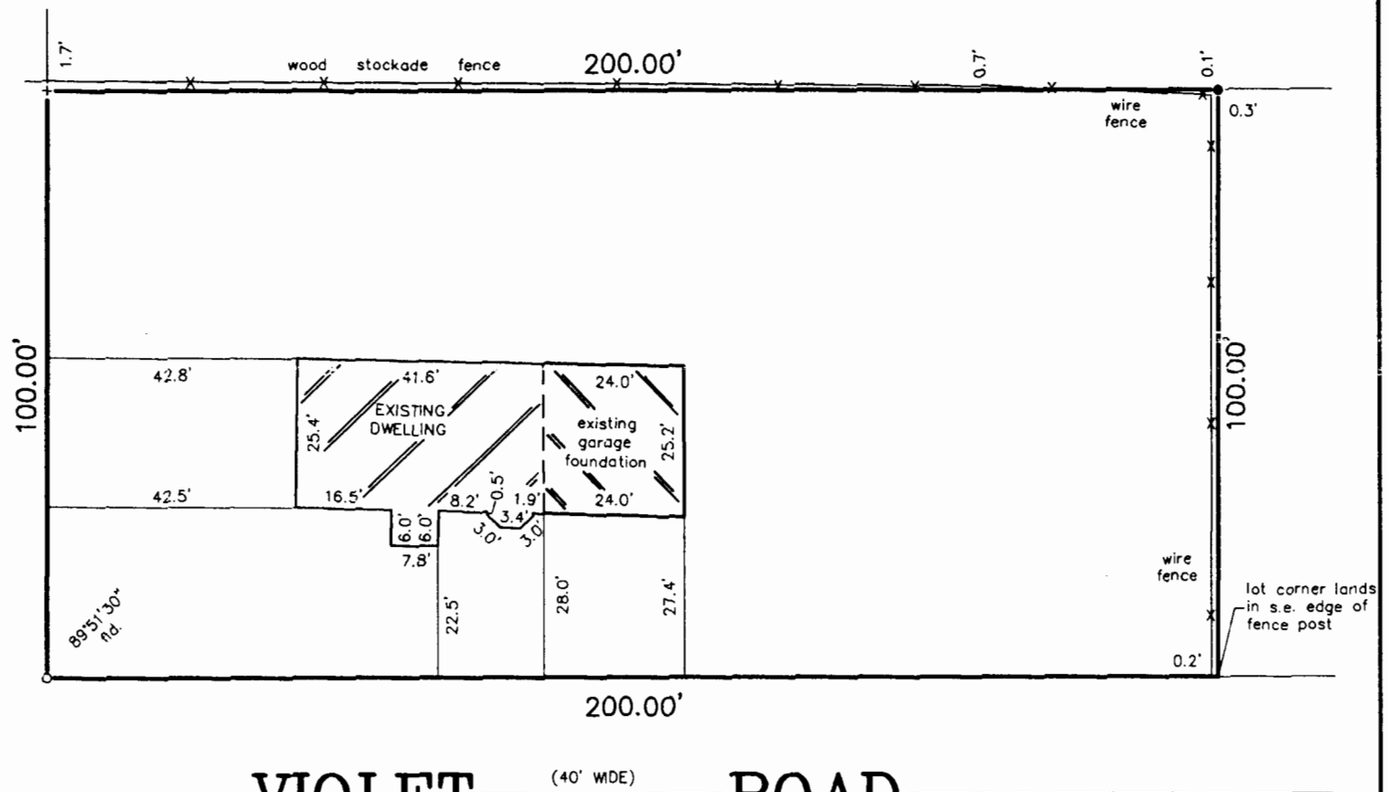

LEGEND

- o FOUND IRON PIPE
- • SET PK NAIL
- \+ SET CHISELED CUT
- 110.0 EXISTING ELEVATION

"I hereby certify that I have surveyed the above described property and that the above map is a correct representation thereof and shows the size and location of the property, its exterior boundaries, the location of all visible structures and dimensions of all principal buildings thereon, boundary fences, apparent easements, roadways and encroachments, if any."

"This survey is made for the use of the present owners of the property, and those who purchase, mortgage, or guarantee the title thereto within one year from date hereof."

SCALE: 1" = 30'

B.W. SURVEYING, INC.

412 N. PINE STREET
BURLINGTON, WI 53105
(262)-767-0225

THIS IS NOT AN ORIGINAL PRINT UNLESS THIS SEAL IS RED.

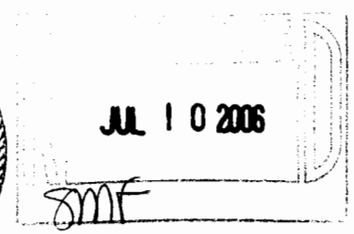

Franklin J. Lehman

FRANKLIN J. LEHMAN S-2211

REVISED: OCTOBER 17, 2005

OCTOBER 12, 2005
DATE

7057
JOB NUMBER

REVISED: DECEMBER 19, 2005

MPZ-704

118-2739