AMBIT LAND SURVEYING
P. O. BOX 42
Bassett, WI. 53101

PLAT OF SURVEY

OF

PHONE 262-537-4874
FAX 262-537-4221

Lot 14, Block 9 of THE SECOND SUBDIVISION OF NIPPERSINK PARK, being a subdivision in the East Half of Section 24, Town 1 North, Range 18 East of the 4th Principal Meridian, Township of Bloomfield, Walworth County, Wisconsin.

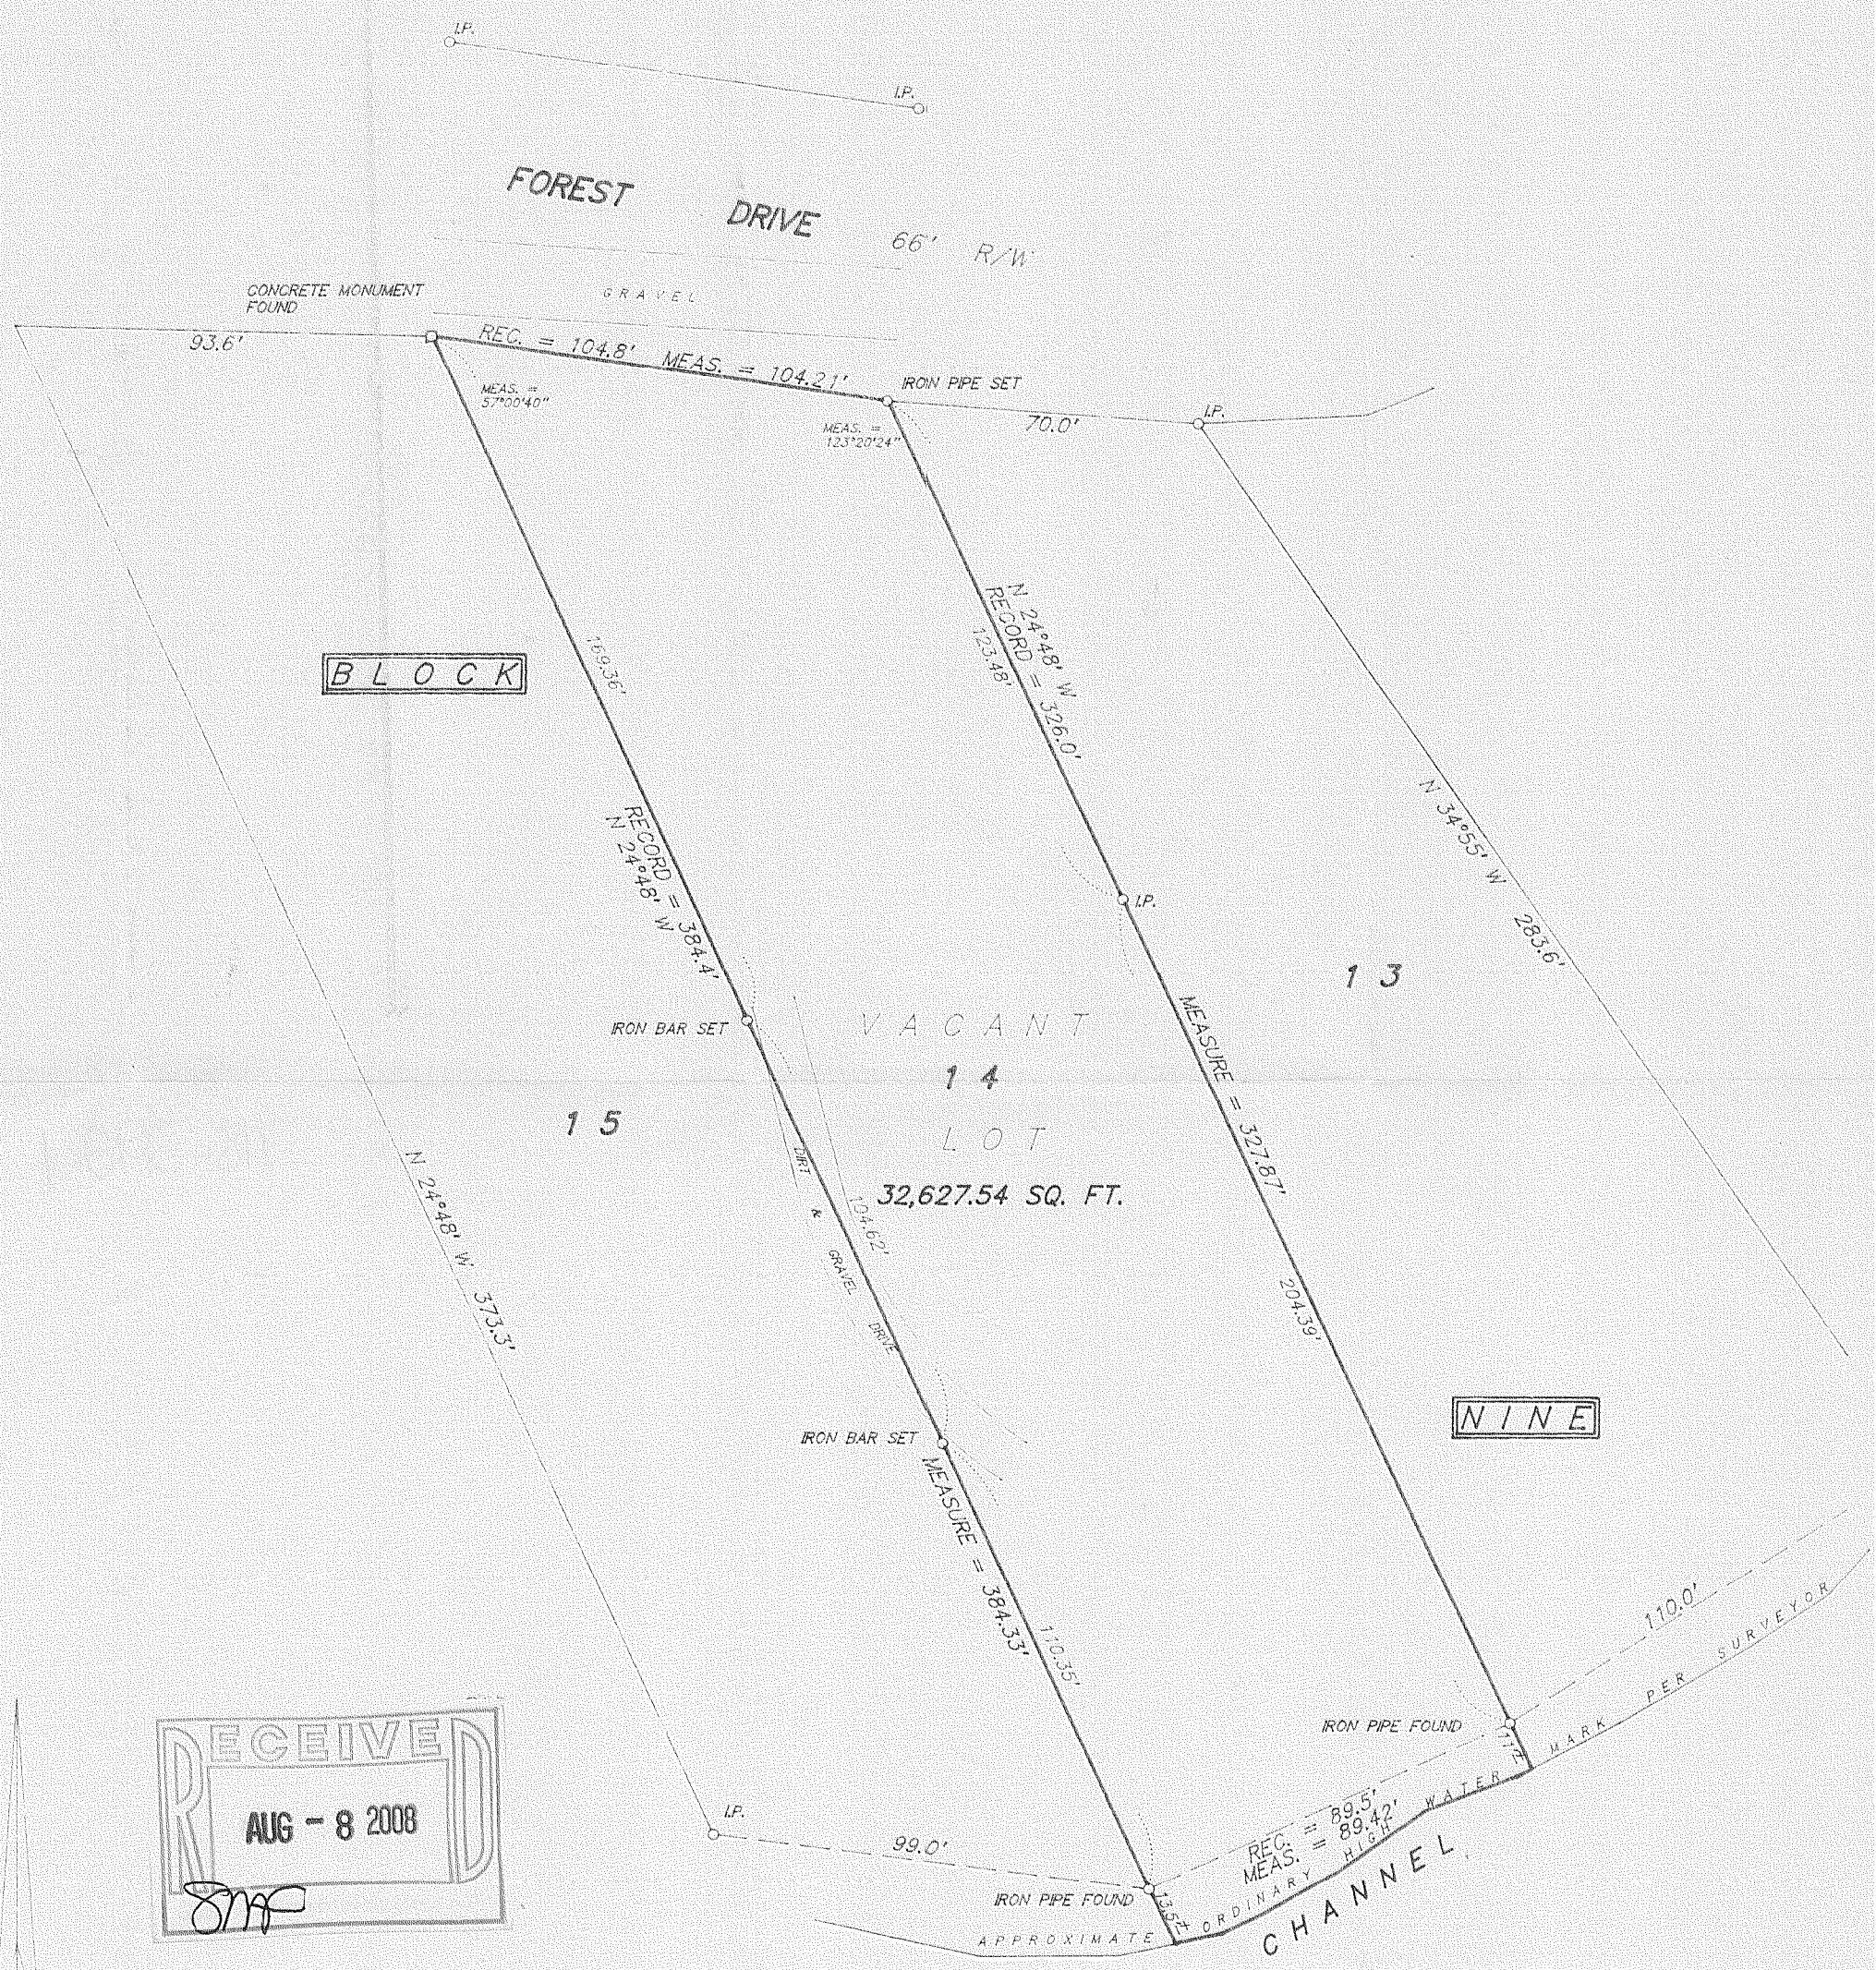

RECEIVED
AUG - 8 2008

N

SCALE 1 inch = 40 feet

ORDERED BY D. Pugh

JOB NO. 9 9 3 8 5

I hereby certify that I have surveyed the above described property and the above plat is a true representation thereof and shows the size and location of the property, its exterior boundaries, the location and dimensions of all visible structures thereon, boundary fences, apparent easements and roadways and visible encroachments, if any.

This survey is made for the exclusive use of the present owners of the property, and also those who purchase, mortgage, or guarantee the title thereto within one year from the date hereof.

Dated at Bassett, Wisconsin this _____ day of _____ 1999.

Mark A. Bolender
Wisconsin Registered Land Surveyor S - 1784

MNPS 2-28

118-2921