PLAT OF SURVEY OF

LOTS 2518, 2519, 2520, 2521, 2522, 2523, 2524 & 2525 IN SECTION 2 OF PELL LAKE SUBDIVISION, LOCATED IN SECTION 22, T. 1 N., R. 18 E. OF THE 4TH P.M., TOWNSHIP OF BLOOMFIELD, COUNTY OF WALWORTH, STATE OF WISCONSIN.

I HEREBY CERTIFY THAT I HAVE SURVEYED THE LAND DESCRIBED ABOVE AND THAT THE PLAT DRAWN HEREON IS A CORRECT REPRESENTATION OF SAID SURVEY. I FURTHER CERTIFY THAT THE BUILDINGS ON SAID LAND ARE LOCATED AS SHOWN ON THIS PLAT.

John F. Degen 4-8-70

JOHN F. DEGEN, LAND SURVEYOR #242
589 N. PINE ST., BURLINGTON, WISCONSIN

WISCONSIN
JOHN F. DEGEN
BURLINGTON, WIS.
REGISTERED SURVEYOR

SCALE 1" EQUALS 30'
O DENOTES STAKE OF TYPE NOTED ON PLAT.
THERE ARE NO ENCROACHMENTS OVER LOT LINES.

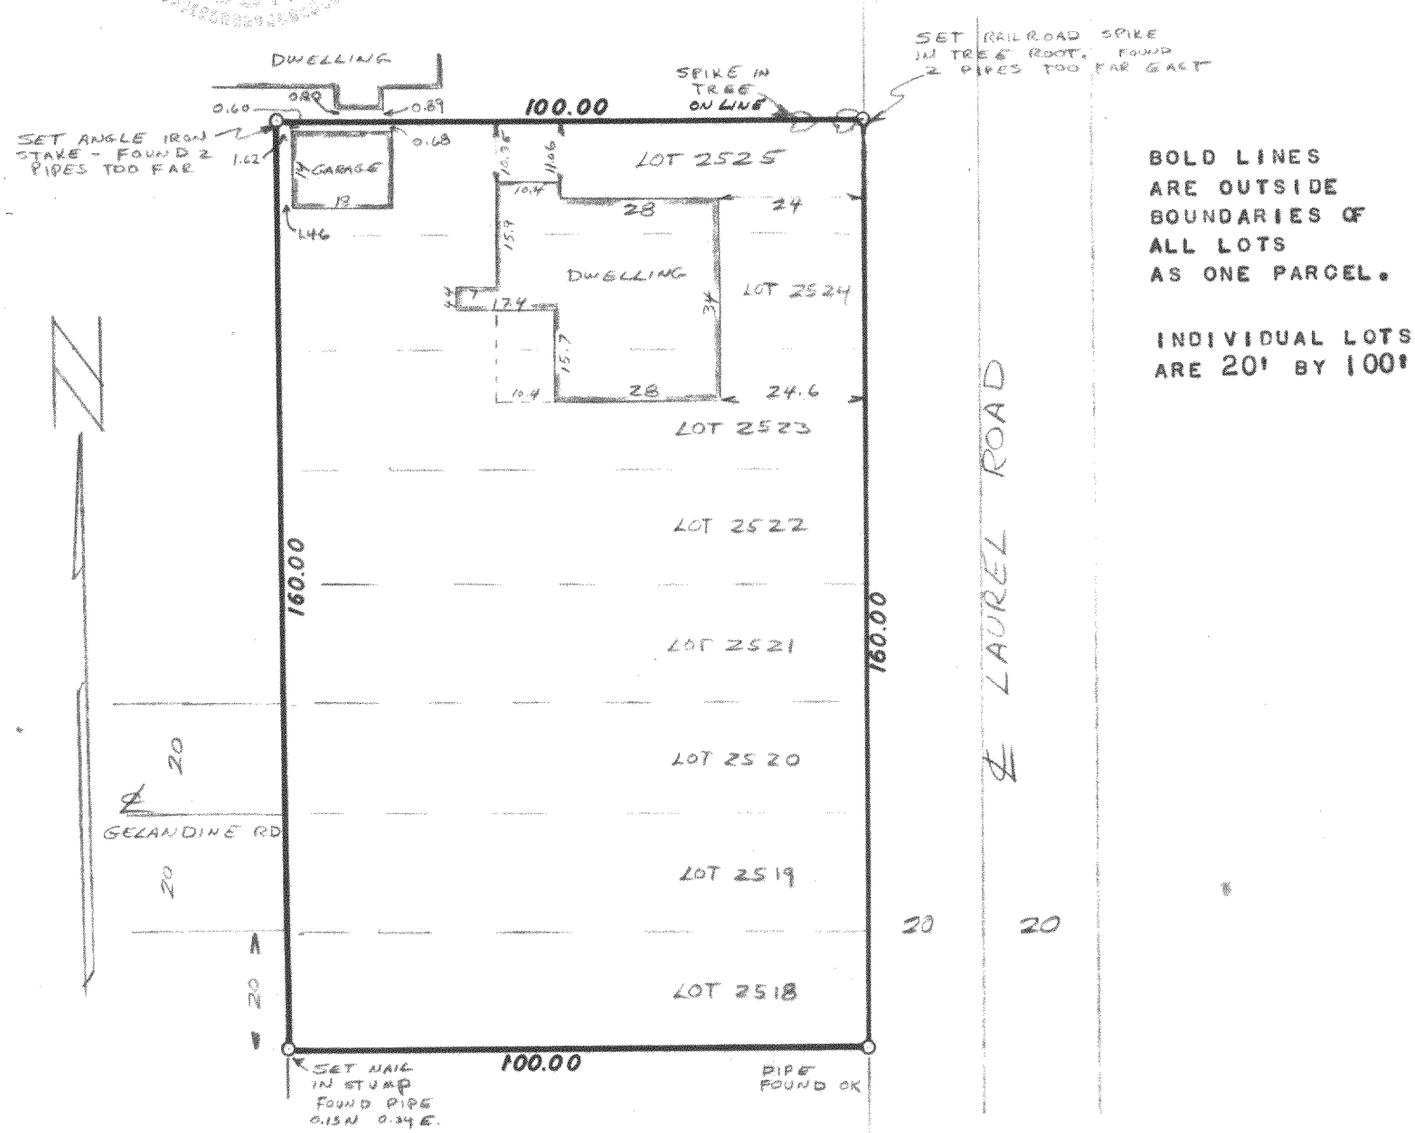

BOLD LINES ARE OUTSIDE BOUNDARIES OF ALL LOTS AS ONE PARCEL.

INDIVIDUAL LOTS ARE 20' BY 100'

118-293
DRAWER 1-D-2 22