PREPARED FOR:
MAIA WILSON
LAKE GENEVA AREA REALTY
101 BROAD ST. SUITE C3
LAKE GENEVA, WI 53147

PATHFINDER SURVEYING, INC.
W2888 KRUEGER ROAD UNIT "D"
LAKE GENEVA, WI 53147
(262) 248-8303

PLAT OF SURVEY

- OF -

LOTS 1928, 1929, 1930, 1931, 1932, 1933, AND 1934, BLOCK 60, OF SECTION 2 OF PELL LAKE SUBDIVISION, BEING A PART OF SECTION 22, TOWN 1 NORTH, RANGE 18 EAST, TOWN OF BLOOMFIELD, WALWORTH COUNTY, WISCONSIN.

RECEIVED
JUN - 9 2009
By

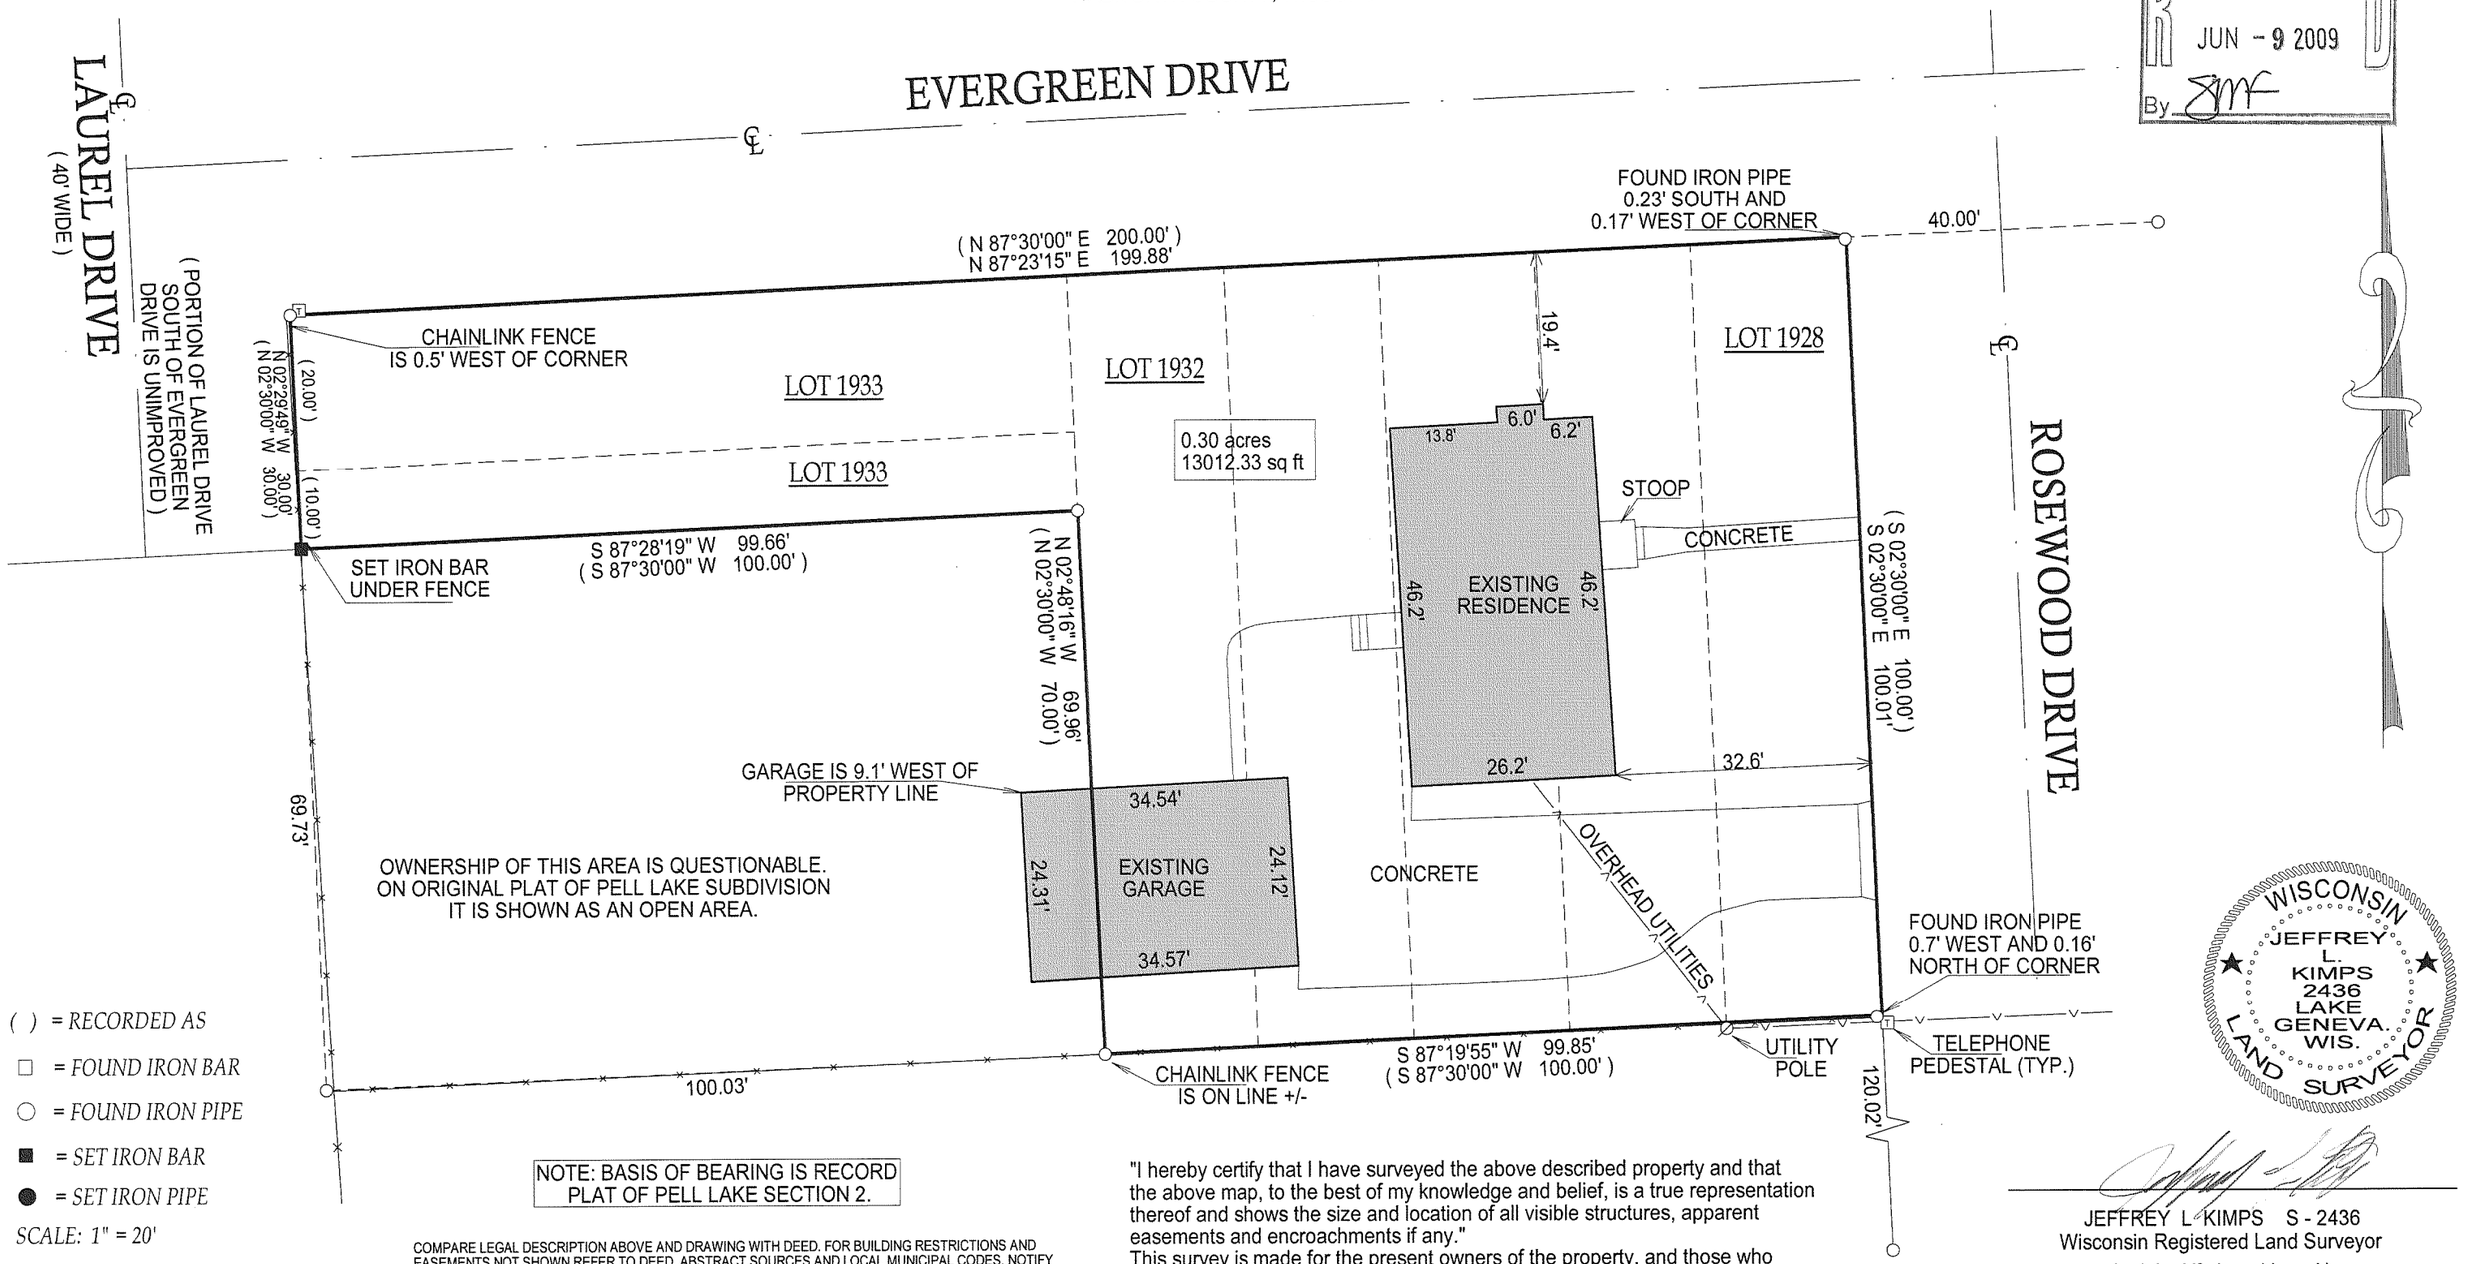

( ) = RECORDED AS
□ = FOUND IRON BAR
○ = FOUND IRON PIPE
■ = SET IRON BAR
● = SET IRON PIPE
SCALE: 1" = 20'
JOB #: 09-023
TAX ID #: MPL 00419

NOTE: BASIS OF BEARING IS RECORD PLAT OF PELL LAKE SECTION 2.

COMPARE LEGAL DESCRIPTION ABOVE AND DRAWING WITH DEED. FOR BUILDING RESTRICTIONS AND EASEMENTS NOT SHOWN,REFER TO DEED. ABSTRACT SOURCES AND LOCAL MUNICIPAL CODES. NOTIFY THE SURVEYOR IMMEDIATELY OF ANY DISCREPANCY.

"I hereby certify that I have surveyed the above described property and that the above map, to the best of my knowledge and belief, is a true representation thereof and shows the size and location of all visible structures, apparent easements and encroachments if any."
This survey is made for the present owners of the property, and those who purchase, mortgage, or guarantee the title thereto, within one year from the date hereof.

WISCONSIN
JEFFREY L. KIMPS 2436 LAKE GENEVA. WIS.
LAND SURVEYOR

JEFFREY L. KIMPS S - 2436
Wisconsin Registered Land Surveyor
(original if signed in red)
DATED THIS 218th, DAY OF APRIL, 2009.

118-2975