PREPARED FOR
MICHELLE KAVANAGH
CENTURY 21 HERGET & PLAVSIC
421 BROAD ST.
LAKE GENEVA WI. 53147

PLAT OF SURVEY

-OF-

LOTS 7303 THRU 7306 BLOCK 114 OF SECTION "A" OF PELL LAKE SUBDIVISION, LOCATED IN SECTIONS 16 AND 21, TOWN 1 NORTH, RANGE 18 EAST, WALWORTH COUNTY, WISCONSIN.

KROTT SURVEYING INC.
N3705 WILLOW BEND LANE
LAKE GENEVA WI. 53147
PHONE # (262)248-3697
FAX # (262)249-0639

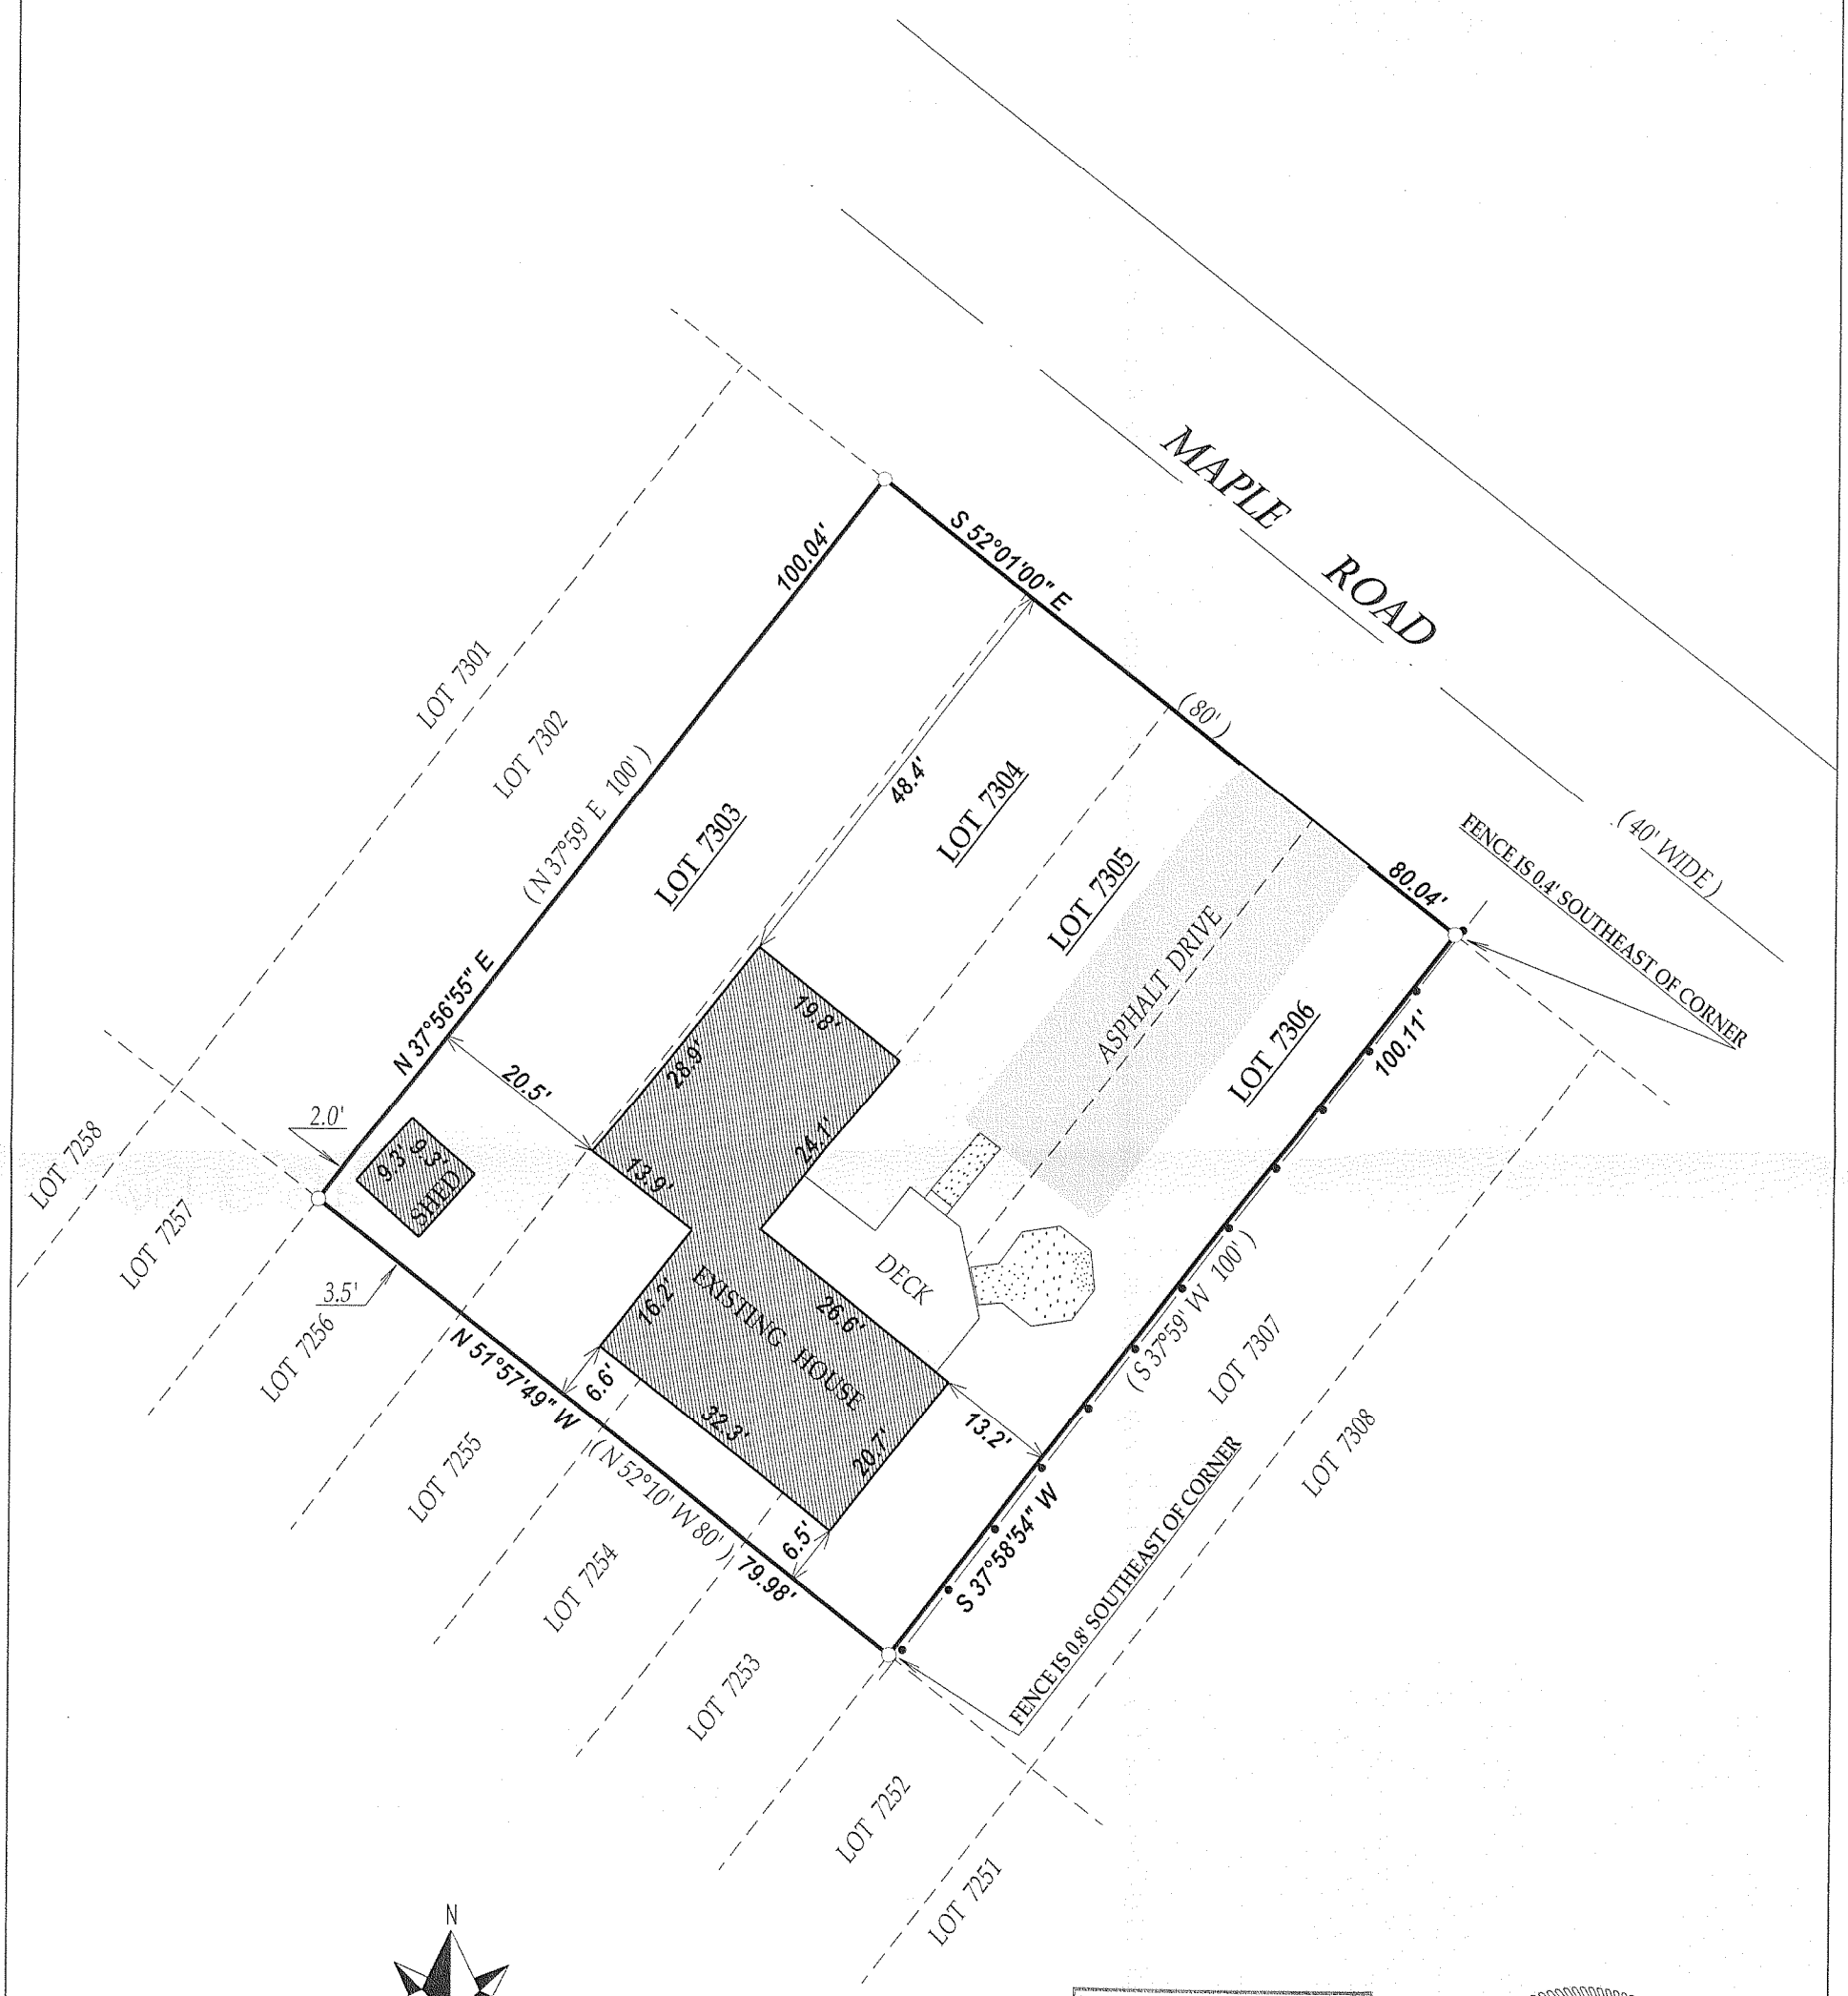

RECEIVED
NOV 10 2009
By

WISCONSIN
JOHN P.
KROTT
S-2258
LAKE GENEVA
WIS.
LAND SURVEYOR

LEGEND

- ○ FOUND IRON PIPE
- CONCRETE
- (XX) RECORDED AS

TAX ID # MPL01556

JOB # 09-118

I have surveyed the above-described property and the above map is a true representation thereof and shows the size and location of the property, its exterior boundaries, the location and dimensions of all structures thereon, fences apparent easements and roadways and visible encroachments. if any.

This survey is made for the exclusive use of the present owners of the property, and also those who puchase, mortgage,or insure the title therto within one (1) year from date hereof; and as to them I warrant the accuracy of said survey map.

JOHN KROTT S - 2258
Wisconsin Registered Land Surveyor
(original if signed in red)

DATED THIS 26th DAY OF AUGUST 2009.

118-29860