PREPARED FOR:
JUAN SERRANO
N1425 DAISY DR.
GENOA CITY , WI 53128

PLAT OF SURVEY

- OF -

LOTS 3709 THRU 3713 BLOCK 77 PELL LAKE SECTION 3
A SUBDIVISION LOCATED IN T. 1.N. , R.18.E. , WALWORTH COUNTY, WISCONSIN.

KROTT SURVEYING INC.
N3705 WILLOW BEND LANE
LAKE GENEVA WI. 53147
PHONE # (262)248-3697
FAX # (262)249-0639

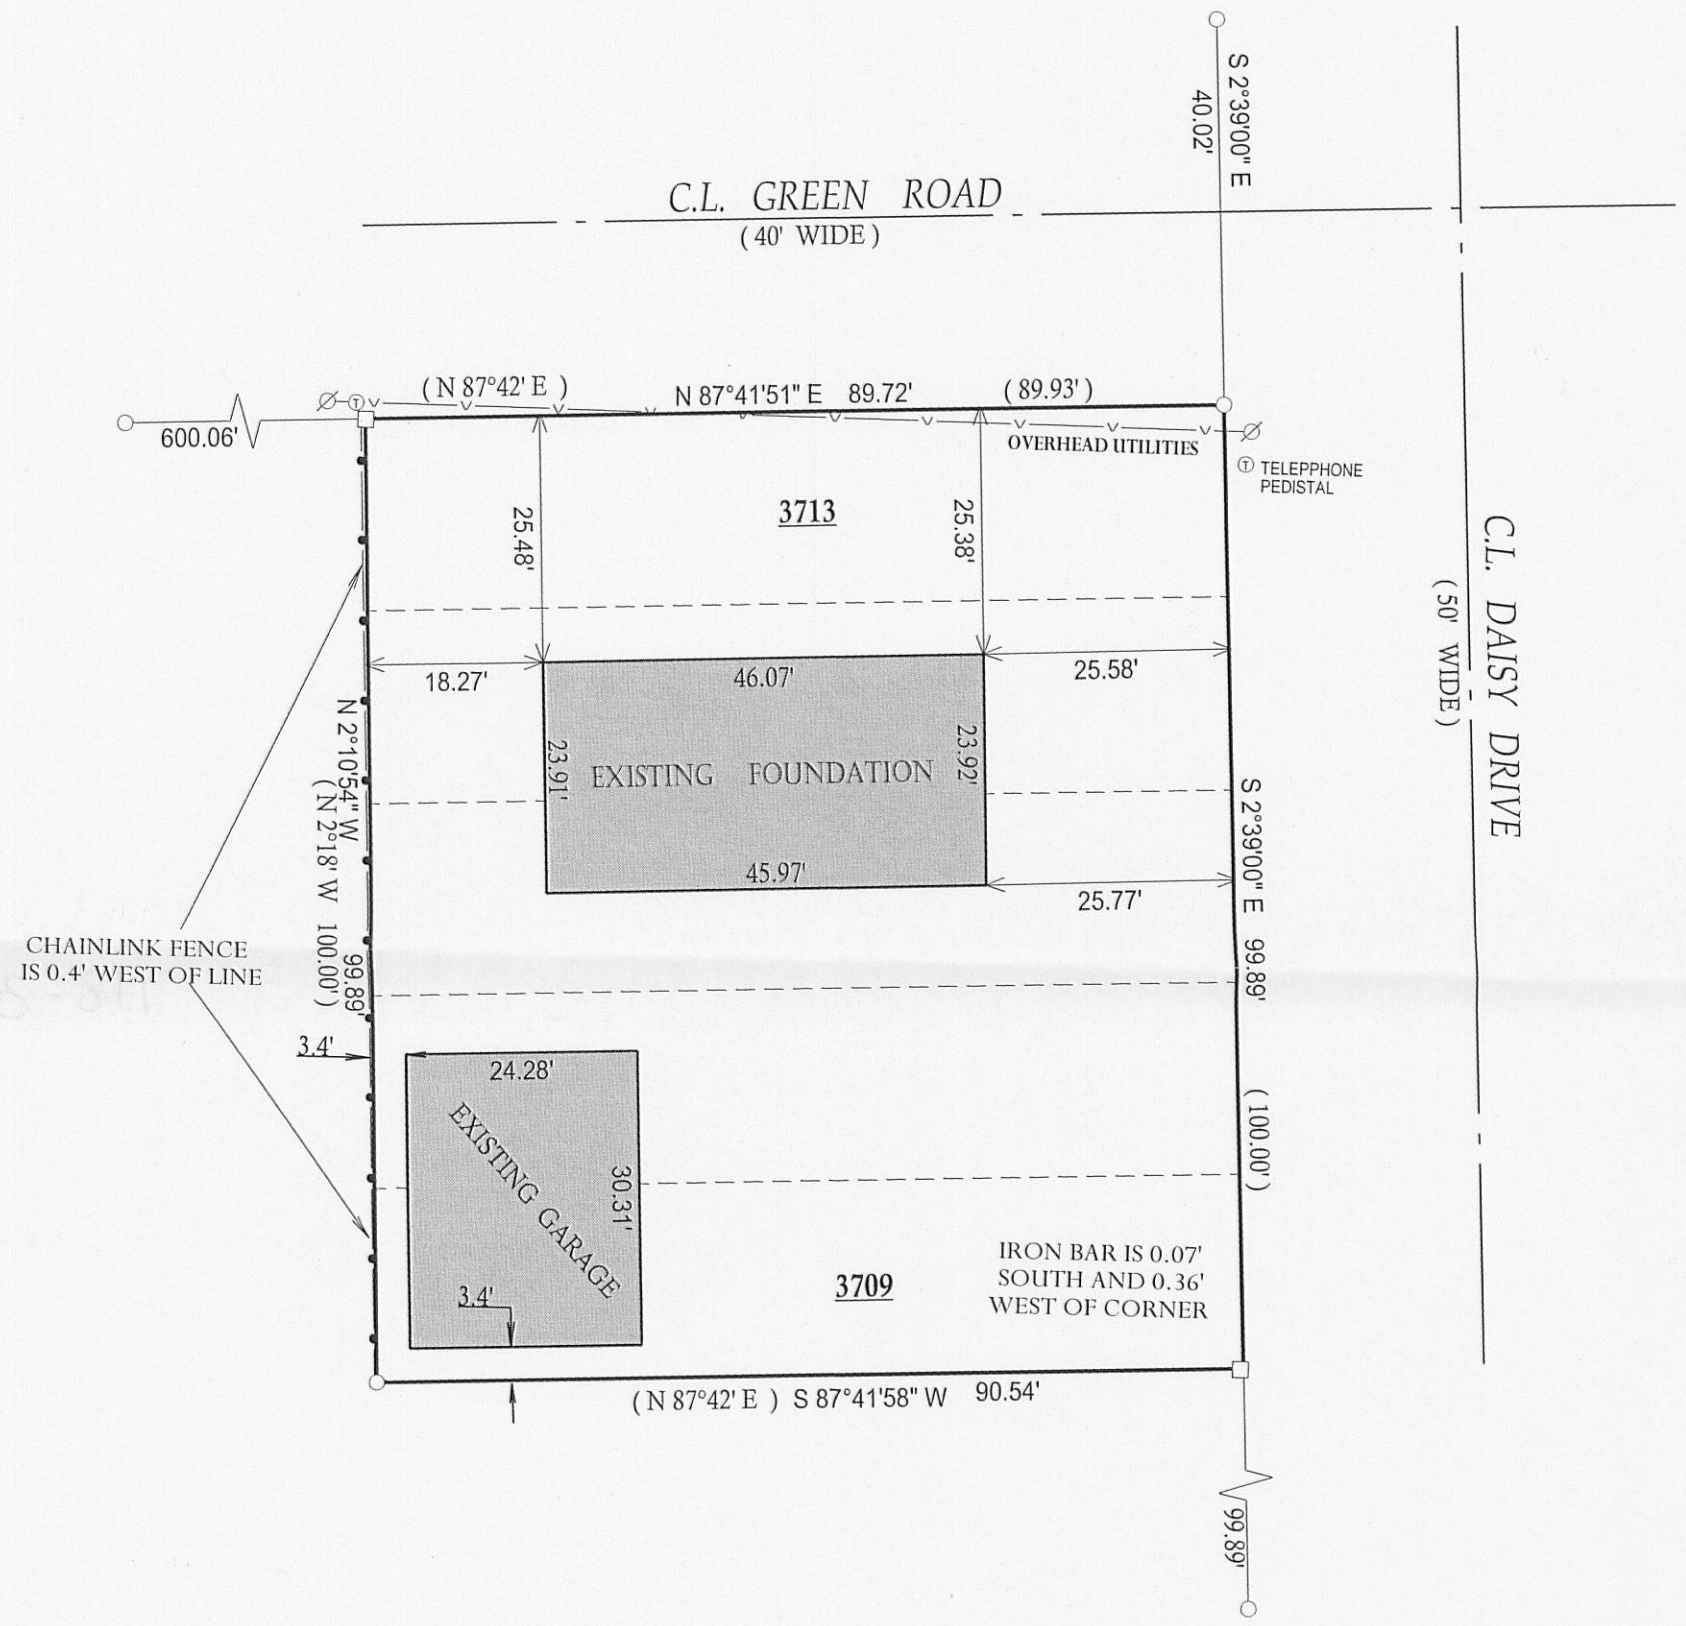

( )= recorded as
□ = found iron bar
○ = found iron pipe
● = set iron pipe
■ = set iron bar

SCALE 1" = 20'

JOB # 07-147ABHSE

TAX ID # MPL 00776

I have surveyed the above-described property and the above map is a true representation thereof and shows the size and location of the property, its exterior boundaries, the location and dimensions of all structures thereon, fences apparent easements and roadways and visible encroachments. if any.

This survey is made for the exclusive use of the present owners of the property, and also those who puchase, mortgage,or insure the title therto within one (1) year from date hereof; and as to them I warrant the accuracy of said survey map.

RECEIVED
APR 08 2010
By

WISCONSIN
JOHN P.
KROTT
S-2258
LAKE GENEVA
WIS.
LAND SURVEYOR

DATE OF LAST REVISION: 3 / 26 / 2010

JOHN KROTT S - 2258
Wisconsin Registered Land Surveyor
(original if signed in red)

DATED THIS 19th DAY OF MAY 2009.

18-3005