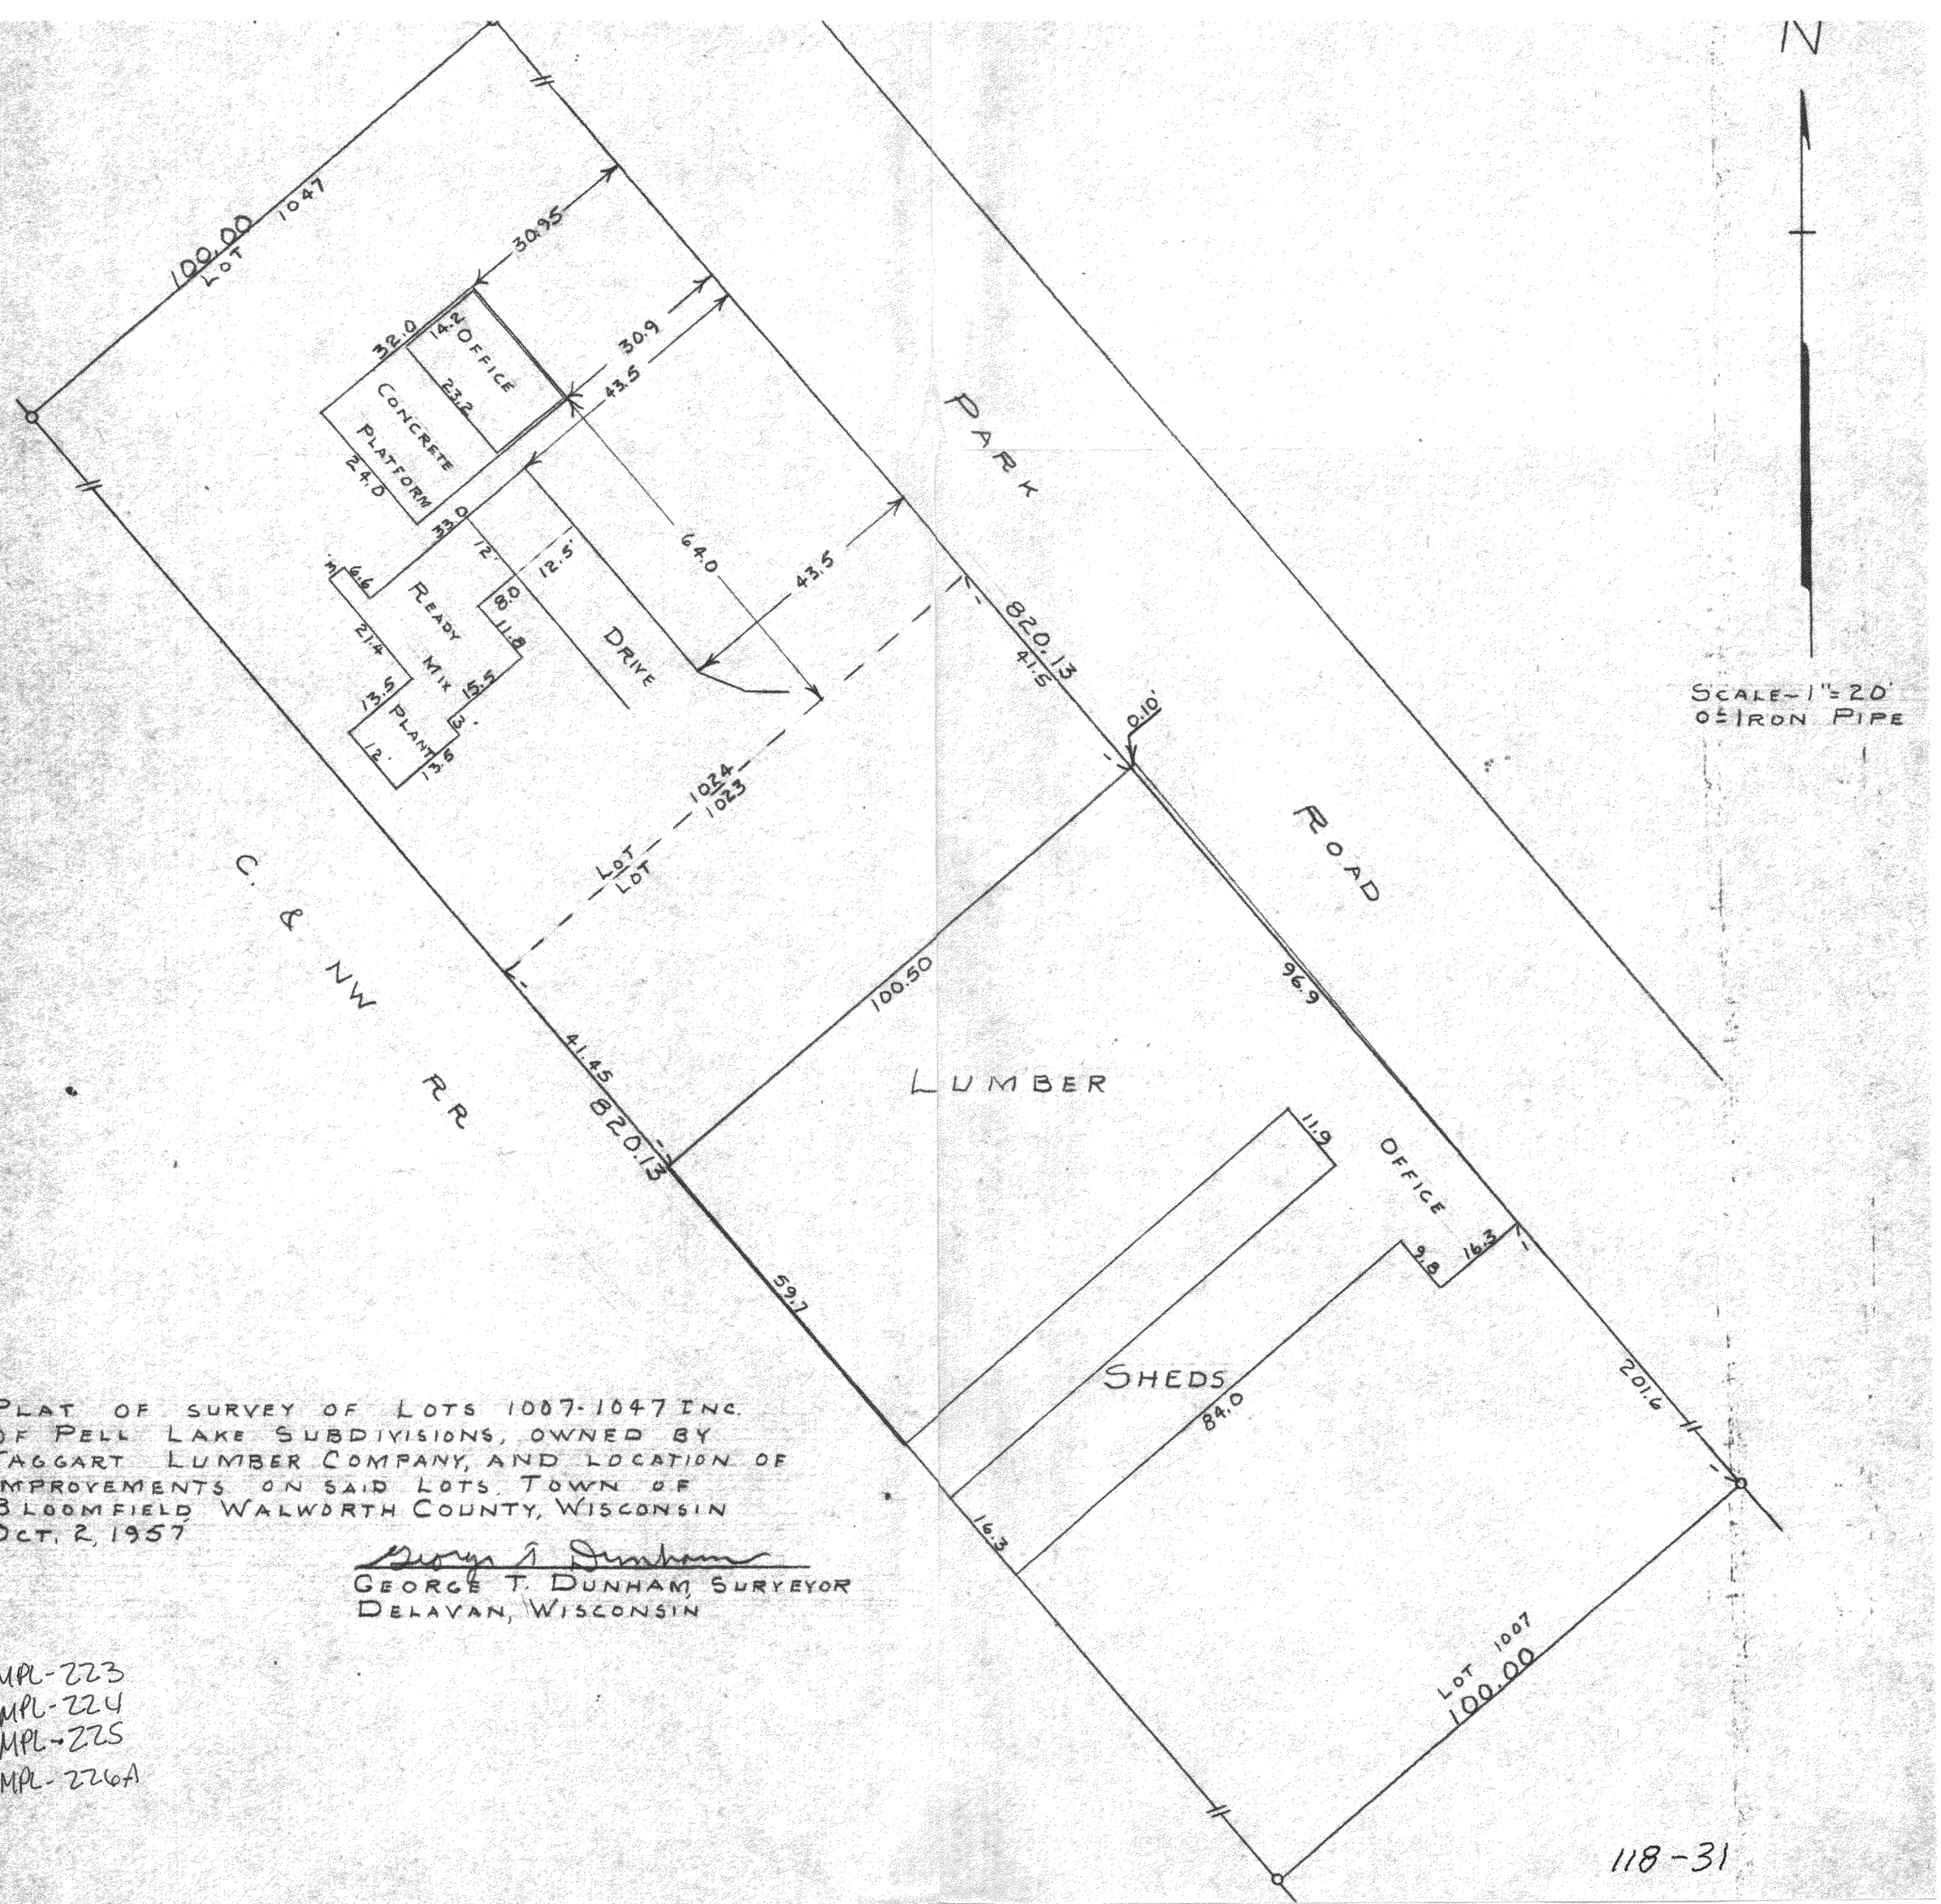


PLAT OF SURVEY OF LOTS 1007-1047 INC. OF PELL LAKE SUBDIVISIONS, OWNED BY TAGGART LUMBER COMPANY, AND LOCATION OF IMPROVEMENTS ON SAID LOTS. TOWN OF BLOOMFIELD WALWORTH COUNTY, WISCONSIN
OCT. 2, 1957

George T. Dunham

GEORGE T. DUNHAM, SURVEYOR
DELAVAN, WISCONSIN

MPL-223
MPL-224
MPL-225
MPL-226A

118-31