PREPARED FOR
ROBIN WALTON-PRIBBLE
PO. BOX 234
DELAVAN WI. 53115

PLAT OF SURVEY

-OF-

THE WEST 1/2 OF LOT 5864 AND LOTS 5865 THRU 5867
BLOCK 132 OF PELL LAKE SUBDIVISION, TOWN 1 NORTH,
RANGE 18 EAST, WALWORTH COUNTY, WISCONSIN.

KROTT SURVEYING INC.
N3705 WILLOW BEND LANE
LAKE GENEVA WI. 53147
PHONE # (262)248-3697
FAX # (262)249-0639

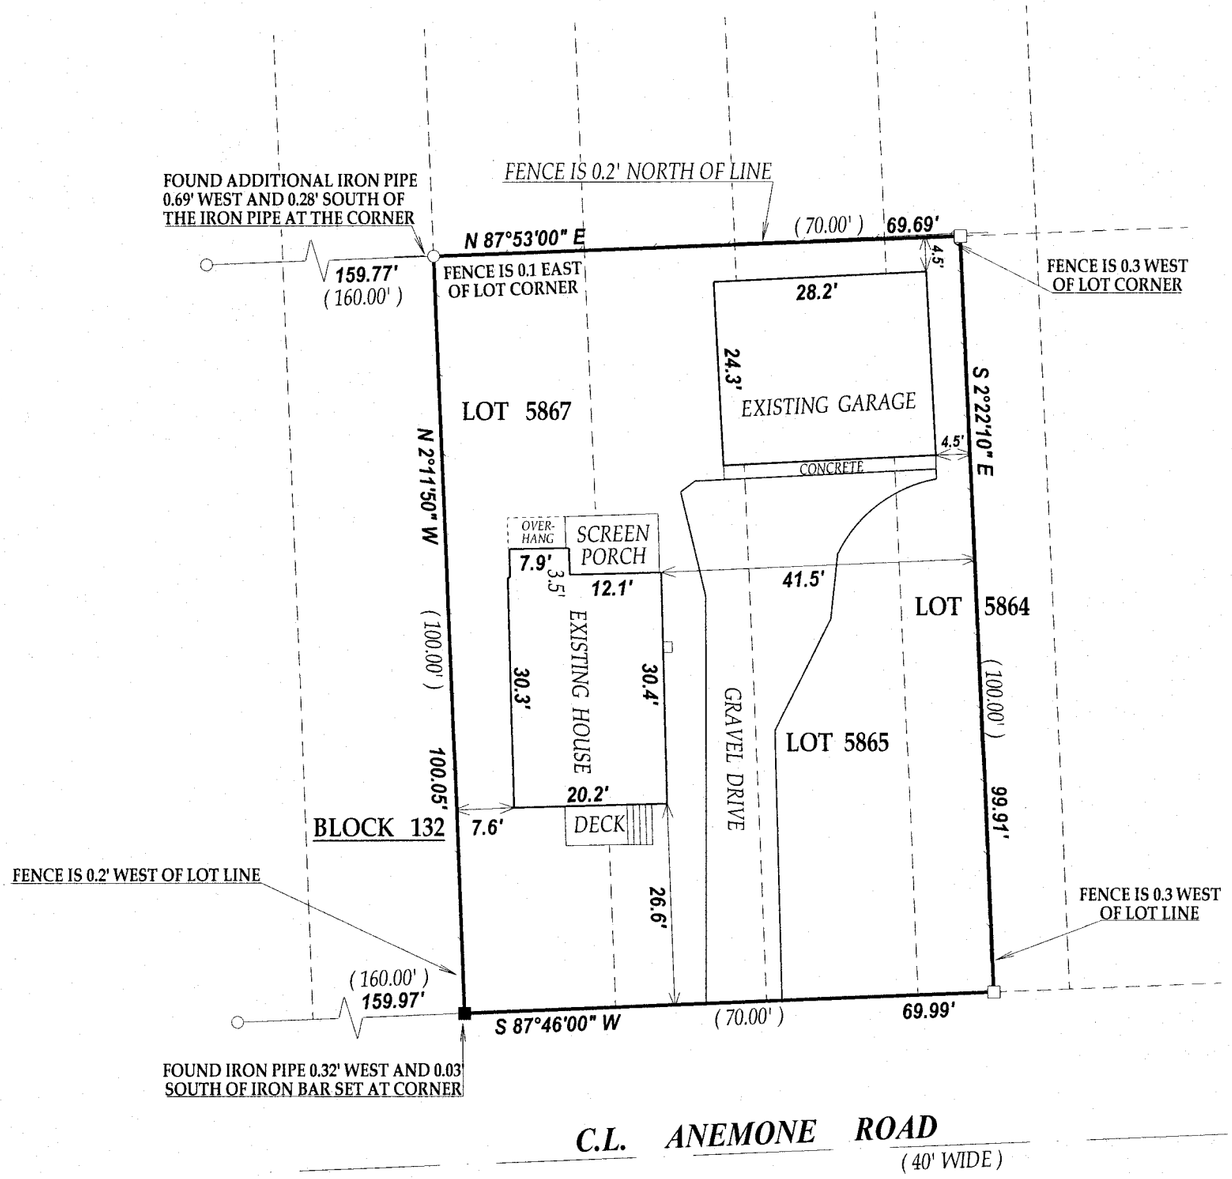

C.L. ANEMONE ROAD
(40' WIDE)

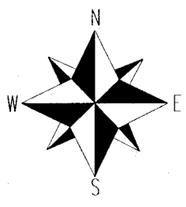

SCALE 1" = 20'

0 20 40 60

RECEIVED
JAN 21 2014
By

WISCONSIN
JOHN P.
KROTT
S-2258
LAKE GENEVA
WIS.
LAND SURVEYOR

LEGEND

- ○ FOUND IRON PIPE
- □ FOUND IRON BAR
- ■ SET IRON BAR
- (XX) RECORDED AS

TAX ID # MPL01273

JOB # 09-116UD2013

I have surveyed the above-described property and the above map is a true representation thereof and shows the size and location of the property, its exterior boundaries, the location and dimensions of all structures thereon, fences apparent easements and roadways and visible encroachments. if any.

This survey is made for the exclusive use of the present owners of the property, and also those who puchase, mortgage,or insure the title therto within one (1) year from date hereof; and as to them I warrant the accuracy of said survey map.

DATED THIS 24th DAY OF AUGUST 2009.
DATE OF LAST REVISION 10/16/2013

JOHN KROTT S - 2258
Wisconsin Registered Land Surveyor
(original if signed in red)

8PL -1273 118-3162