


PLAT OF SURVEY
-OF-

LOT 23 OF THE FIRST ADDITION TO LAKE GENEVA AIRE ESTATES, A SUBDIVISION LOCATED IN THE SOUTHEAST 1/4 OF SECTION 4 AND THE NORTHWEST 1/4 OF THE SOUTHWEST 1/4 OF SECTION 3, TOWN 1 NORTH, RANGE 18 EAST OF THE FOURTH PRINCIPAL MERIDIAN, IN THE VILLAGE OF BLOOMFIELD, WALWORTH COUNTY, WISCONSIN.



SURVEY FOR: BOB WISDOM OF RE/MAX GENEVA REALTY
SURVEY ADDRESS: N2257 PATRICK PLACE, LAKE GENEVA, WI 53147

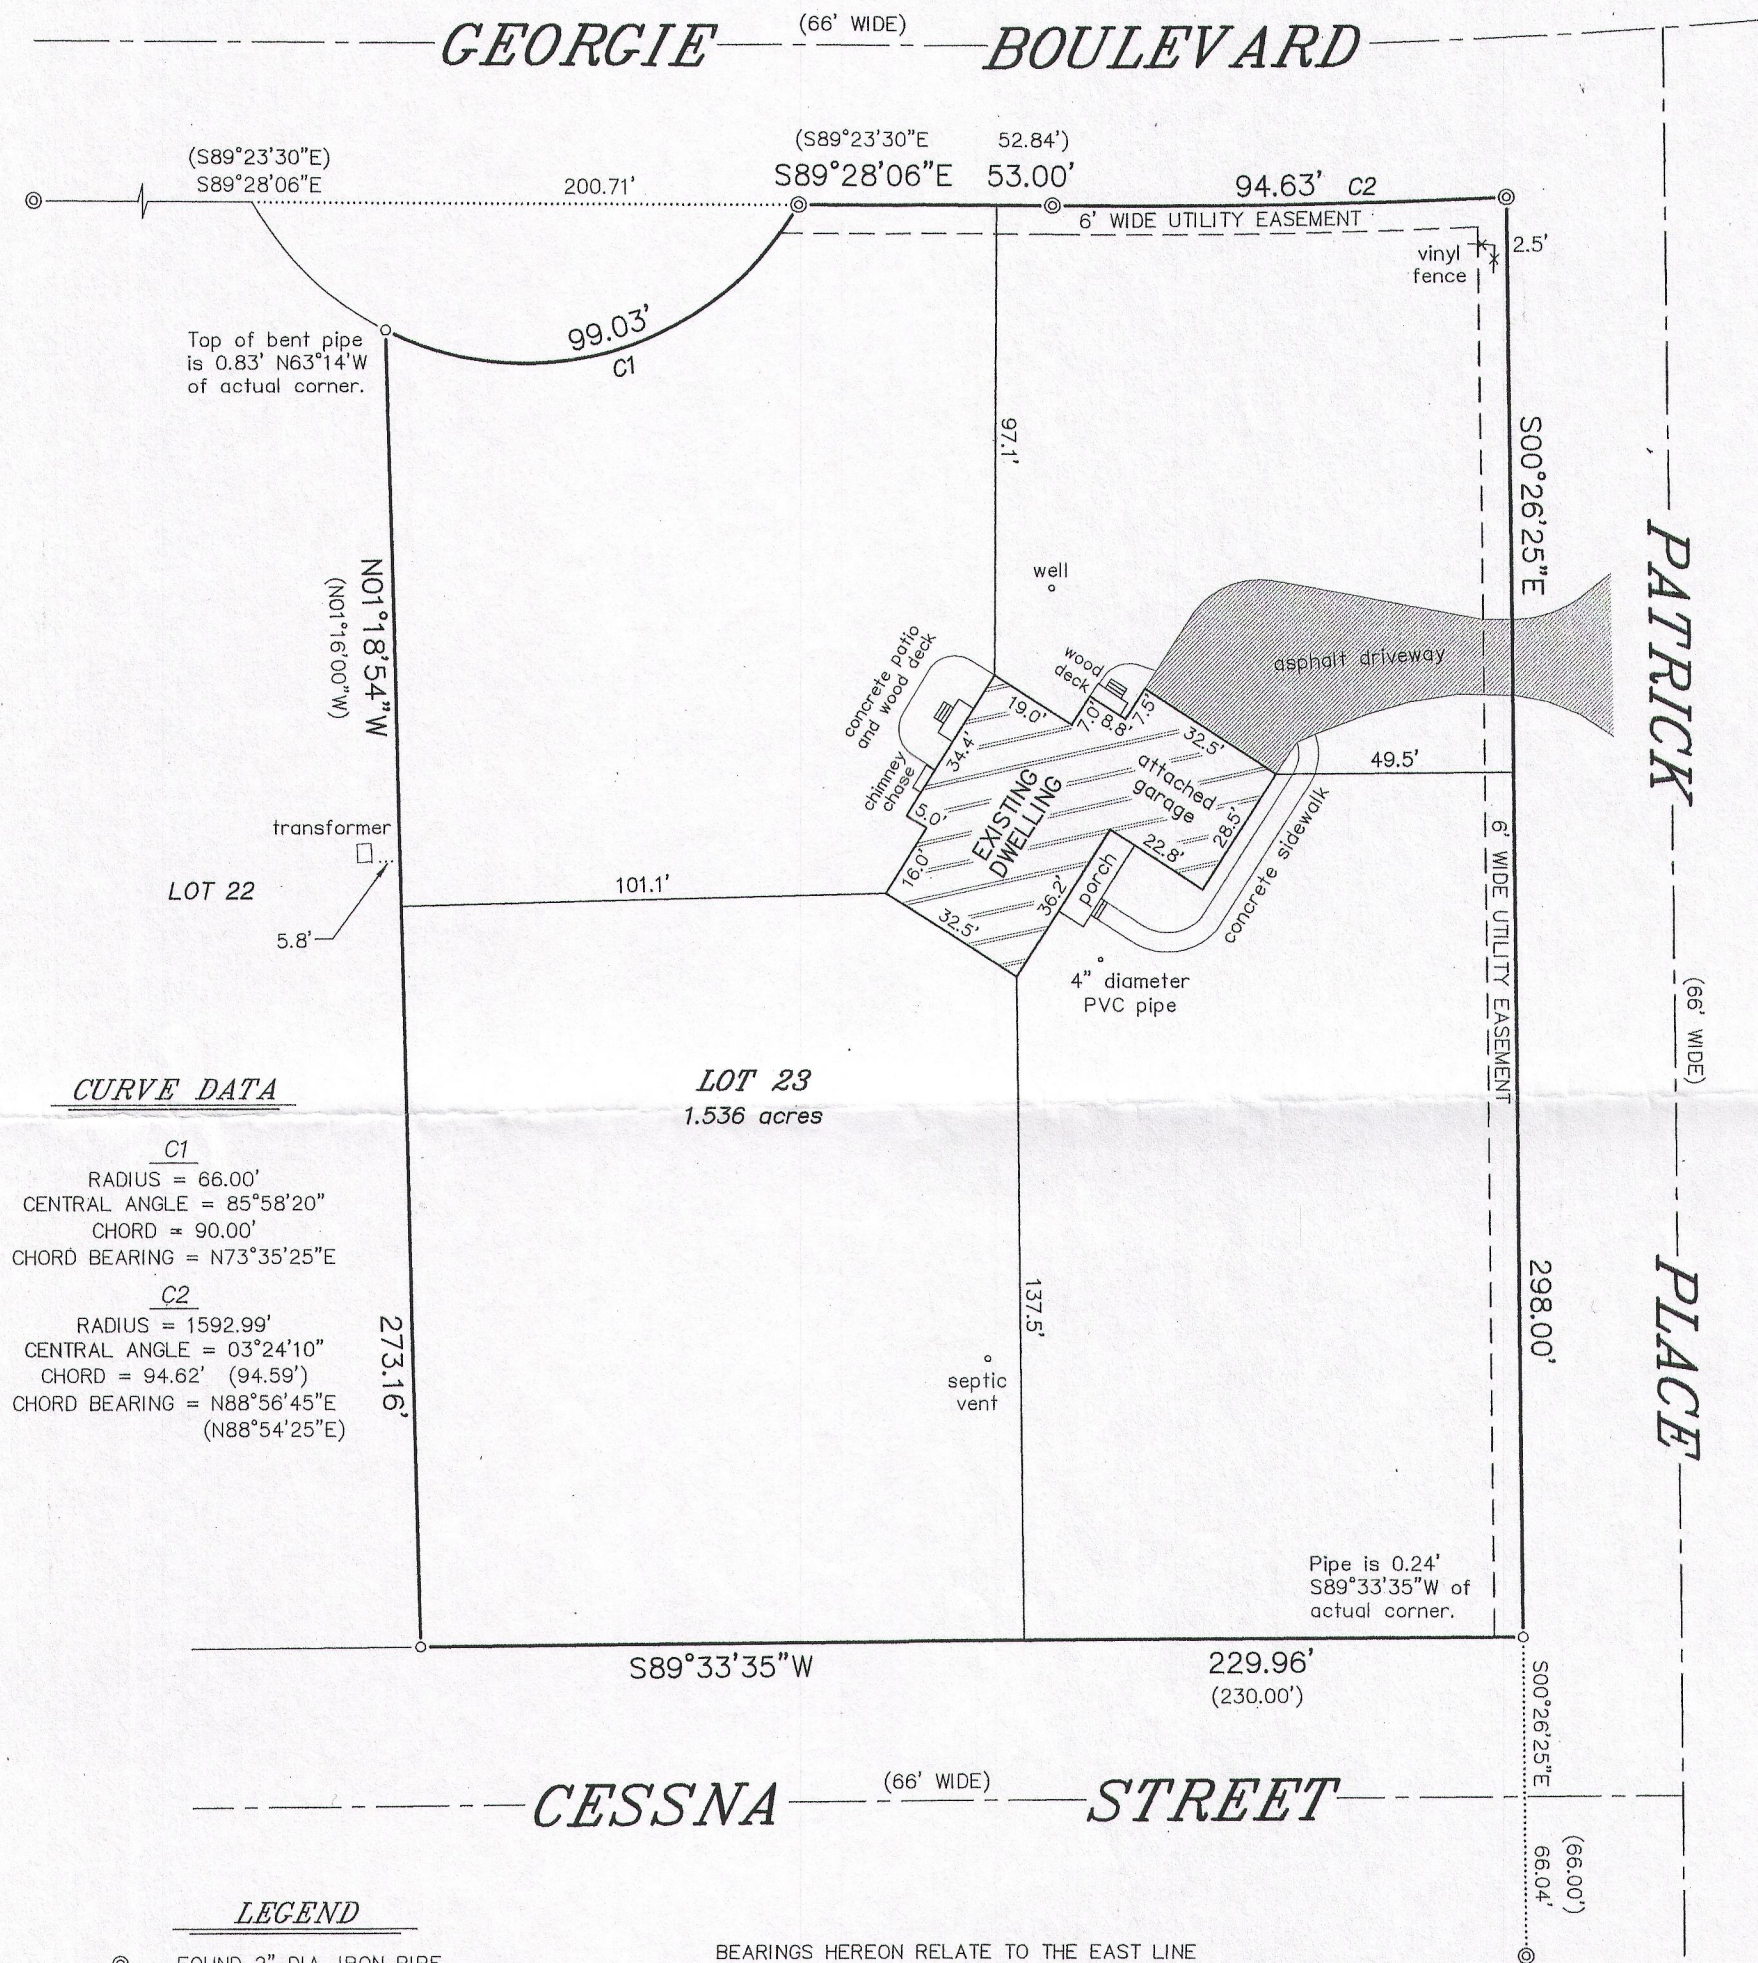


"I HEREBY CERTIFY THAT I HAVE SURVEYED THE ABOVE DESCRIBED PROPERTY AND THAT THE ABOVE MAP IS A CORRECT REPRESENTATION THEREOF AND SHOWS THE SIZE AND LOCATION OF THE PROPERTY, ITS EXTERIOR BOUNDARIES, THE LOCATION OF ALL VISIBLE STRUCTURES AND DIMENSIONS OF ALL PRINCIPAL BUILDINGS THEREON, BOUNDARY FENCES, APPARENT EASEMENTS, ROADWAYS AND ENCROACHMENTS, IF ANY."

"THIS SURVEY IS MADE FOR THE USE OF THE PRESENT OWNERS OF THE PROPERTY, AND THOSE WHO PURCHASE, MORTGAGE, OR GUARANTEE THE TITLE THERETO WITHIN ONE YEAR FROM DATE HEREOF."

SATTER SURVEYING, LLC
LAND SURVEYS, MAPPING AND PLANNING
272 ORIGIN STREET
BURLINGTON, WI 53105
262-661-4239

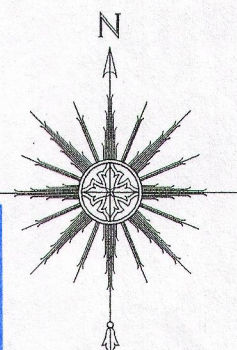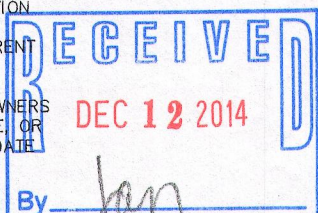

0 20' 40' 80'
SCALE: 1" = 40'

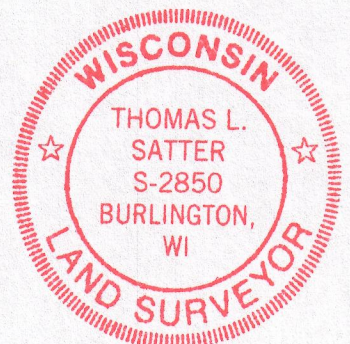

THIS IS NOT AN ORIGINAL PRINT
UNLESS THIS SEAL IS RED.

Thomas L. Satter
THOMAS L. SATTER S-2850

NOVEMBER 5, 2014
DATE

101414
JOB NUMBER

8LAI-16

118-3189