
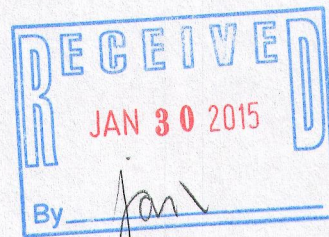


PLAT OF SURVEY
-OF-



LOTS 1731 THROUGH 1740, INCLUSIVE, BLOCK 39, PELL LAKE SECTION 1, ACCORDING TO THE RECORDED PLAT THEREOF. SAID LAND BEING IN THE VILLAGE OF BLOOMFIELD, WALWORTH COUNTY, WISCONSIN.

SURVEY FOR: KAREN OSTERMEIER OF KEEFE REAL ESTATE
SURVEY ADDRESS: N1320 CHERRY DRIVE

NOTE: THE ORIGINAL SUBDIVISION PLAT ON FILE IN THE WALWORTH COUNTY REGISTER OF DEEDS OFFICE IN CABINET 3, SLIDE 77 IS NEARLY ILLEGIBLE IN THIS AREA. IT IS BELIEVED BY THIS OFFICE THAT THE RADIUS READS 193.58'.

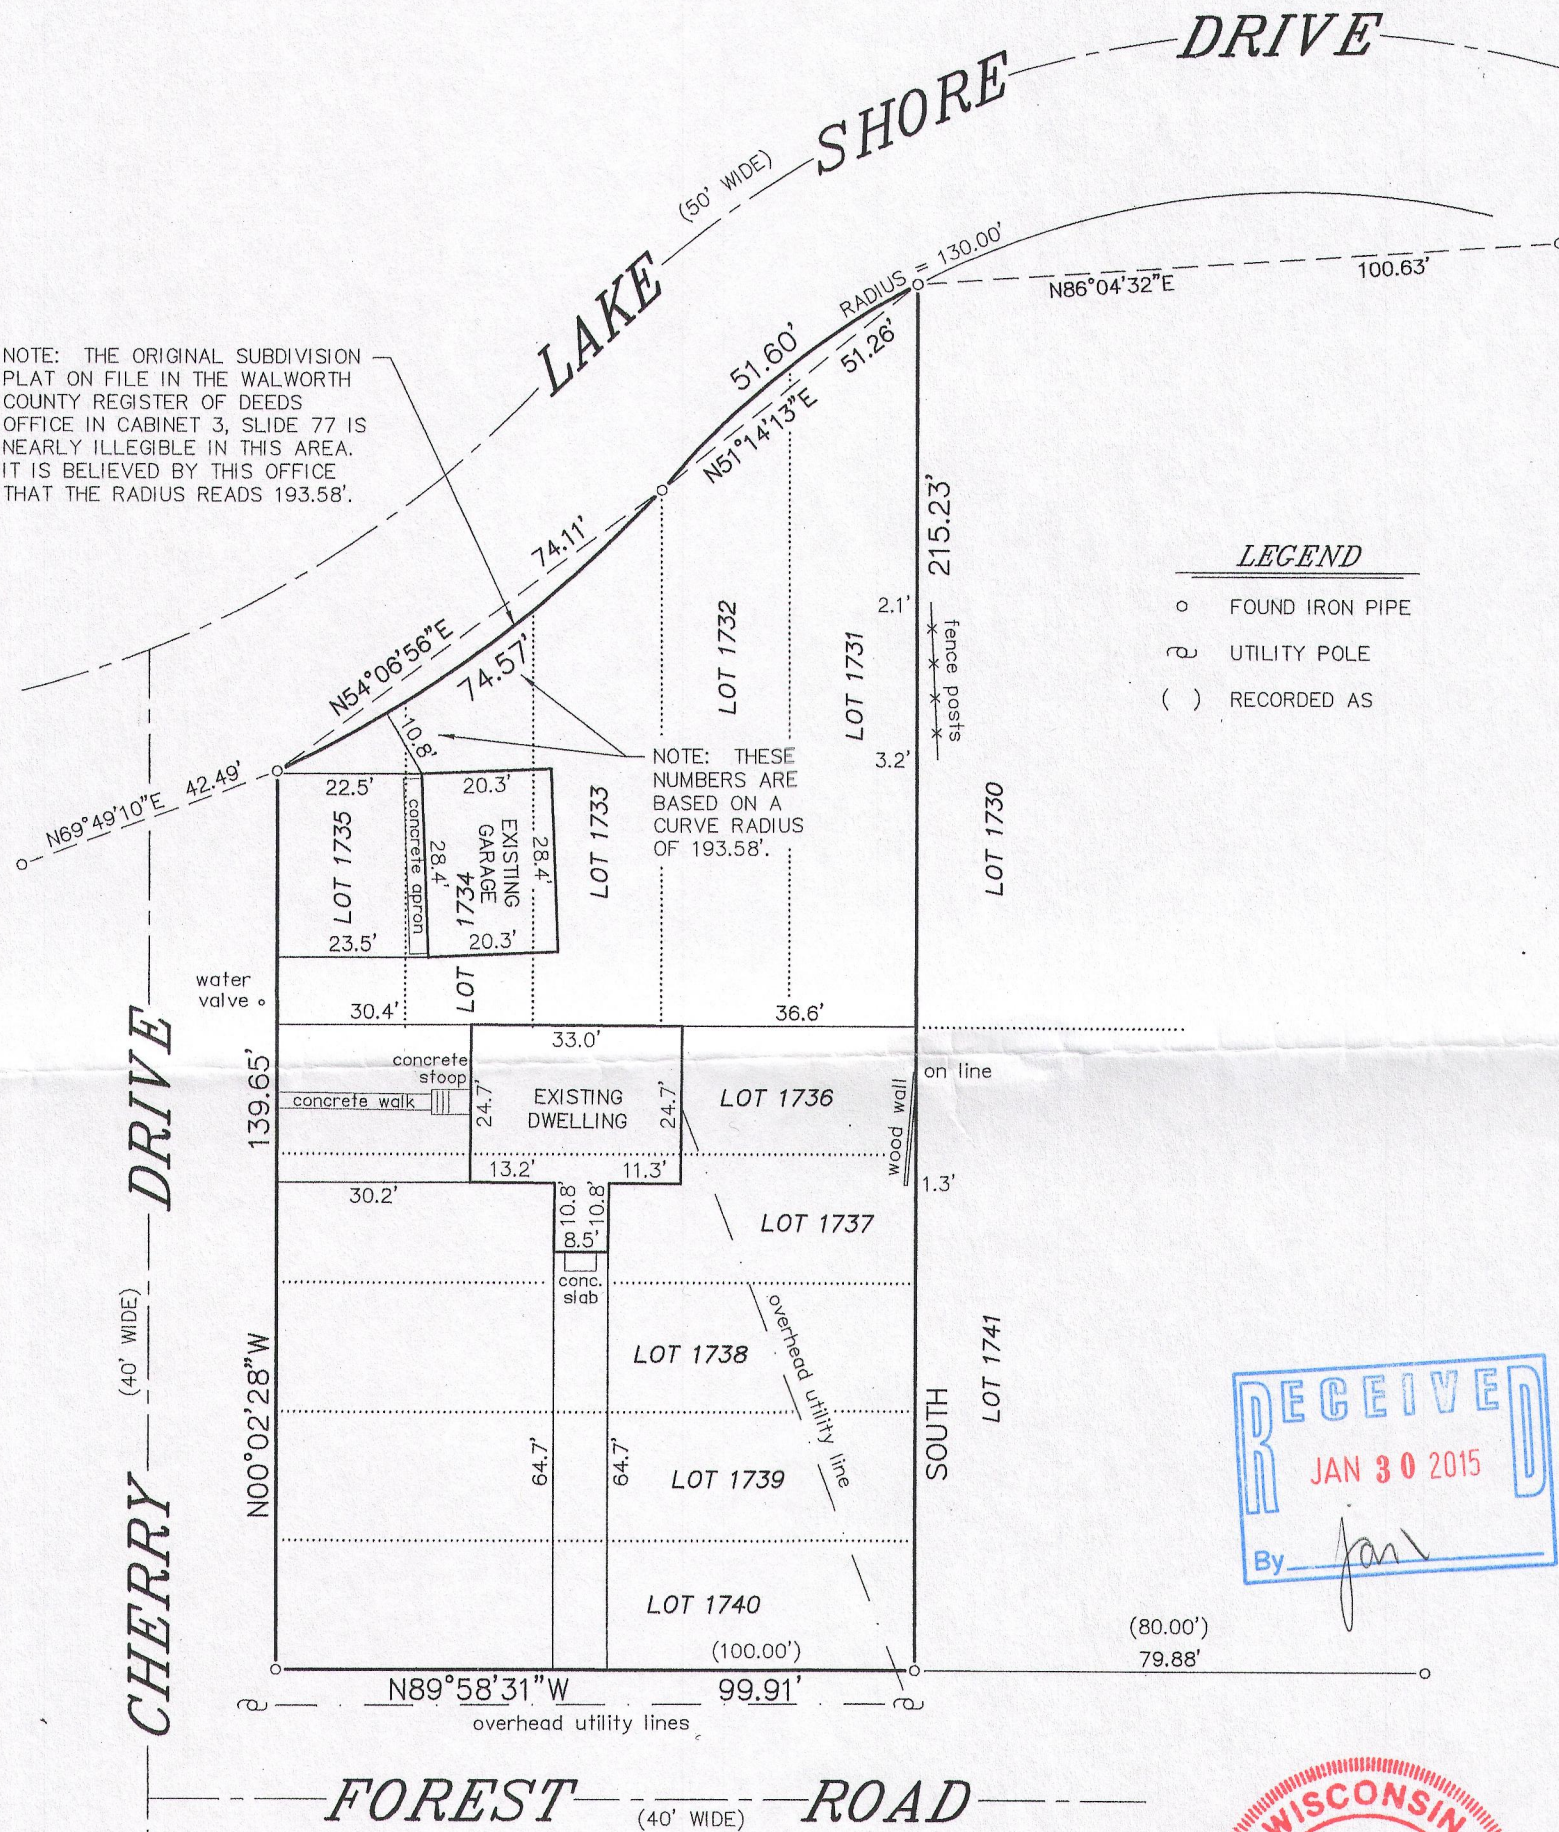

BEARINGS HEREON RELATE TO THE EAST LINE OF LOTS 1731-1740 IN BLOCK 39 OF PELL LAKE SUBDIVISION SECTION 1. ASSUMED BEARING OF SOUTH.

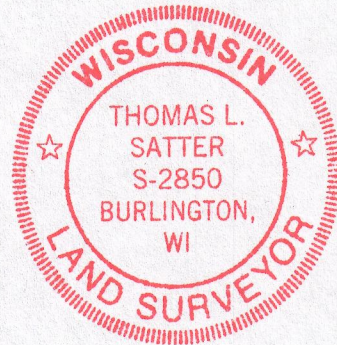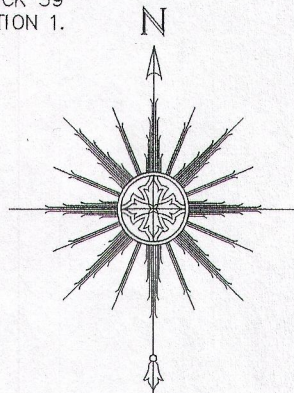

THIS IS NOT AN ORIGINAL PRINT
UNLESS THIS SEAL IS RED.

Thomas L. Satter
THOMAS L. SATTER S-2850

"I HEREBY CERTIFY THAT I HAVE SURVEYED THE ABOVE DESCRIBED PROPERTY AND THAT THE ABOVE MAP IS A CORRECT REPRESENTATION THEREOF AND SHOWS THE SIZE AND LOCATION OF THE PROPERTY, ITS EXTERIOR BOUNDARIES, THE LOCATION OF ALL VISIBLE STRUCTURES AND DIMENSIONS OF ALL PRINCIPAL BUILDINGS THEREON, BOUNDARY FENCES, APPARENT EASEMENTS, ROADWAYS AND ENCROACHMENTS, IF ANY."

"THIS SURVEY IS MADE FOR THE USE OF THE PRESENT OWNERS OF THE PROPERTY, AND THOSE WHO PURCHASE, MORTGAGE, OR GUARANTEE THE TITLE THERETO WITHIN ONE YEAR FROM DATE HEREOF."

SATTER SURVEYING, LLC
LAND SURVEYS, MAPPING AND PLANNING
272 ORIGEN STREET
BURLINGTON, WI 53105
262-661-4239

0 15' 30' 60'
SCALE: 1" = 30'

DECEMBER 16, 2014
DATE

121403
JOB NUMBER

2 PL-376

118-3196