


PLAT OF SURVEY
-OF-

LOTS 8978-8989 AND LOTS 9033-9034, INCLUSIVE, BLOCK 157, MAP OF SECTION 5 OF PELL LAKE SUBDIVISION, ACCORDING TO THE RECORDED PLAT THEREOF. SAID LAND BEING IN THE VILLAGE OF BLOOMFIELD, COUNTY OF WALWORTH AND STATE OF WISCONSIN.



SURVEY FOR: CARLOS & MARI ALBARRAN

NOTE: THIS MAP IS BEING REVISED THIS 7TH DAY OF FEBRUARY, 2017 TO DEPICT THE EXTERIOR BOUNDARY OF PARCEL NUMBERS 8PL 01807 AND 8PL 01808, WHICH ARE PROPOSED TO BE COMBINED INTO ONE PARCEL NUMBER.

BEARINGS HEREON RELATE TO THE SOUTHERLY LINE OF HERON ROAD. ASSUMED BEARING OF SOUTH 50°30'00" EAST AS PLATTED.

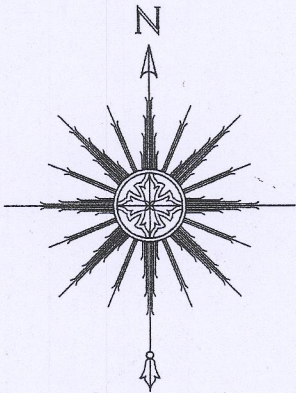

SCALE: 1" = 30'

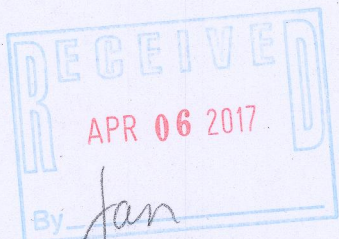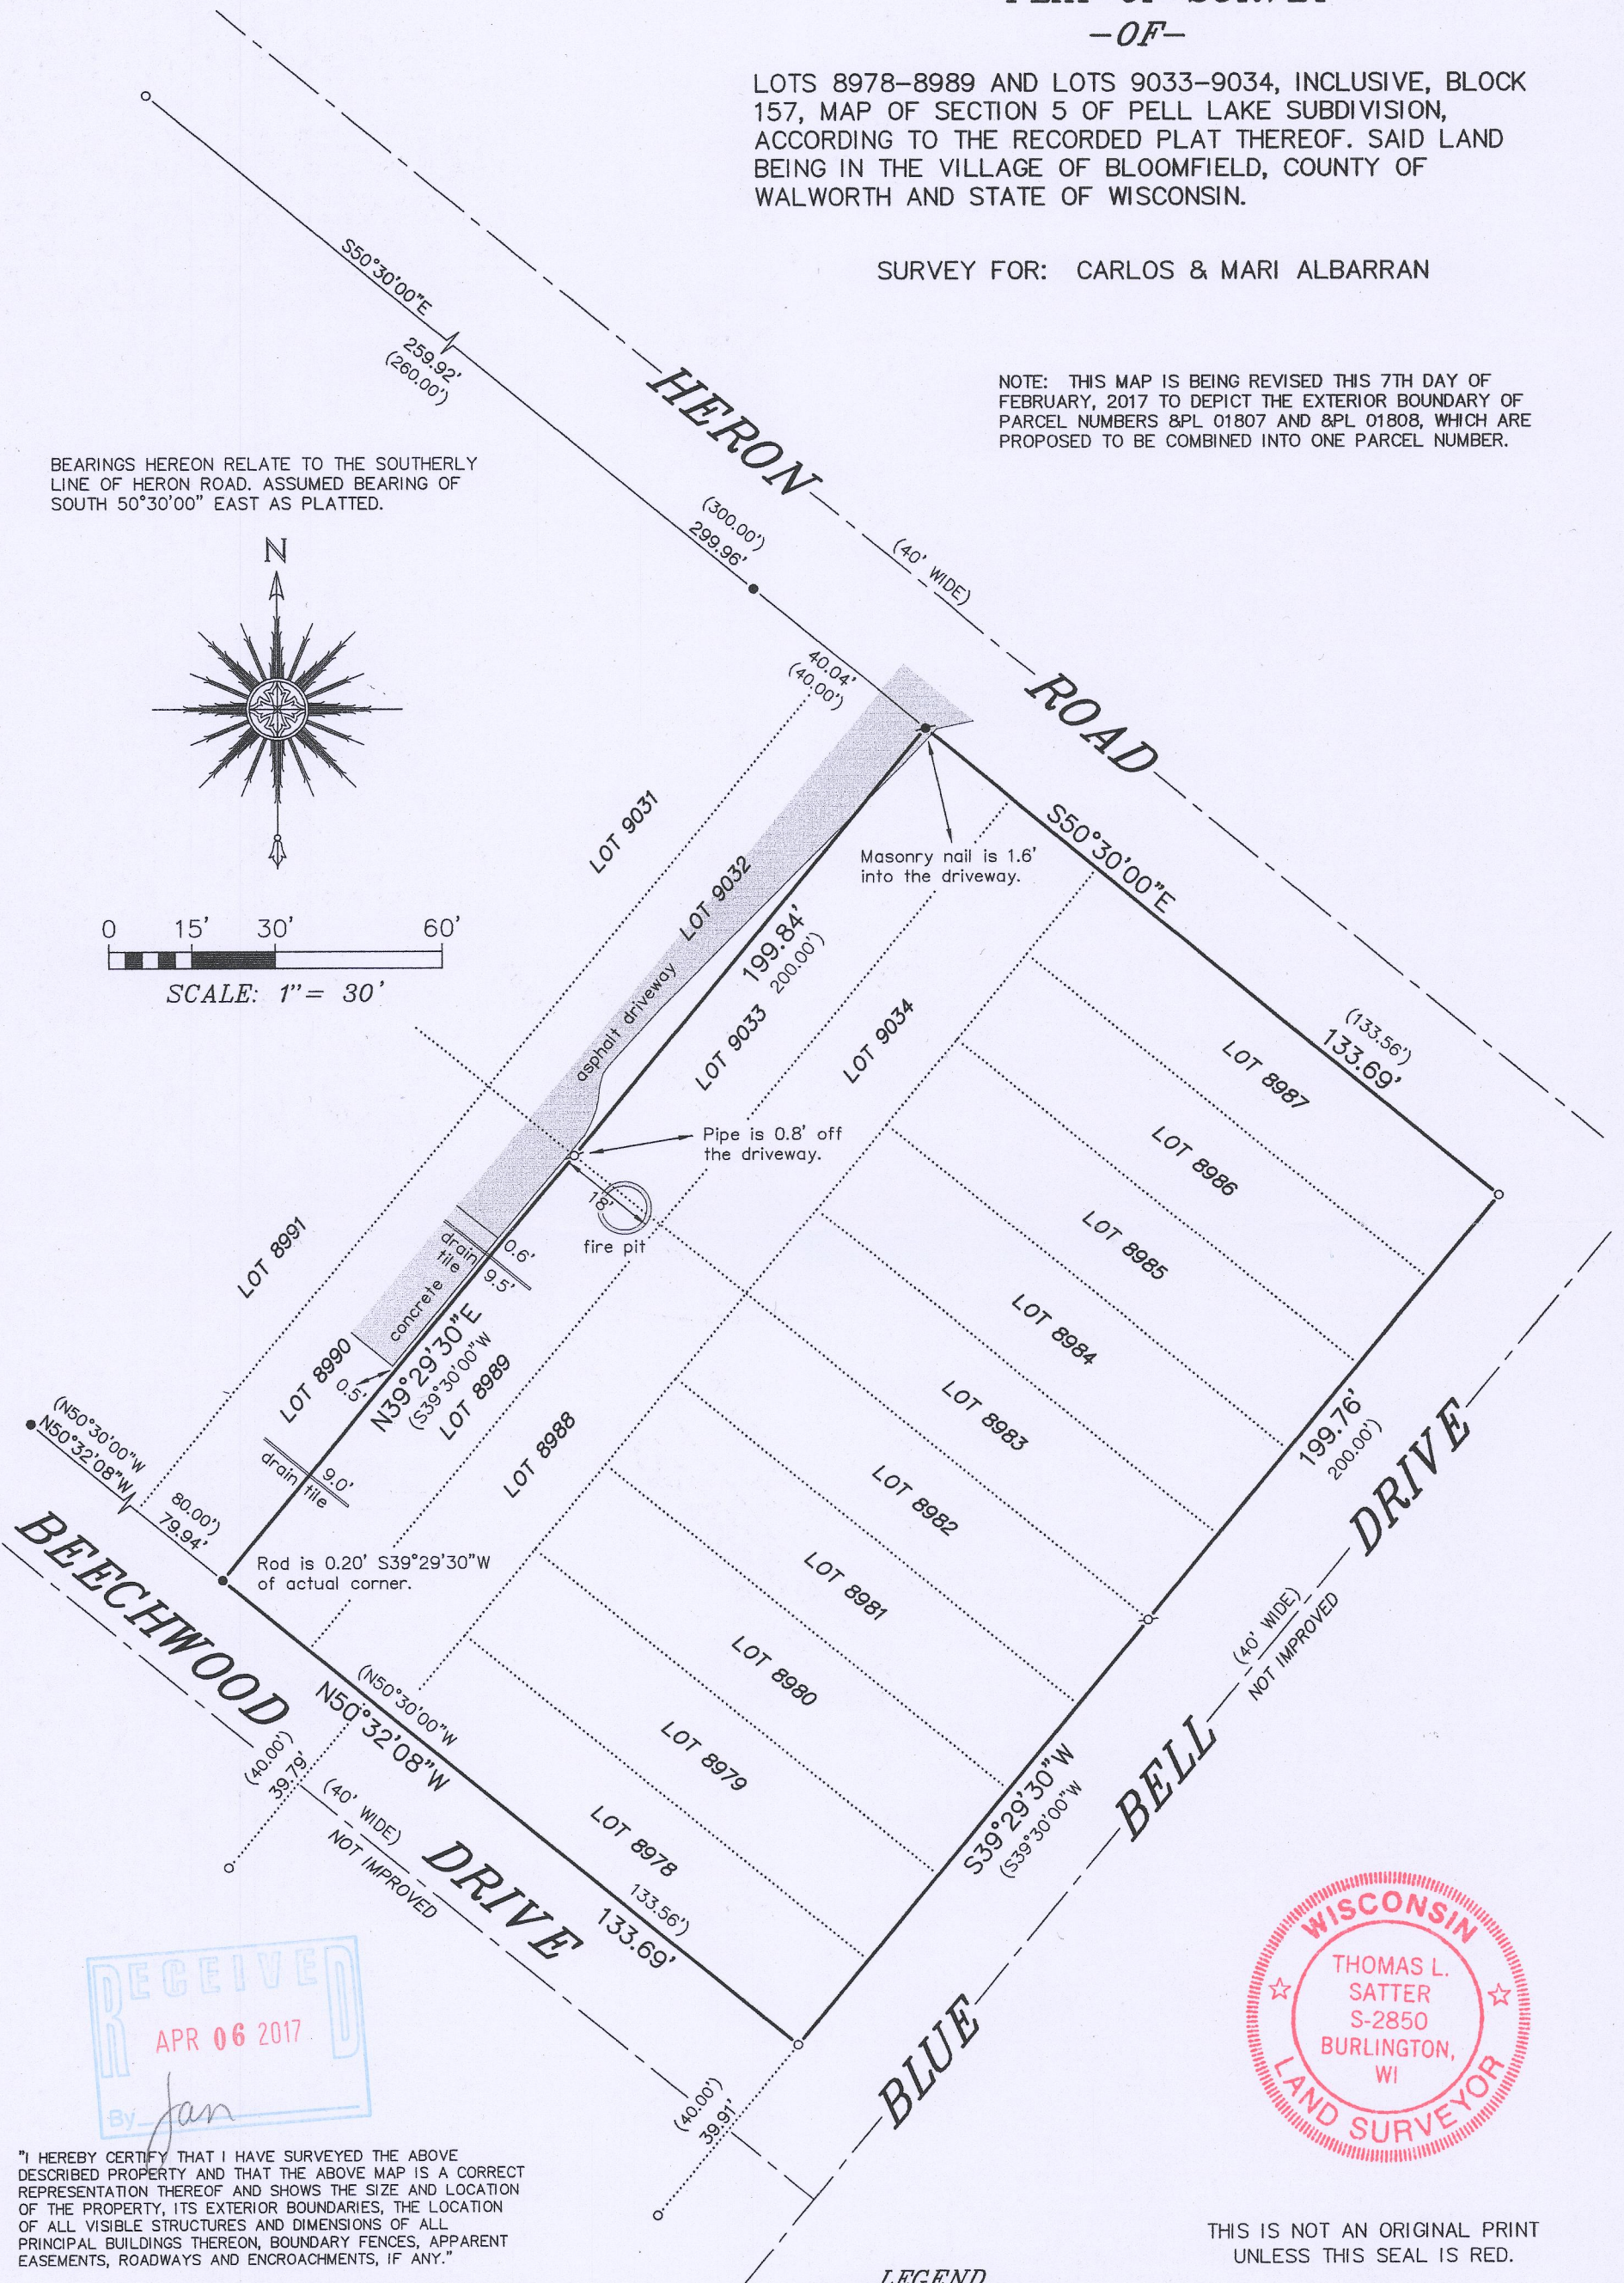

"I HEREBY CERTIFY THAT I HAVE SURVEYED THE ABOVE DESCRIBED PROPERTY AND THAT THE ABOVE MAP IS A CORRECT REPRESENTATION THEREOF AND SHOWS THE SIZE AND LOCATION OF THE PROPERTY, ITS EXTERIOR BOUNDARIES, THE LOCATION OF ALL VISIBLE STRUCTURES AND DIMENSIONS OF ALL PRINCIPAL BUILDINGS THEREON, BOUNDARY FENCES, APPARENT EASEMENTS, ROADWAYS AND ENCROACHMENTS, IF ANY."

"THIS SURVEY IS MADE FOR THE USE OF THE PRESENT OWNERS OF THE PROPERTY, AND THOSE WHO PURCHASE, MORTGAGE, OR GUARANTEE THE TITLE THERETO WITHIN ONE YEAR FROM DATE HEREOF."


SATTER SURVEYING, LLC
LAND SURVEYS, MAPPING AND PLANNING
272 ORIGIN STREET
BURLINGTON, WI 53105
262-661-4239

8PL-1807
8PL-1808

LEGEND

- FOUND IRON PIPE
- FOUND IRON ROD
- ⊘ SET IRON PIPE
- ✱ SET MASONRY NAIL
- () RECORDED AS

THIS IS NOT AN ORIGINAL PRINT
UNLESS THIS SEAL IS RED.

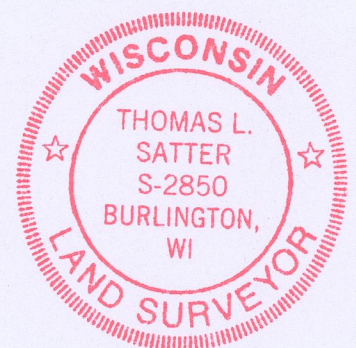

Thomas L. Satter
THOMAS L. SATTER S-2850

REVISED: 2/7/17
JANUARY 24, 2017
DATE

011703
JOB NUMBER

118-3300