
HAROLD H. KOLB

REGISTERED PROFESSIONAL LAND SURVEYOR
LAKE GENEVA, WISCONSIN

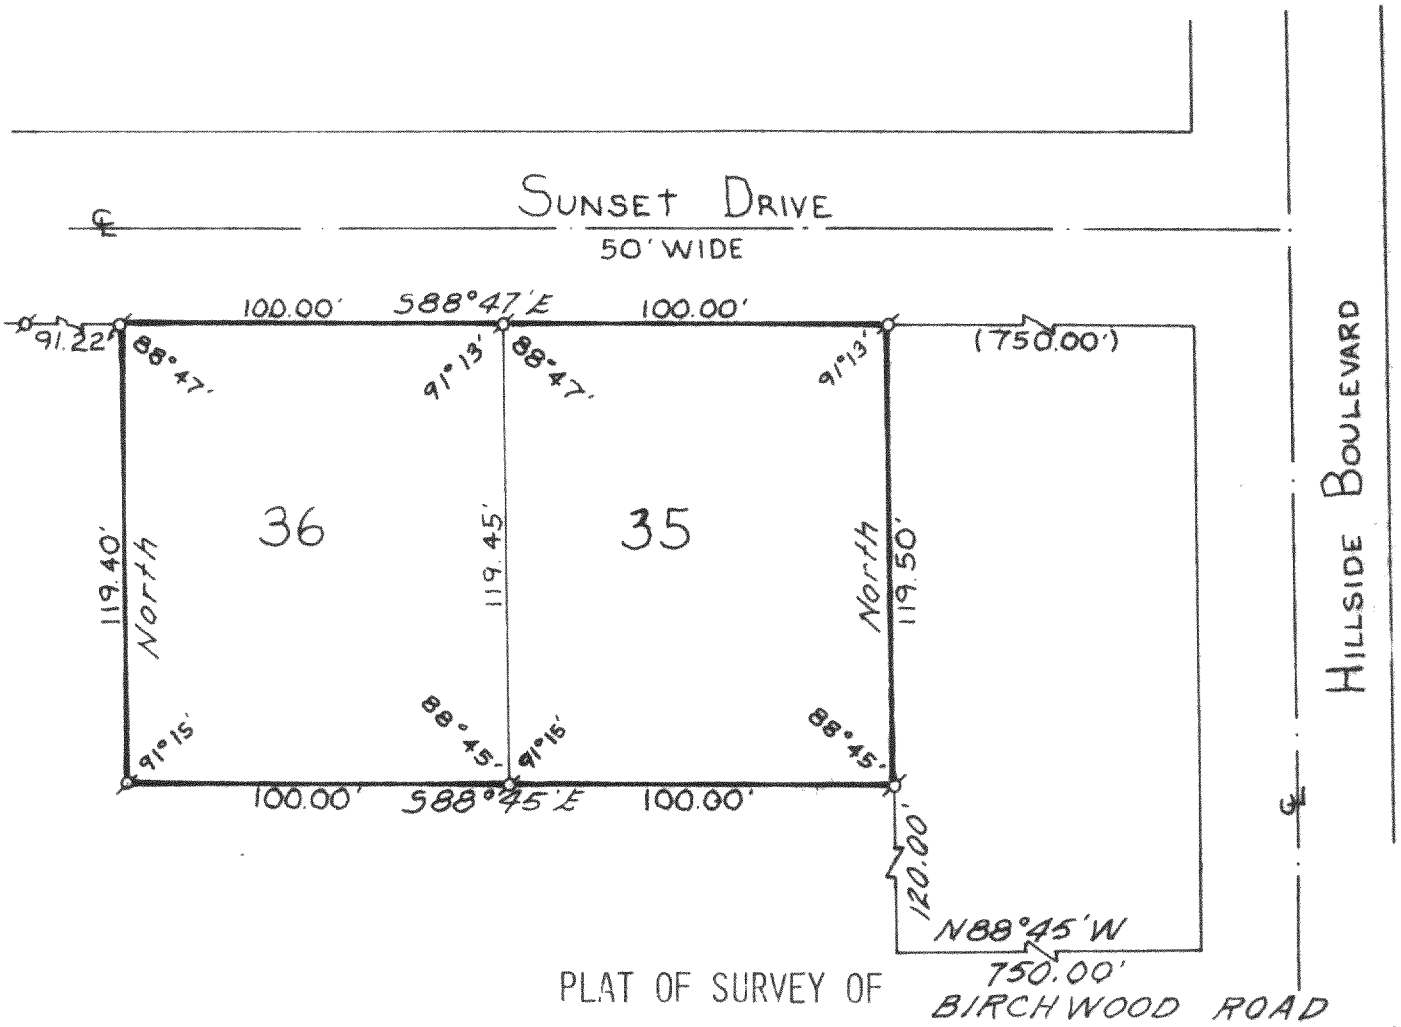

PLAT OF SURVEY OF

LOTS 35 AND 36 IN THE "GOLF COURSE" AS SHOWN ON THE RECORDED PLAT OF PELL LAKE HIGHLANDS IN THE SOUTH 1/4 OF SECTION 16, TOWN 1 NORTH, RANGE 18 EAST, WALWORTH COUNTY, WISCONSIN.

ORDERED BY: WALLY FITCHEN
HALLMARK REALTY
PELL LAKE, WI 53157

WISCONSIN
HAROLD H. KOLB
S-187
LAKE GENEVA, WIS.
LAND SURVEYOR

N

SCALE: 1" = 50'

LEGEND

O — IRON PIPE PLACED, 1" x 24" 1.13 LB./LIN. FT.
● — CONCRETE MONUMENT, 5" DIA. x 30"
ø — IRON PIPE FOUND ( ) - AS PLATTED

I, HAROLD H. KOLB, DO HEREBY CERTIFY THAT I HAVE SURVEYED THE PROPERTY HEREON DESCRIBED ACCORDING TO THE OFFICIAL RECORDS, AND THAT THE PLAT HEREON IS A CORRECT REPRESENTATION OF THE LOT LINES.

Harold H. Kolb

HAROLD H. KOLB
WISCONSIN REGISTERED LAND SURVEYOR, S-187
DATE June 28, 1978

BRUNING 40-108 1M-6-71

PLH-366

118-334