DEGEN – FOAT SURVEYING, INC.
100 SOUTH SECOND STREET
WATERFORD, WISCONSIN 53185
(262)534–5404 *(FAX)534–2022*


171041
171041S1.DWG

PLAT OF SURVEY

LOTS 8641–8645, BLOCK 164 OF SECTION 5 OF PELL LAKE SUBDIVISION, A SUBDIVISION LOCATED IN SECTION 22, TOWN 1 NORTH, RANGE 18 EAST, TOWN OF BLOOMFIELD, WALWORTH COUNTY, WISCONSIN.

* REFER TO A CURRENT TITLE REPORT FOR EASEMENTS, RESTRICTIONS OR COVENANTS OF RECORD THAT MAY AFFECT THIS LAND. *

SURVEY ORDERED BY: FRED LININGER JR.
SCHERRER CONSTRUCTION
601 BLACKHAWK DRIVE
BURLINGTON, WI 53105

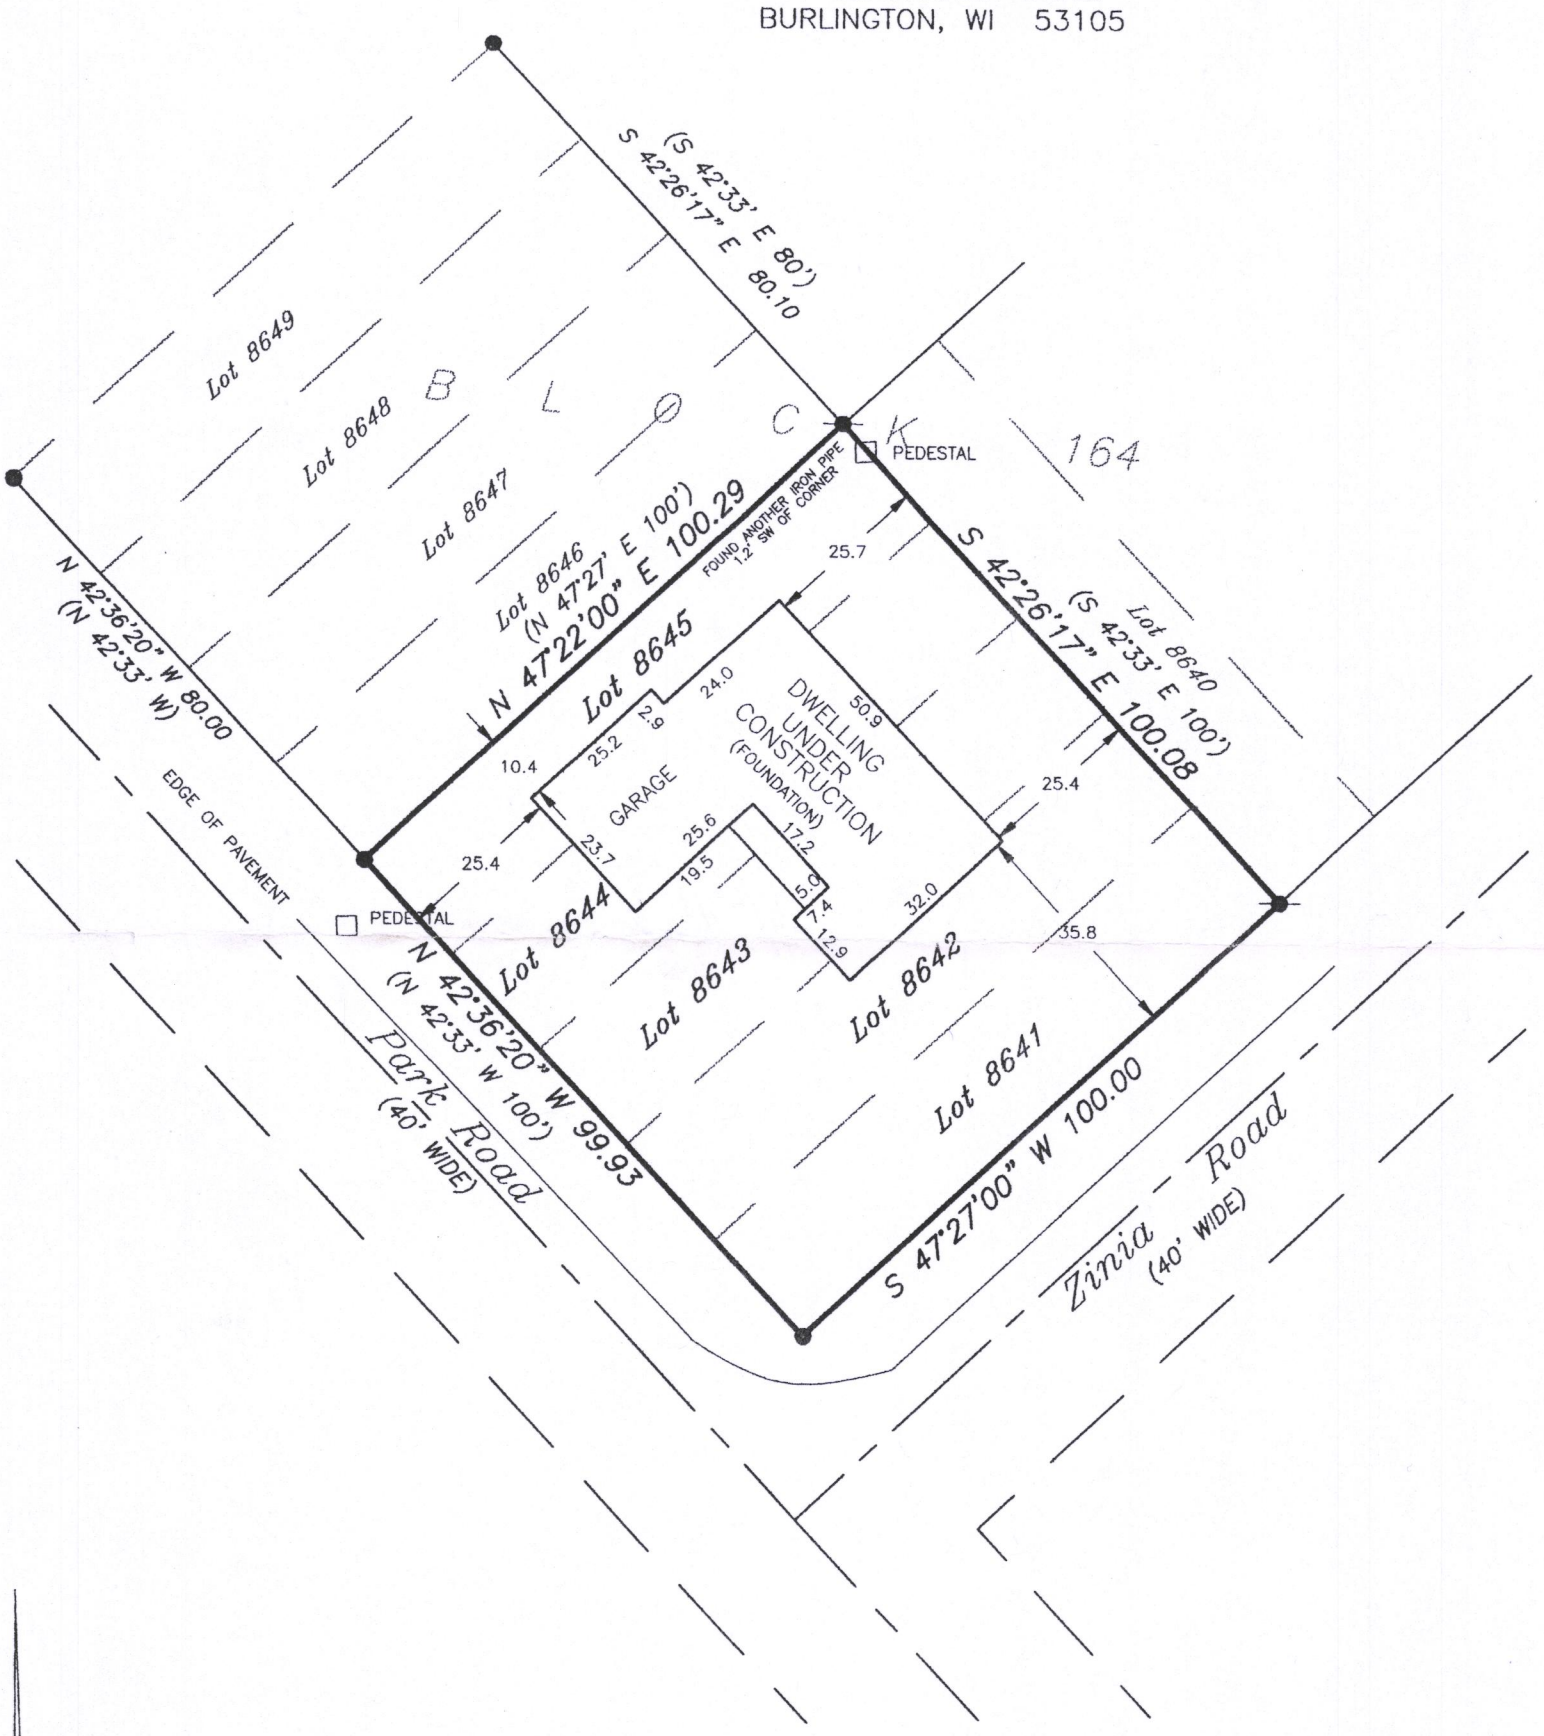

LEGEND

- ●— – FOUND REBAR
- ● – FOUND IRON PIPE
- ○ – SET IRON PIPE
- ( ) – RECORDED AS

SCALE: 1" = 30'

BEARING BASE: AS RECORDED AS.

WISCONSIN
GARY B FOAT S-1598 Waterford, Wis.
LAND SURVEYOR

RECEIVED
JUL 10 2018
By Jan

I HEREBY CERTIFY THAT I HAVE SURVEYED THE ABOVE DESCRIBED PROPERTY AND THE ABOVE MAP IS A TRUE REPRESENTATION THEREOF AND SHOWS THE SIZE AND LOCATION OF THE PROPERTY, THE LOCATION OF ALL VISIBLE STRUCTURES AND DIMENSIONS OF ALL PRINCIPAL BUILDINGS THEREON, BOUNDARY FENCES, APPARENT EASEMENTS, ROADWAY AND VISIBLE ENCROACHMENTS, IF ANY.

THIS SURVEY IS MADE FOR THE PRESENT OWNERS OF THE PROPERTY, AND ALSO THOSE WHO PURCHASE, OR GUARANTEE THE TITLE THERETO WITHIN (1) YEAR FROM THE DATE HEREOF.

DATED AT WATERFORD, WI THIS 17th DAY OF MAY 2017

RECERTIFIED JUNE 13, 2017

Gary B Foat

& PL-1736 : 118-3379