PLAT OF SURVEY
–OF–

LOTS 7151–7160 IN BLOCK 112 OF SECTION "A" OF PELL LAKE SUBDIVISION, ACCORDING TO THE RECORDED PLAT THEREOF. SAID LAND LOCATED IN THE NORTHWEST 1/4 OF THE NORTH EAST 1/4 OF SECTION 21, TOWNSHIP 1 NORTH, RANGE 18 EAST OF THE FOURTH PRINCIPAL MERIDIAN, IN THE VILLAGE OF BLOOMFIELD, COUNTY OF WALWORTH AND STATE OF WISCONSIN.

SURVEY FOR: LARRY KEMPKEN AND SONS, BUILDERS
SURVEY ADDRESS: _____ WALNUT ROAD

I HEREBY CERTIFY THAT THE EXISTING DWELLING UNDER CONSTRUCTION SHOWN ON THE PLAT OF SURVEY IS LOCATED AS SHOWN THUS (). THIS 25TH DAY OF MARCH, 2020.

ROBERT J. WETZEL S–1778

BEARINGS HEREON RELATE TO THE SOUTHEASETERLY LINE OF PEACH ROAD, ASSUMED BEARING NORTH 37°59'00" EAST.

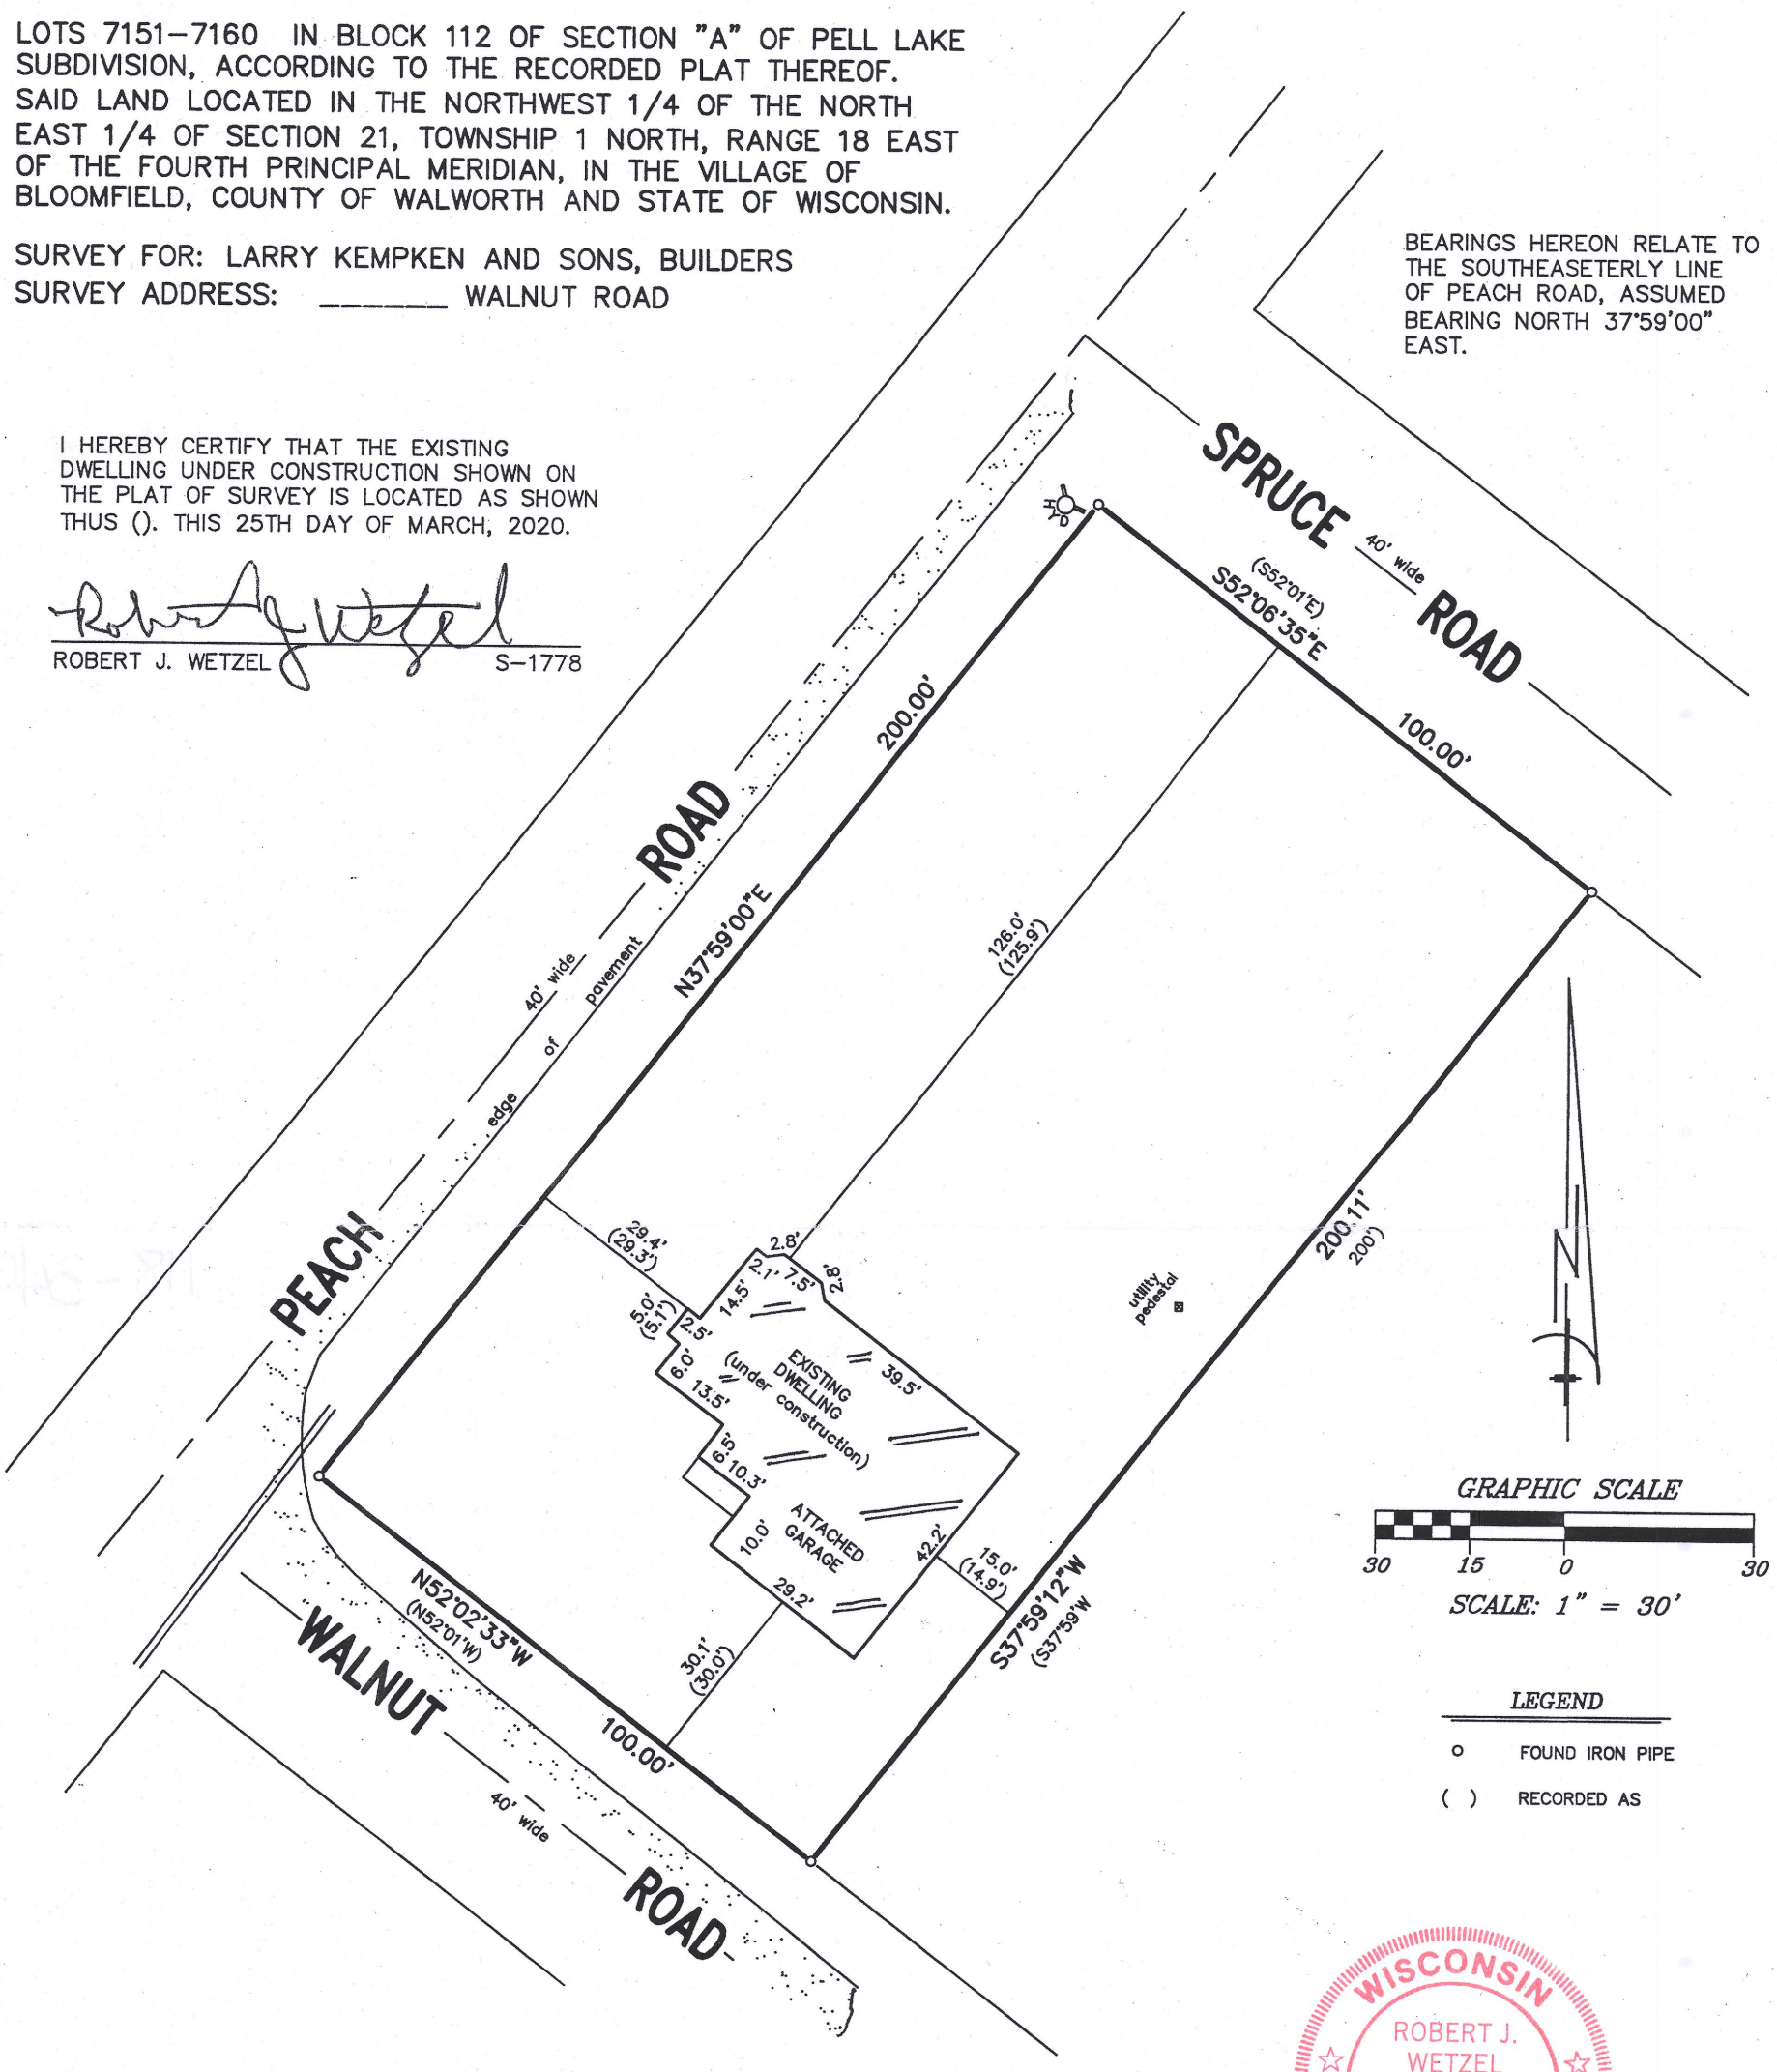

"I hereby certify that I have surveyed the above described property and that the above map is a correct representation thereof and shows the size and location of the property, its exterior boundaries, the location of all visible structures and dimensions of all principal buildings thereon, boundary fences, apparent easements, roadways and encroachments, if any."

"This survey is made for the use of the present owners of the property, and those who purchase, mortgage, or guarantee the title thereto within one year from date hereof."

RECEIVED
JUL 13 2020
By SMF

WISCONSIN
ROBERT J. WETZEL
S-1778
BURLINGTON, WI
LAND SURVEYOR

THIS IS NOT AN ORIGINAL PRINT UNLESS THIS SEAL IS RED.

B.W. SURVEYING, INC.
LAND SURVEYS
MAPPING AND PLANNING
412 N. PINE STREET
BURLINGTON, WI 53105
(262)–767–0225

ROBERT J. WETZEL S–1778

DECEMBER 26, 2019 — DATE

10012 — JOB NUMBER

&PL-1521 &PL-1522

118-3491