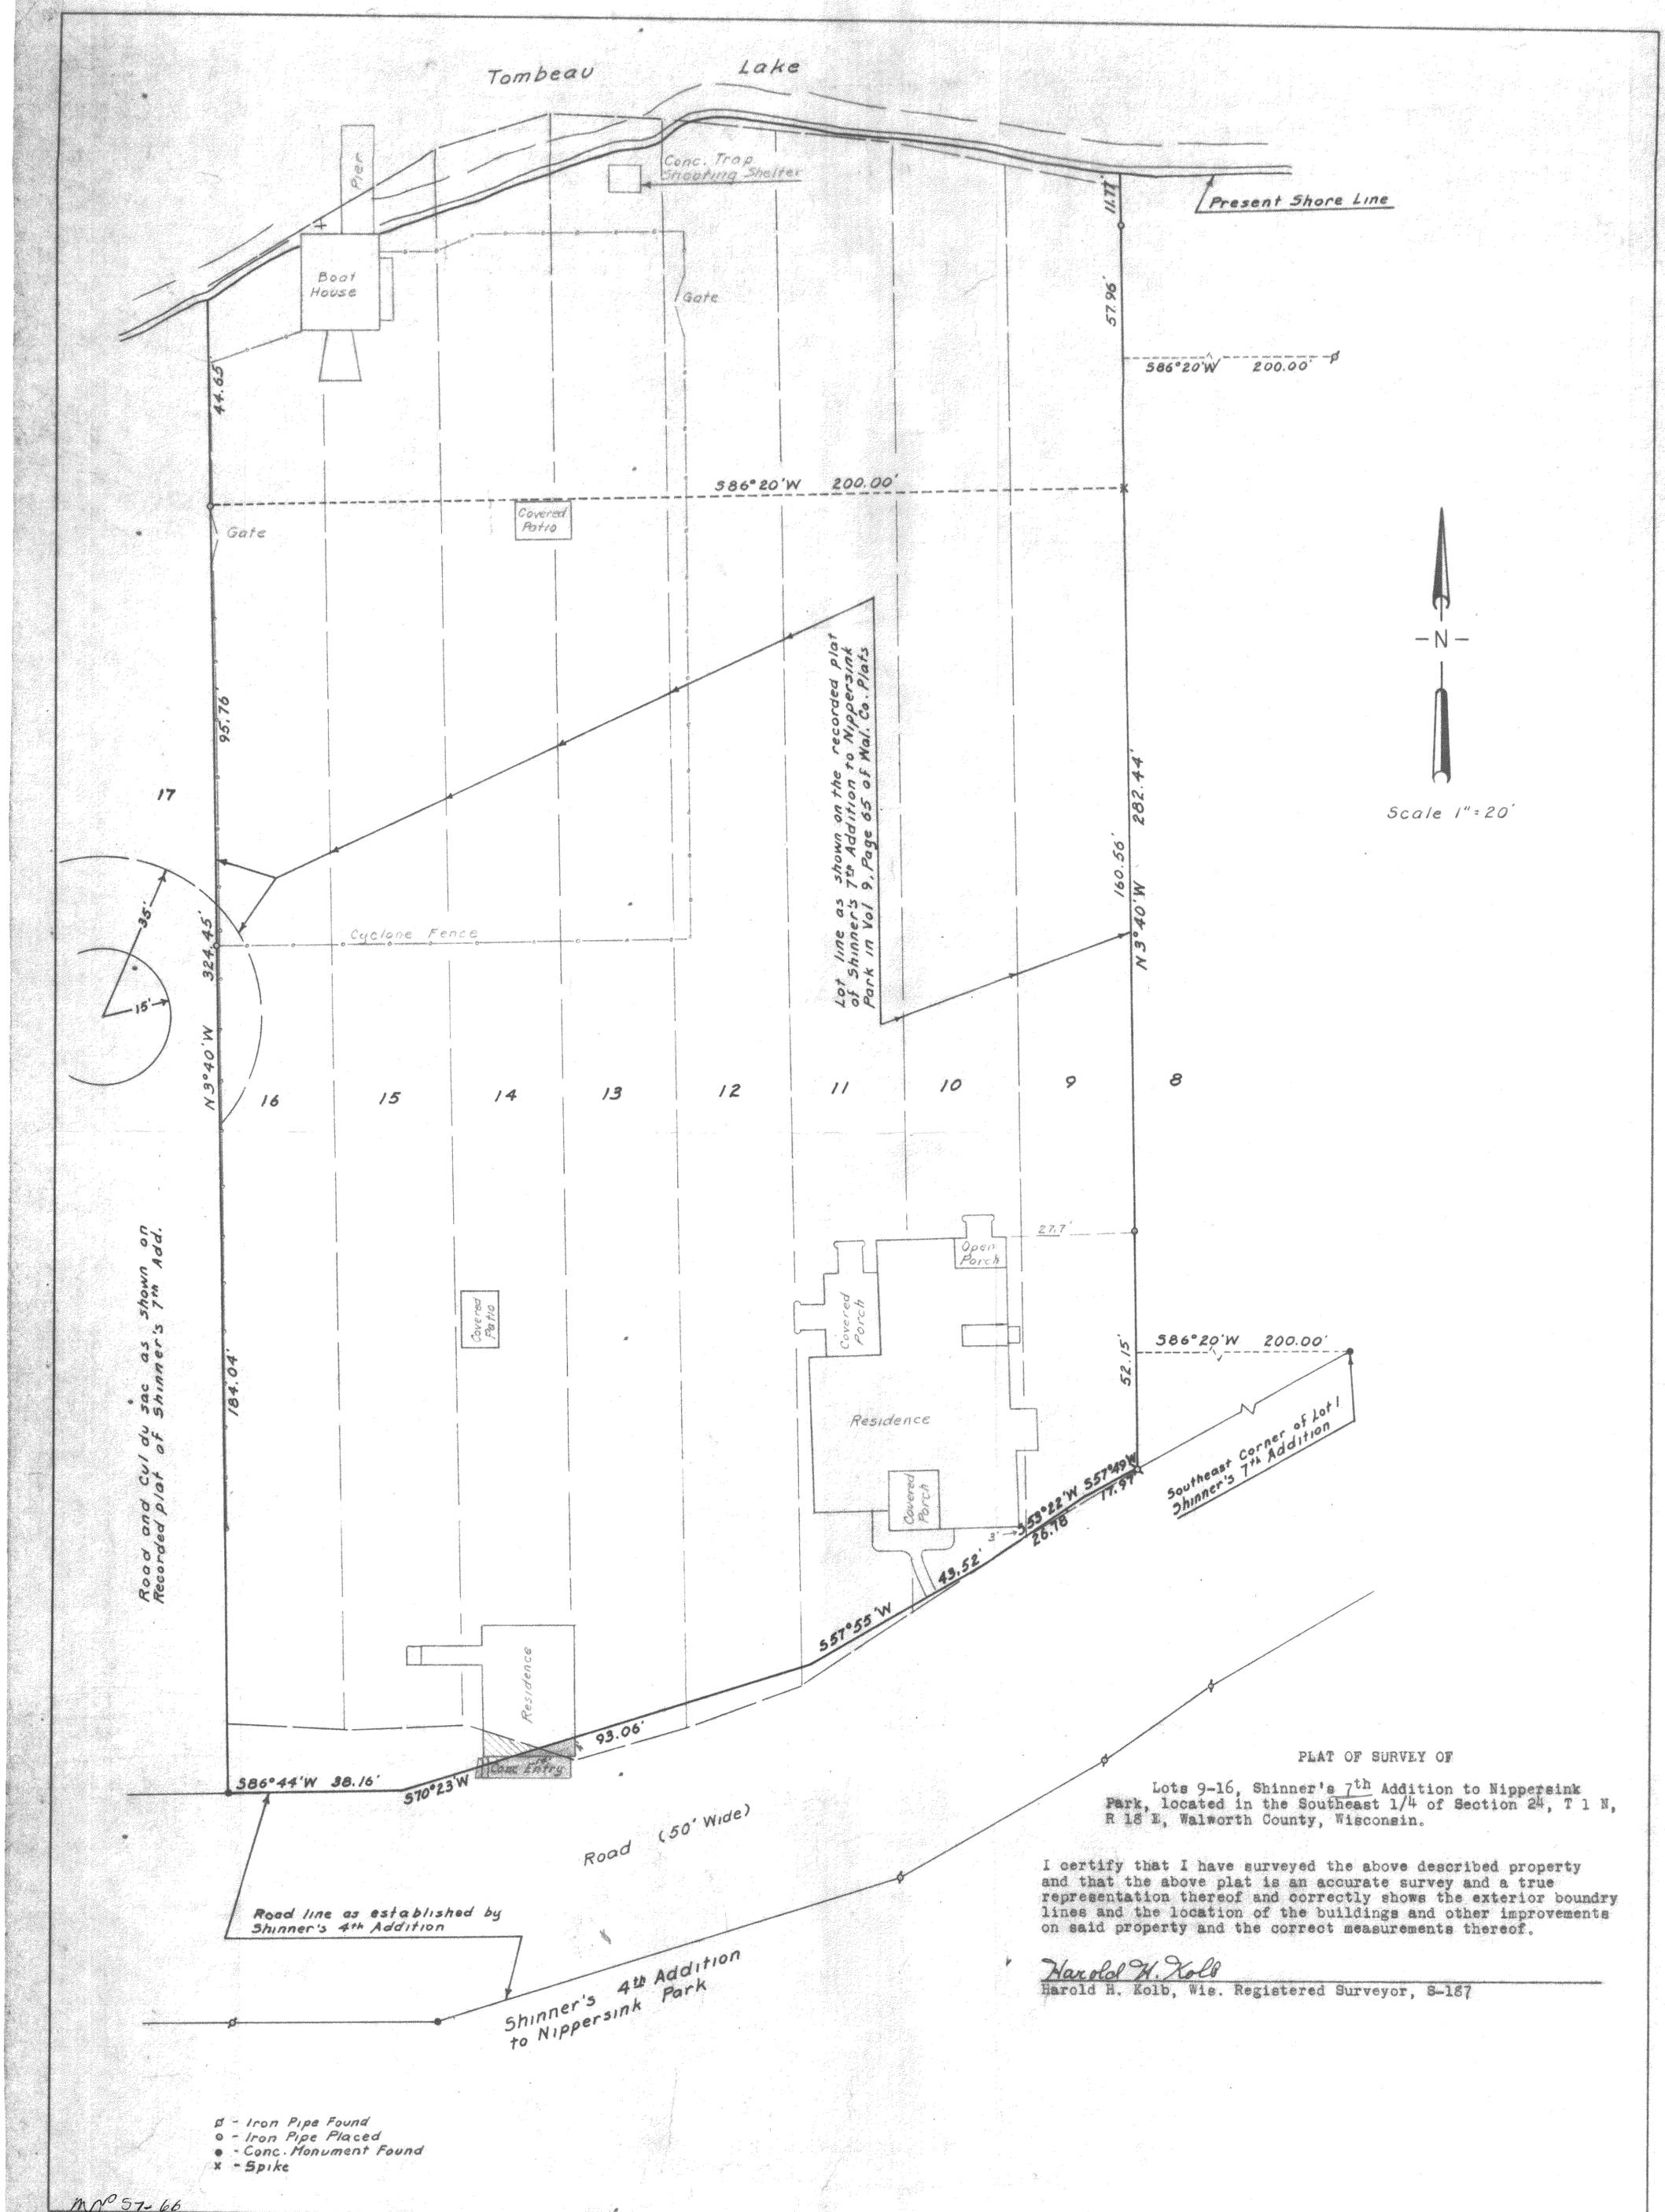

PLAT OF SURVEY OF

Lots 9-16, Shinner's 7th Addition to Nippersink Park, located in the Southeast 1/4 of Section 24, T 1 N, R 18 E, Walworth County, Wisconsin.

I certify that I have surveyed the above described property and that the above plat is an accurate survey and a true representation thereof and correctly shows the exterior boundry lines and the location of the buildings and other improvements on said property and the correct measurements thereof.

Harold H. Kolb

Harold H. Kolb, Wis. Registered Surveyor, S-187

MP 57-66

118-382