HAROLD H. KOLB

REGISTERED PROFESSIONAL LAND SURVEYOR

LAKE GENEVA, WISCONSIN

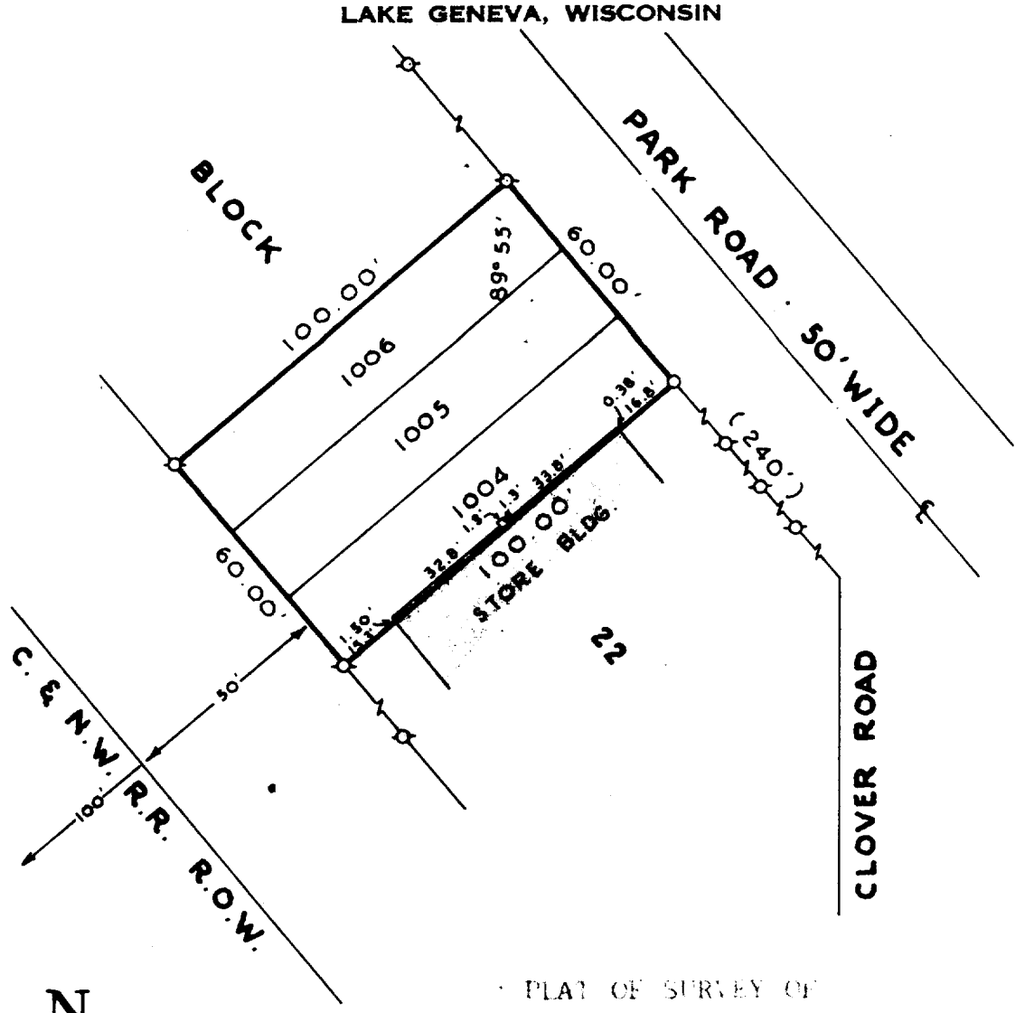

N

SCALE: 1"=40'

PLAT OF SURVEY OF

Lots 1004-1006, Block 22, Lyons Lake Subdivision--Section 1, T 1 N, R 18 E, Walworth County, Wisconsin.

LEGEND

- ϕ — IRON PIPE FOUND
- O — IRON PIPE PLACED
- ● — CONCRETE MONUMENT
- x — SPIKE
- ( ) — As Platted

WISCONSIN HAROLD H. KOLB S-187 LAKE GENEVA, WIS. LAND SURVEYOR

I, HAROLD H. KOLB, DO HEREBY CERTIFY THAT I HAVE SURVEYED THE PROPERTY HEREON DESCRIBED ACCORDING TO THE OFFICIAL RECORDS, AND THAT THE PLAT HEREON IS A CORRECT REPRESENTATION OF THE LOT LINES.

Harold H. Kolb

HAROLD H. KOLB
WISCONSIN REGISTERED LAND SURVEYOR, S-187

DATE June 2, 1973

118-393

BRUNING 40-108 1M 6 71