


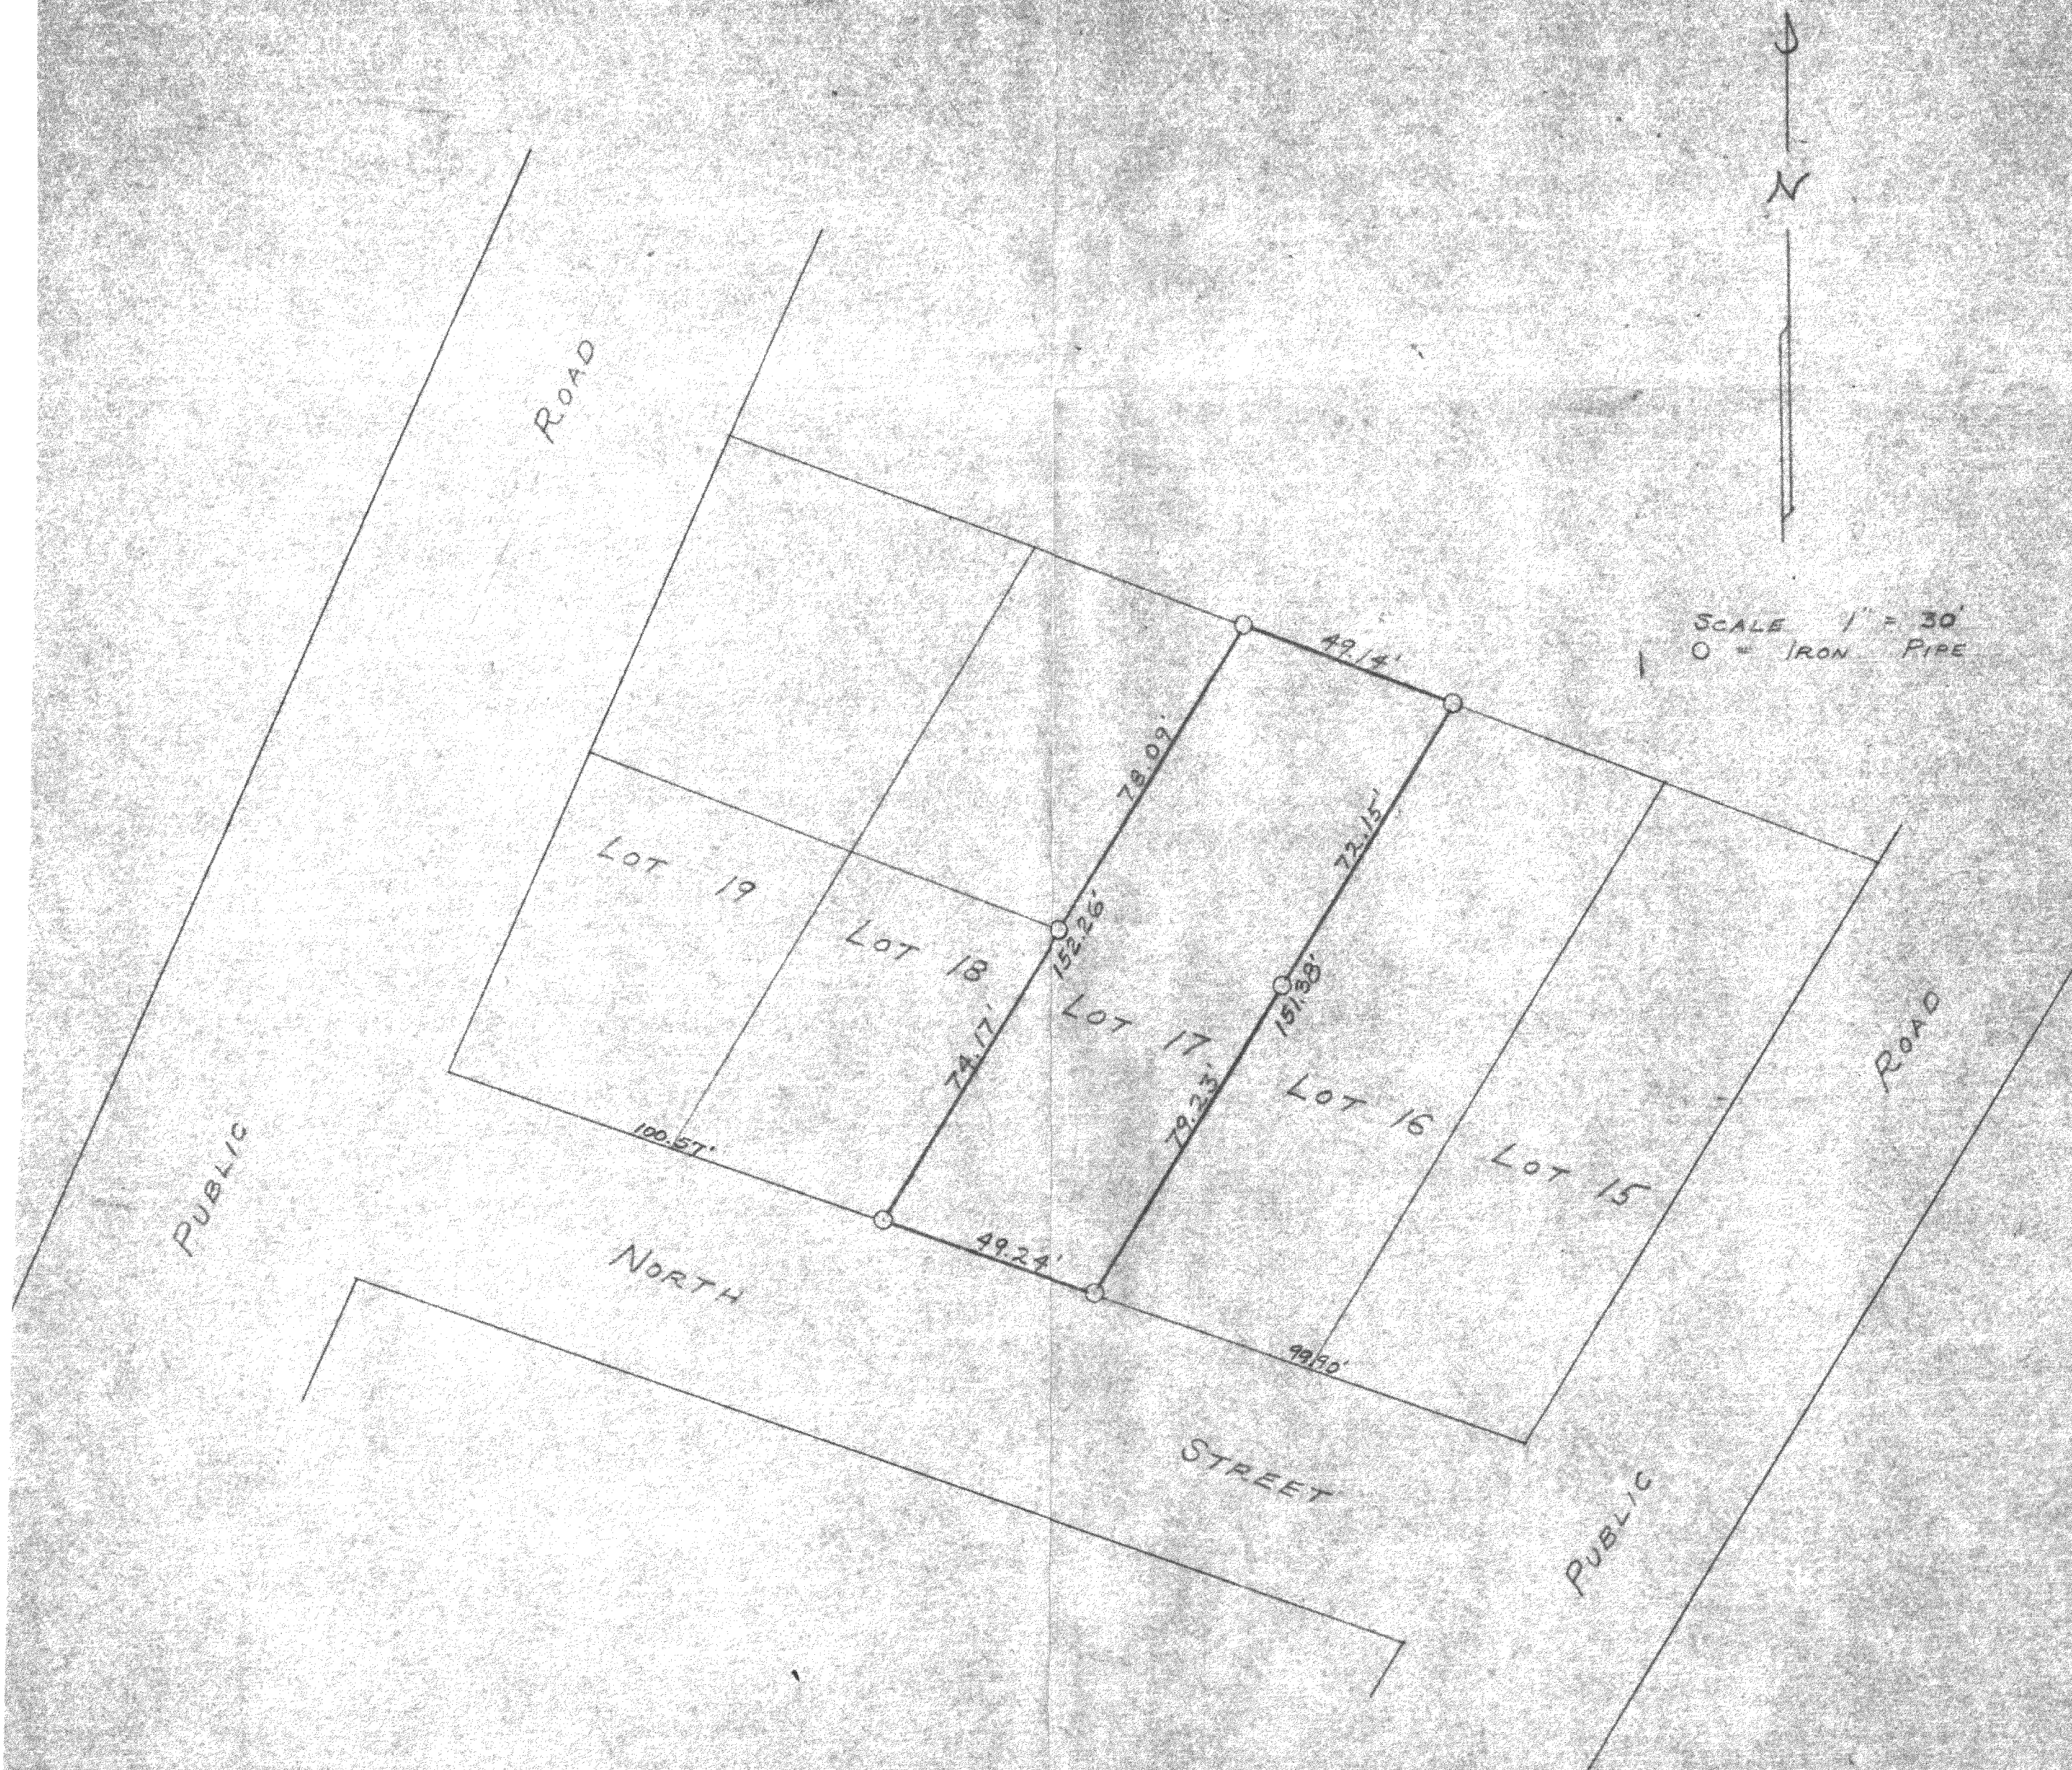

SCALE 1" = 30'
O = IRON PIPE

FLAT OF A SURVEY OF LOT 17 OF WILLIAM
ELLIOTT'S POWERS LAKE SUBDIVISION LOCATED IN THE
NORTHEAST 1/4 OF SECTION 13, T1 NR 18E OF WALWORTH
COUNTY, WISCONSIN
JULY 1952

Clyde L. Jensen
WALWORTH COUNTY SURVEYOR

118-41.1

MS-17