


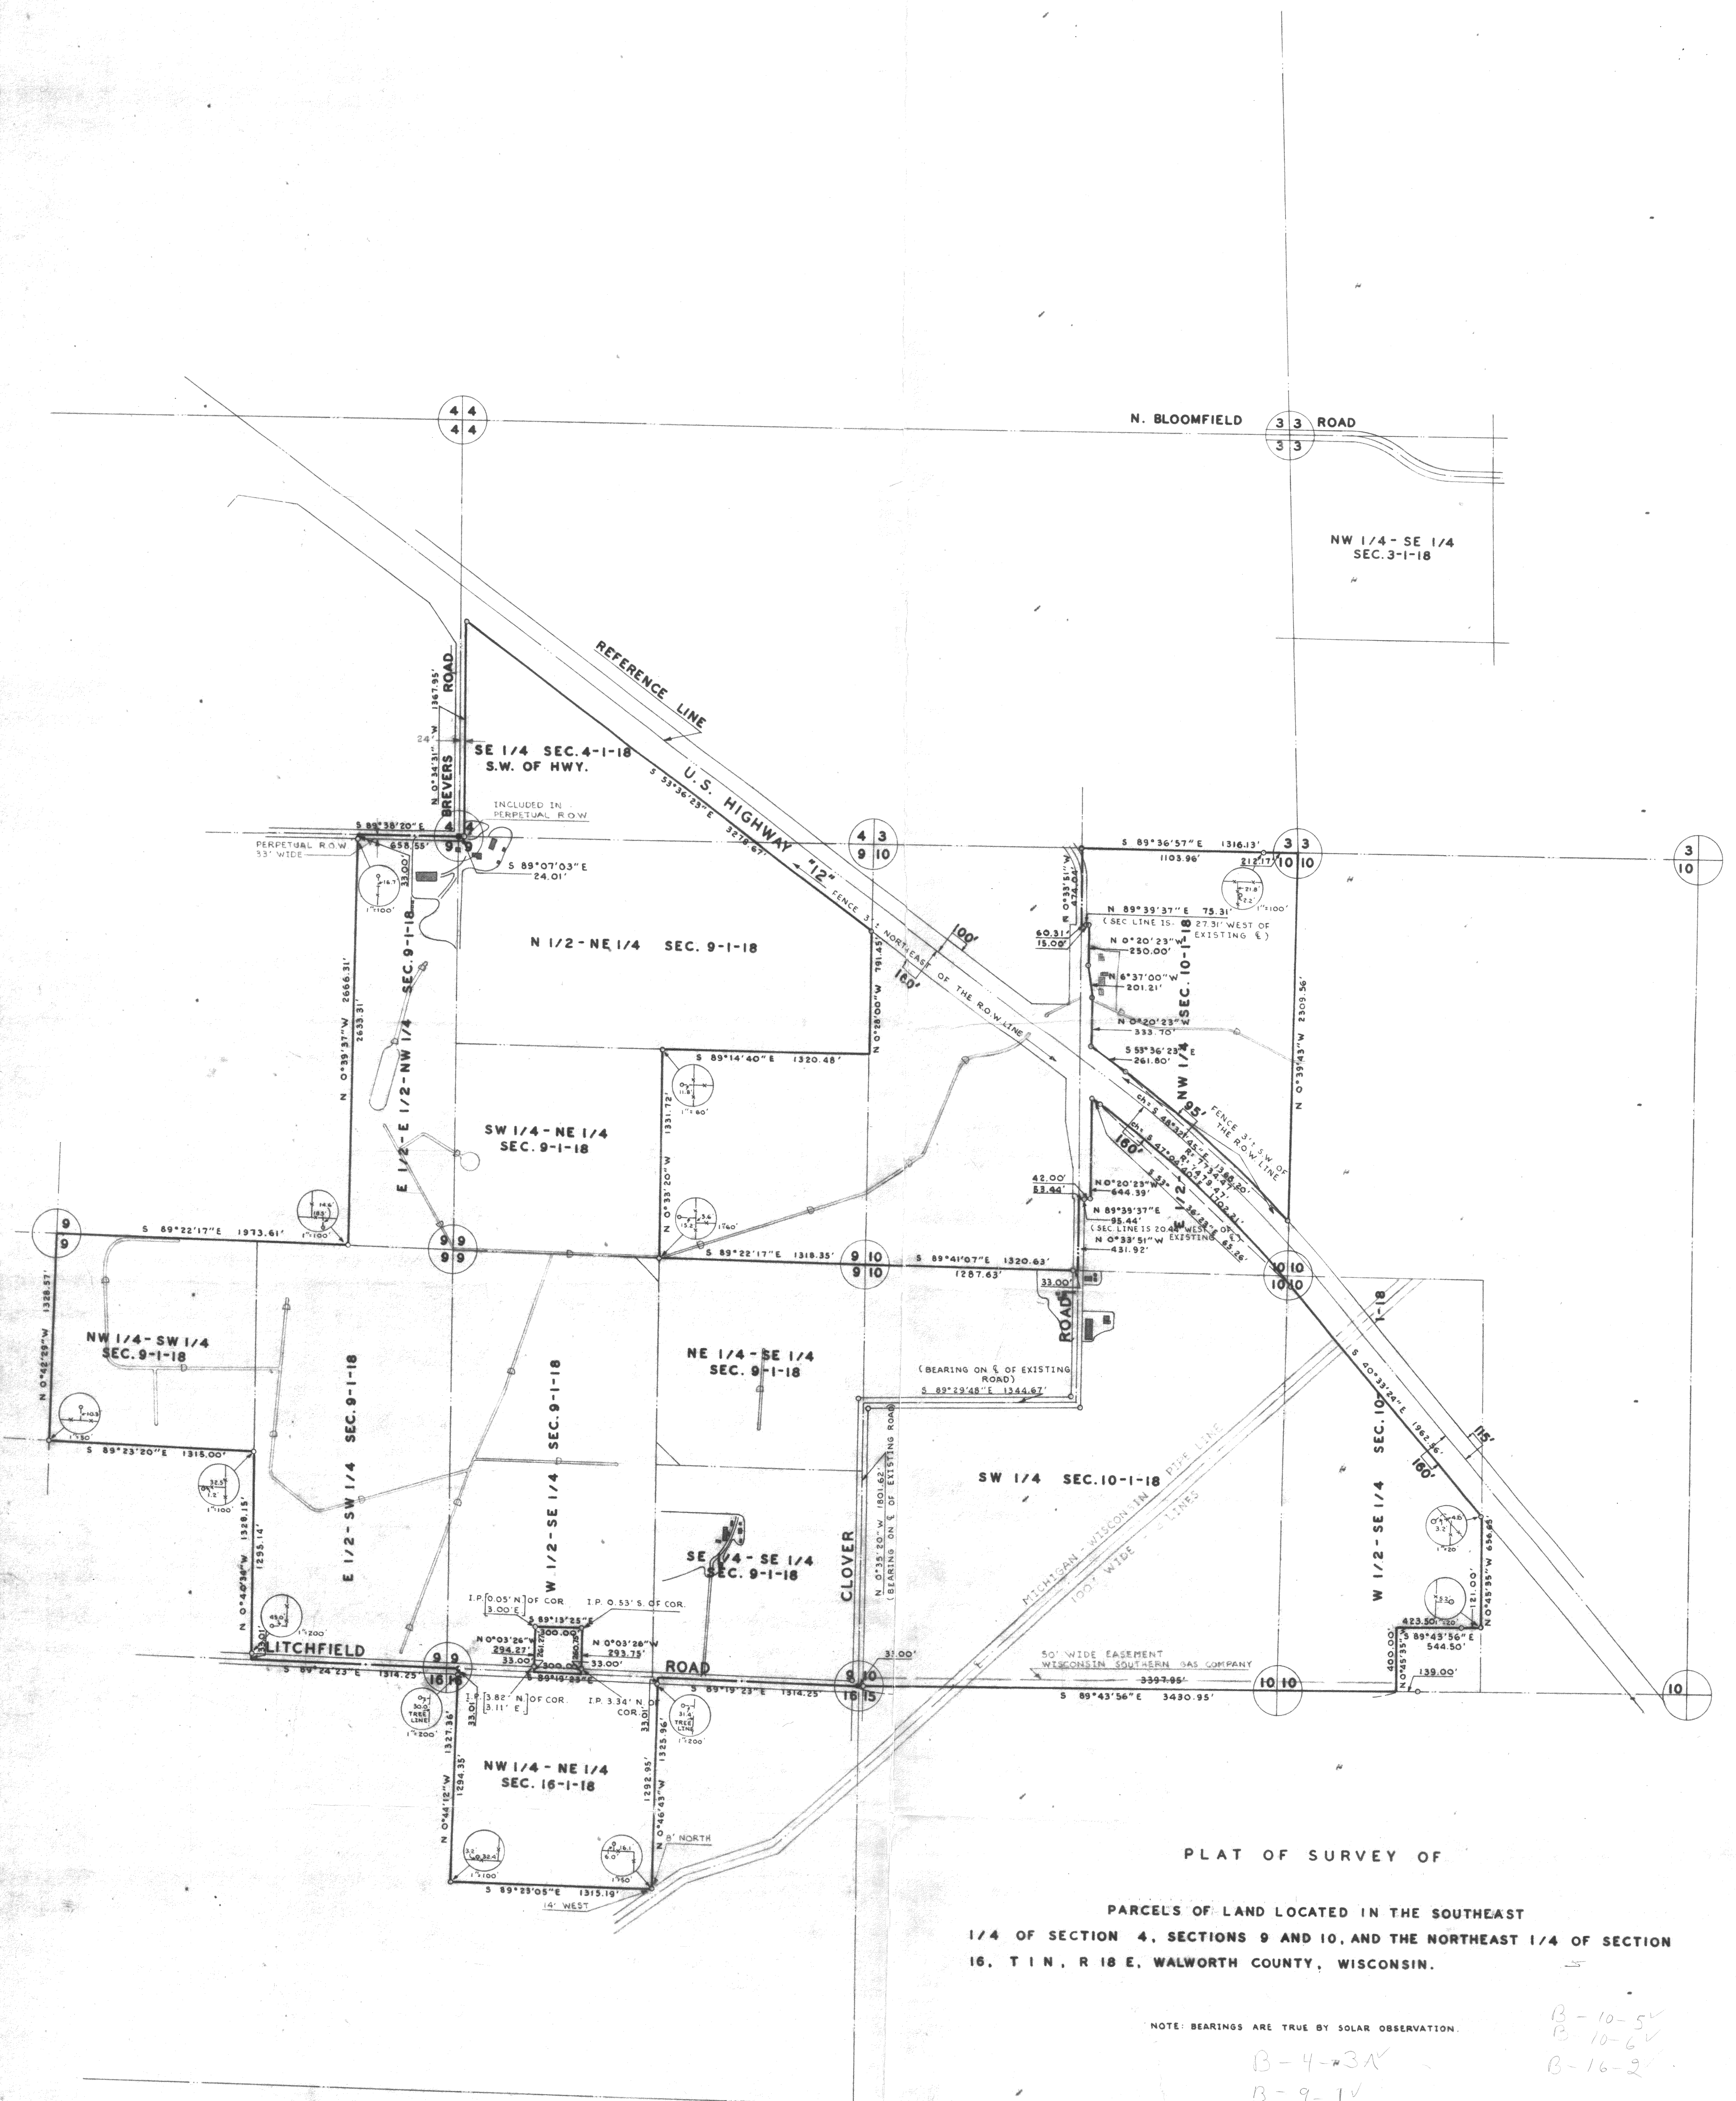

PLAT OF SURVEY OF

PARCELS OF LAND LOCATED IN THE SOUTHEAST
1/4 OF SECTION 4, SECTIONS 9 AND 10, AND THE NORTHEAST 1/4 OF SECTION
16, T. 1 N., R. 18 E., WALWORTH COUNTY, WISCONSIN.

NOTE: BEARINGS ARE TRUE BY SOLAR OBSERVATION.

B-4-3A
B-9-1V
B-9-3V
B-9-3A
B-9-5V
B-9-5A
B-9-7V

B-10-5V
B-10-6V
B-16-2V


AREA NORTH OF HIGHWAY "12" = 50.28 ACRES
AREA SOUTH OF HIGHWAY "12" = 736.14 ACRES

LEGEND

- DRAINAGE DITCH (AS SCALED FROM AERIAL PHOTOGRAPH)
- IRON PIPE PLACED
- CONCRETE MONUMENT
- FENCE LINE

NOTE: BUILDING LOCATIONS ARE FROM AERIAL PHOTOS,
EASEMENTS ARE FROM RECORDED DESCRIPTIONS
AND AERIAL PHOTOS.

N
SCALE: 1"=400'

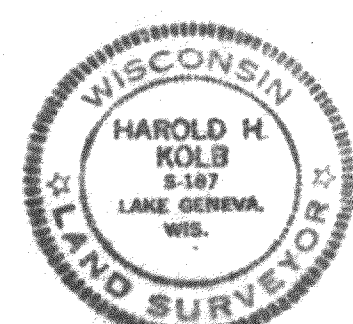

HAROLD H. KOLB
HAROLD H. KOLB, WIS. REG. SURVEYOR, S-187

DATE: Aug 10, 1975 (PRELIMINARY DRAWING)
REVISED: OCT. 15, 1975