


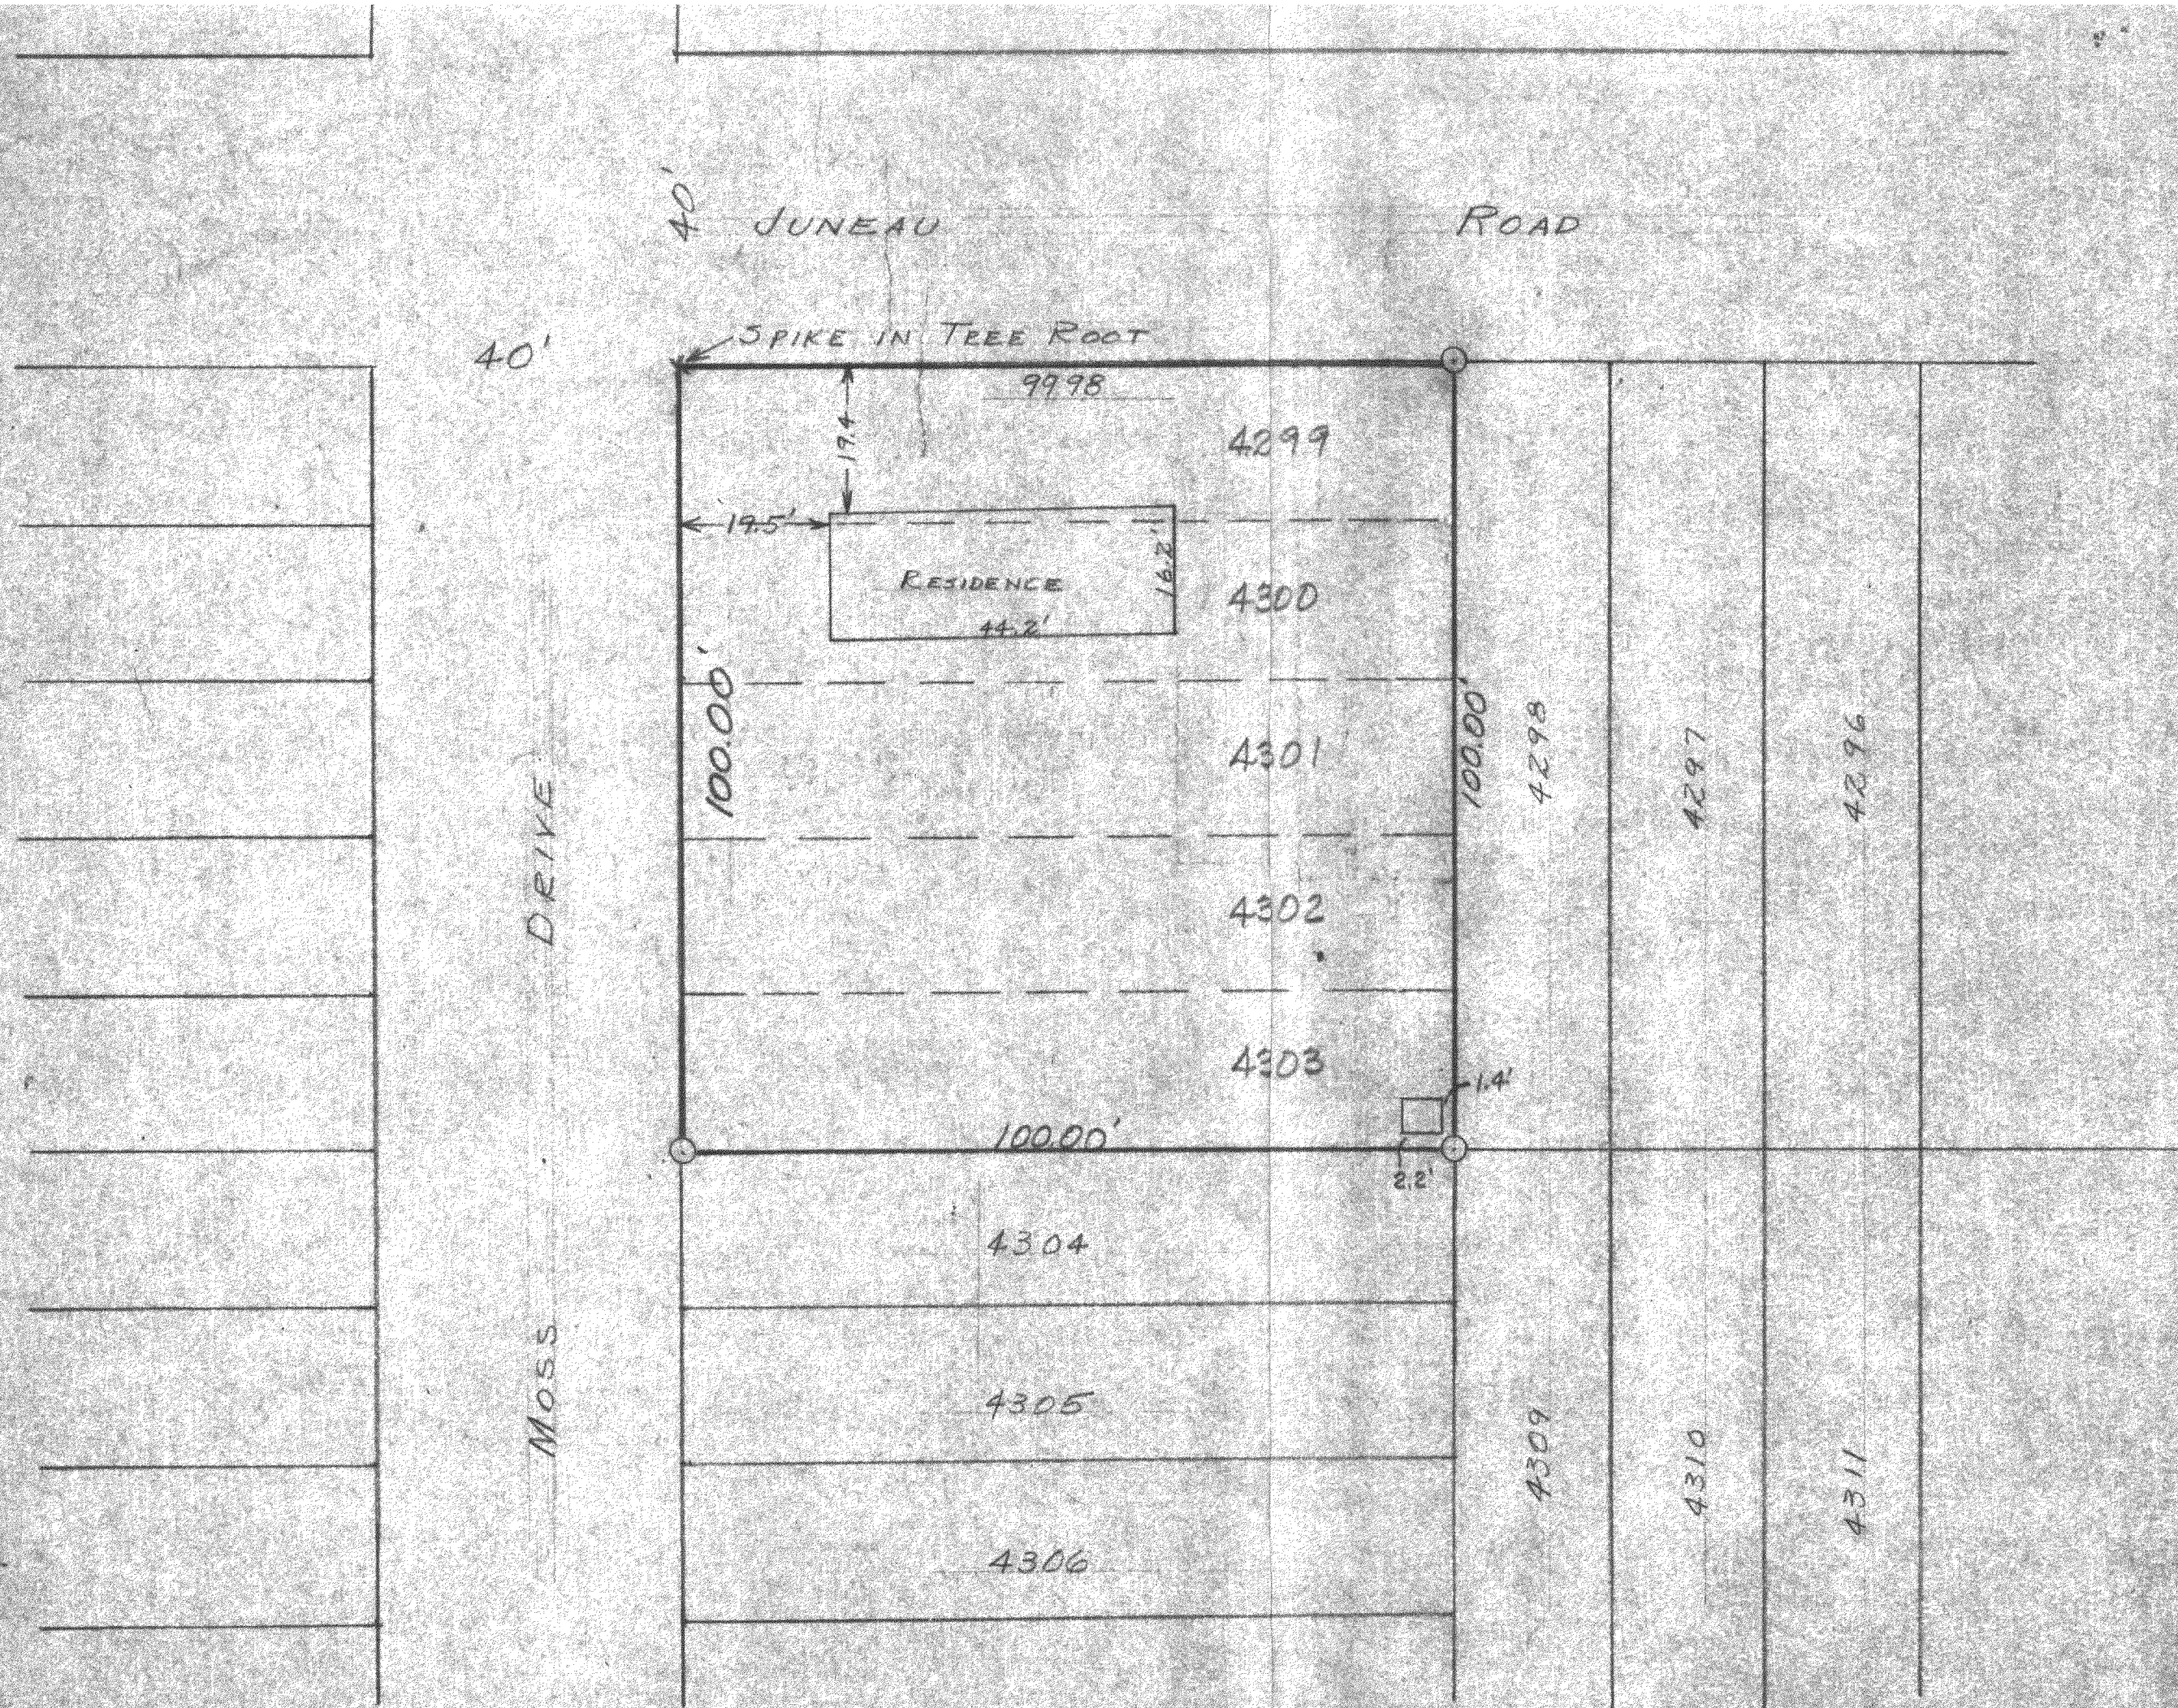

N

SCALE 1"=20'
O = IRON PIPE
X = 60# SPIKE

PLAT OF SURVEY OF LOTS 4299 TO 4306 INCLUSIVE BLOCK 85
PELL LAKE SUBDIVISION, WALWORTH COUNTY, WISCONSIN.

JUNE 1952

Lloyd S. Jensen
COUNTY SURVEYOR

118-42.1