
DUNHAM & RASMUSSEN
SURVEYING & ENGINEERING
DELAVAN, WISCONSIN

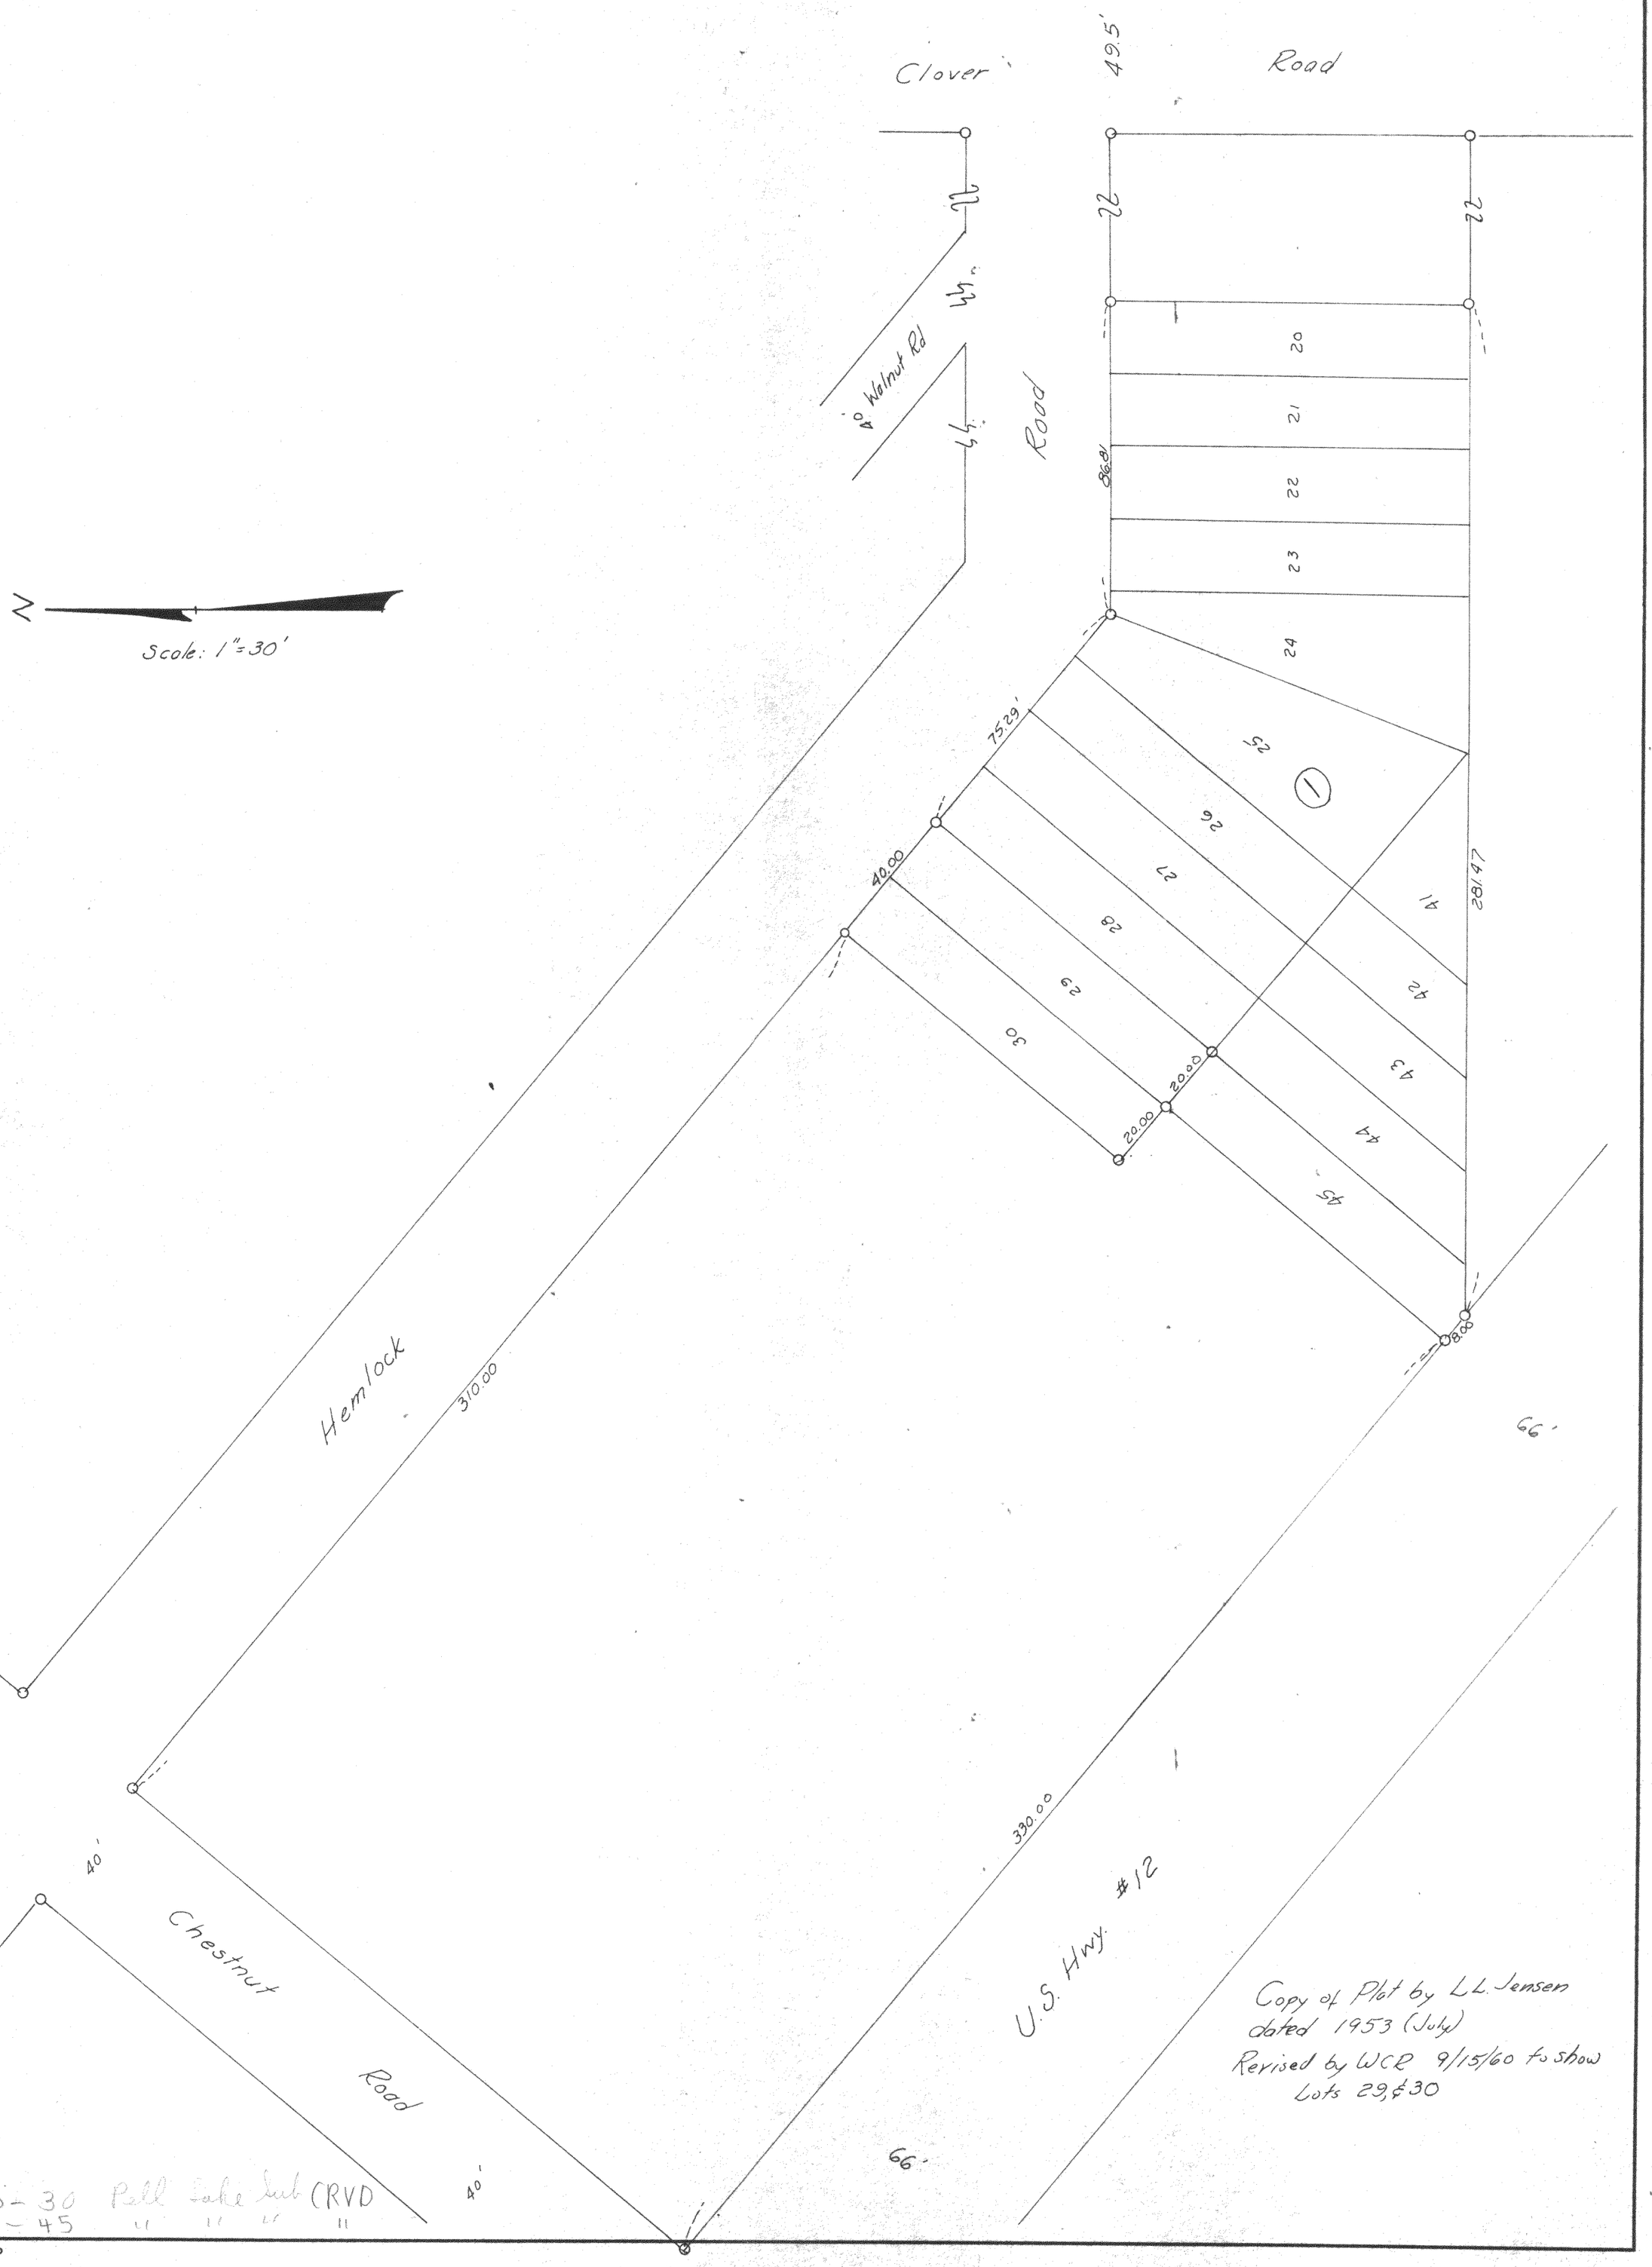

Copy of Plat by L.L. Jensen
dated 1953 (July)
Revised by WCR 9/15/60 to show
Lots 29 & 30

Lots 20-30 Pell Lake Sub (RVD
" 41-45 " " " "

K & E—195L 250-4-60

118-47