# HAROLD H. KOLB

REGISTERED PROFESSIONAL LAND SURVEYOR
LAKE GENEVA, WISCONSIN

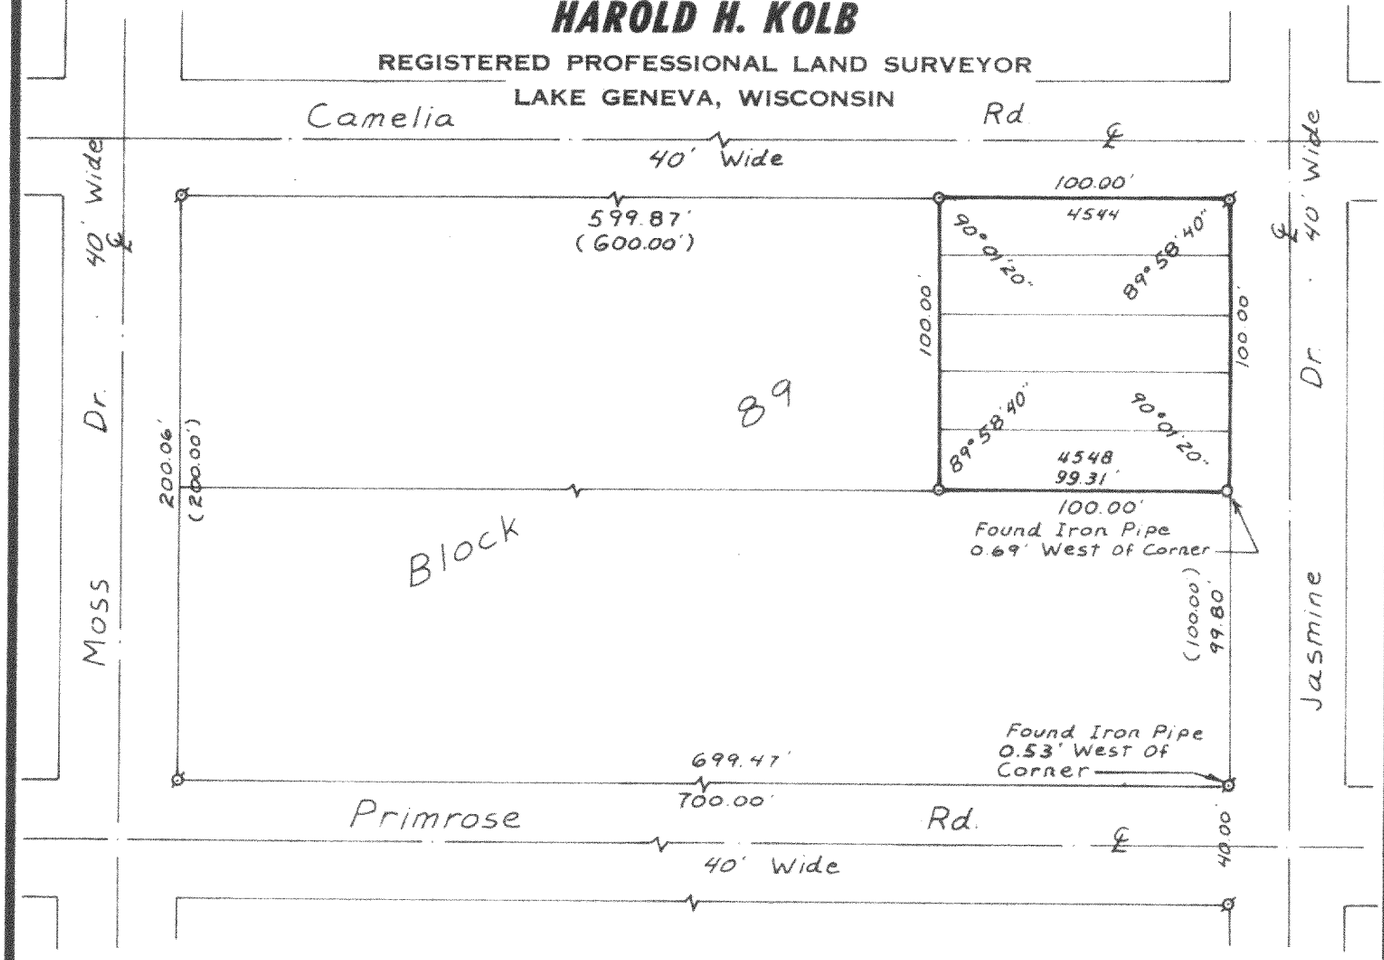


PLAT OF SURVEY OF

LOTS 4544-4548, BLOCK 89, PELL LAKE SUBDIVISION, SECTION 3, T1N, R18E, WALWORTH COUNTY, WISCONSIN.

ORDERED BY: MARY JARESKO

ACCURACY: DISTANCES ± 0.01'
ANGLES ± 05"
ERROR OF CLOSURE--LESS THAN ONE PART IN 3000.

N

Scale · 1"=60'

**LEGEND**

- ϕ — IRON PIPE FOUND
- O — IRON PIPE PLACED
- ● — CONCRETE MONUMENT
- X — SPIKE
- ( ) - As Platted

WISCONSIN
HAROLD H. KOLB
S-187
LAKE GENEVA, WIS.
LAND SURVEYOR

**I. HAROLD H. KOLB, DO HEREBY CERTIFY THAT I HAVE SURVEYED THE PROPERTY HEREON DESCRIBED ACCORDING TO THE OFFICIAL RECORDS, AND THAT THE PLAT HEREON IS A CORRECT REPRESENTATION OF THE LOT LINES.**

Harold H. Kolb

**HAROLD H. KOLB**
**WISCONSIN REGISTERED LAND SURVEYOR, S-187**
**DATE** Sept. 1, 1976

118-560

BRUNING 40-105 1M-6-71