KOLB LAND CONSULTING, INC.

LAND SURVEYING · SUBDIVIDING · LAND PLANNING

LAKE GENEVA, WISCONSIN 53147 WHITEWATER, WISCONSIN 53190

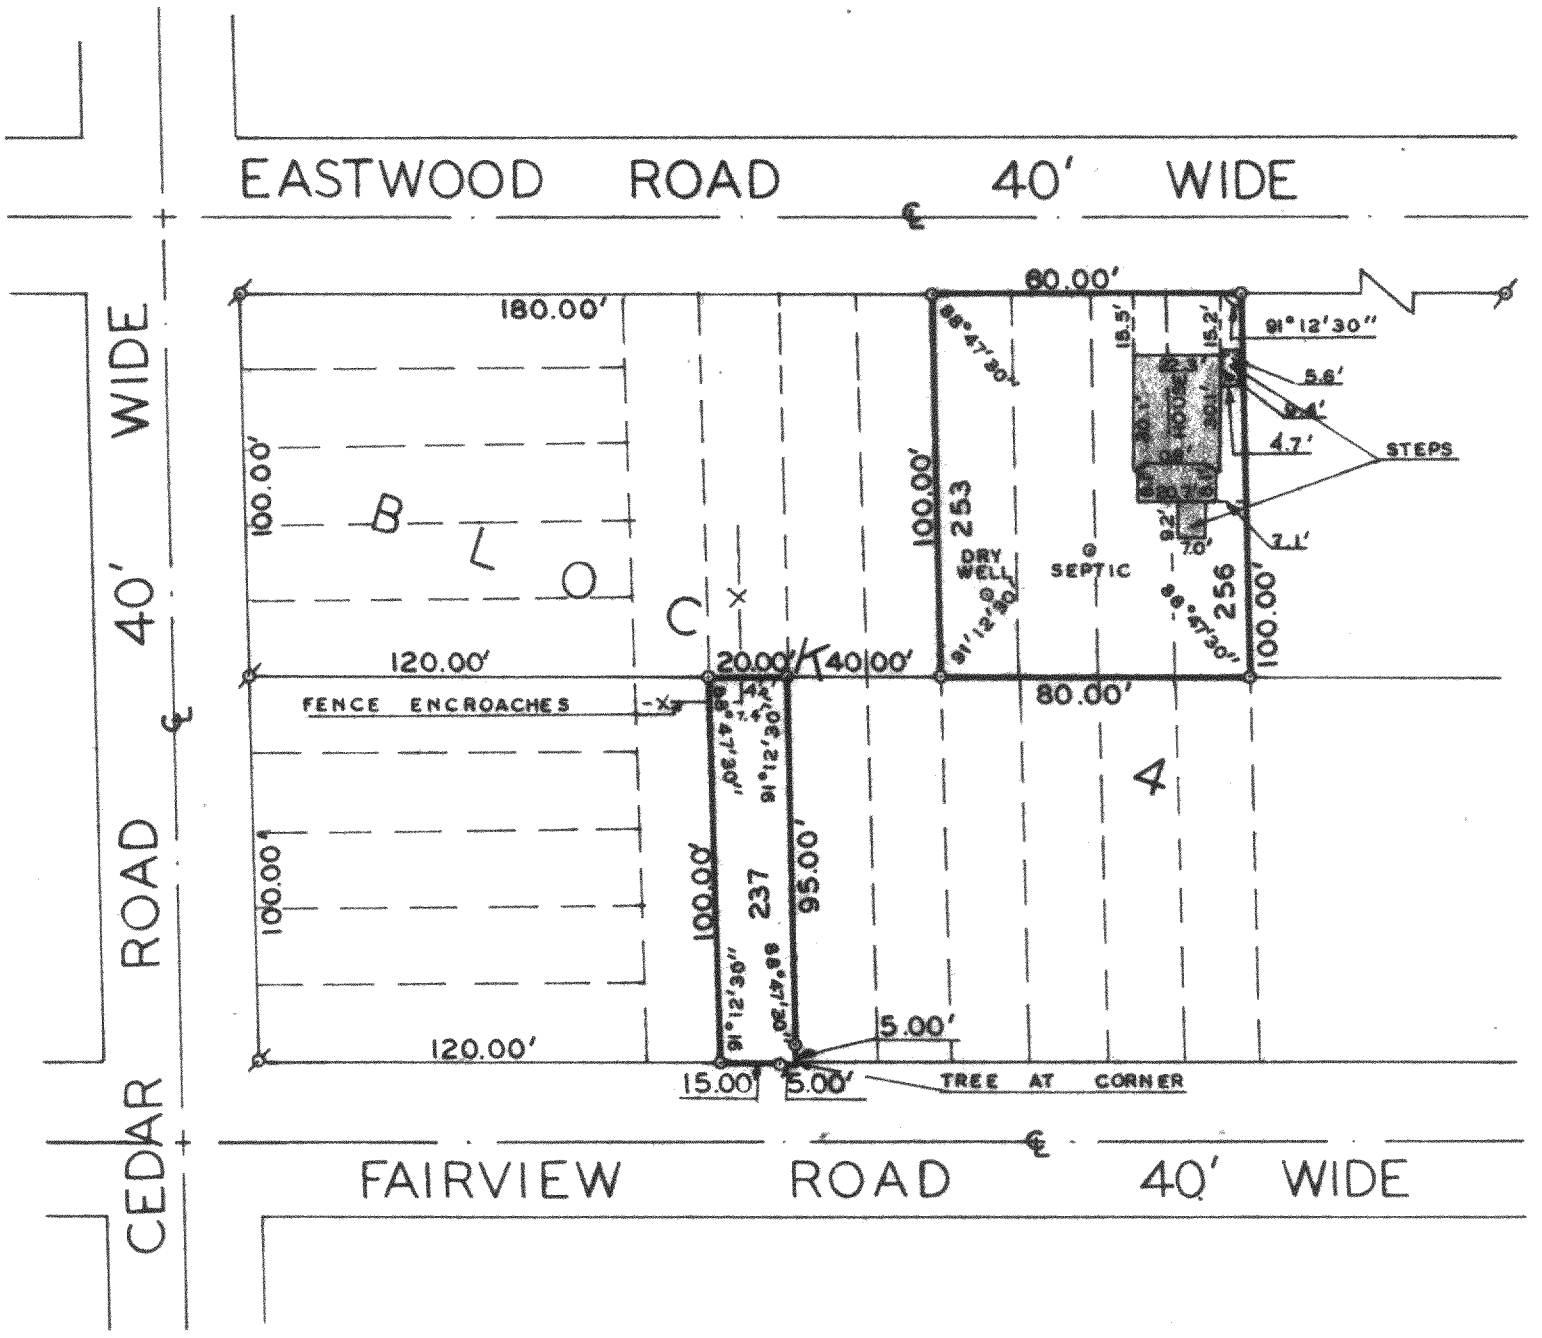

PLAT OF SURVEY OF

LOT 237, AND 253-256, BLOCK 4,
PELL LAKE HIGHLANDS, WALWORTH
COUNTY, WISCONSIN.

ORDERED BY: JAN SPENCER
BAY REALTY
9 GENEVA STREET
WILLIAMS BAY, WI 53191

0 20 40
10 30 50
SCALE IN FEET

LEGEND

⌀ - IRON PIPE FOUND
o - IRON PIPE PLACED

WISCONSIN
ROBERT M. BAERENWALD
Lake Geneva, WI.
S-1508
LAND SURVEYOR

MP LH-53
55

I, ROBERT M. BAERENWALD, DO HEREBY CERTIFY THAT I HAVE SURVEYED THE PROPERTY HEREON DESCRIBED ACCORDING TO THE OFFICIAL RECORDS, AND THAT THE PLAT HEREON IS A CORRECT REPRESENTATION OF THE LOT LINES TO THE BEST OF MY KNOWLEDGE AND BELIEF.

Robert M. Baerenwald
ROBERT M. BAERENWALD
WISCONSIN REGISTERED LAND SURVEYOR, S-1508
DATE July 12, 1979

118-583K