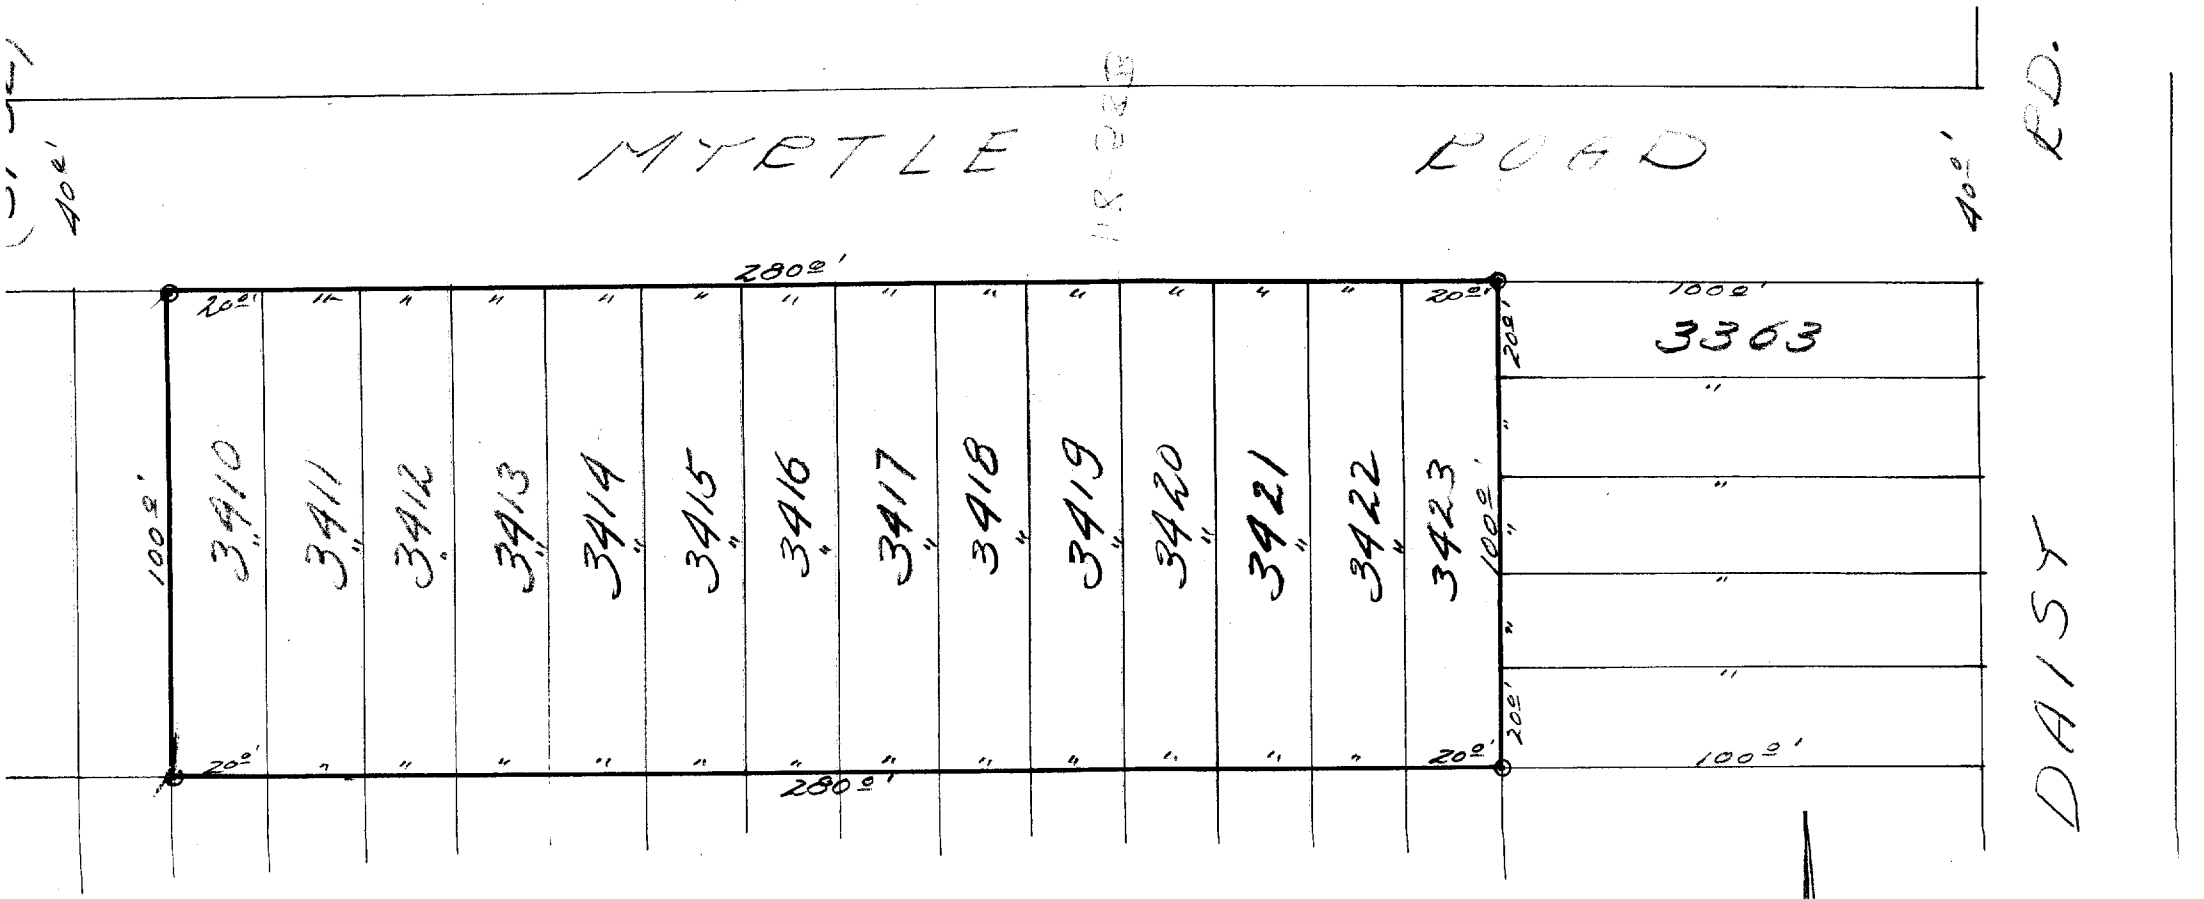


DESCRIPTION:

Lots 3410 to 3423 inclusive Section 3 of Pell Lake Subdivision of a portion Section 15, Town 1, north, Range 18 east of the 4th Principal Meridian.

CERTIFICATE:

I, hereby certify that I have on this the 7th day of June 1951, surveyed the above described property, according to the official records on file in the office of the Recorder of Deeds in and for Walworth County, Wisconsin, and find that the measurements and bearings of the boundary lines of said property as taken at the site on this day, substantially agree with thos e in said official plat and that no encroachments exist.

SIGNED AND SEALED AN THIS THE 8TH DAY OF JUNE 1951.

Joseph M. Biagi. Professional Engineer.
Elkhorn Wisconsin.

118-583