FARRIS, HANSEN & COOPER, INC.

ENGINEERING, SURVEYING AND LAND PLANNING

715 W. WALWORTH ST. - P.O. BOX 487 - ELKHORN, WI 53121

OFFICE: 414/723-2098

PLAT OF SURVEY OF LOTS 11, 12, 13, & 14 OF SITTERLE'S SUBDIVISION, BEING A SUBDIVISION LOCATED IN T. 1 N., R. 18 E., TOWN OF BLOOMFIELD, WALWORTH COUNTY, WISCONSIN

SELLER: SAWERTALIO
BUYER: SWINFORD

WORK ORDERED BY: BAY REALTY, WILLIAMS BAY, WISCONSIN


I hereby certify that I have surveyed the above described property and that the above map is a true representation thereof and shows the size and location of the property, its exterior boundaries, the location of all visible structures and dimensions of all principal buildings thereon, boundary fences, apparent easements, roadways and visible encroachments, if any.

This survey is made for the use of the present owners of the property, and also those who purchase, mortgage, or guarantee the title thereto within one (1) year from date hereof.

Robert A. Farris

DATED 11 JAN. 1979

WISCONSIN
ROBERT A. FARRIS
S-1293
ELKHORN, WIS.
LAND SURVEYOR

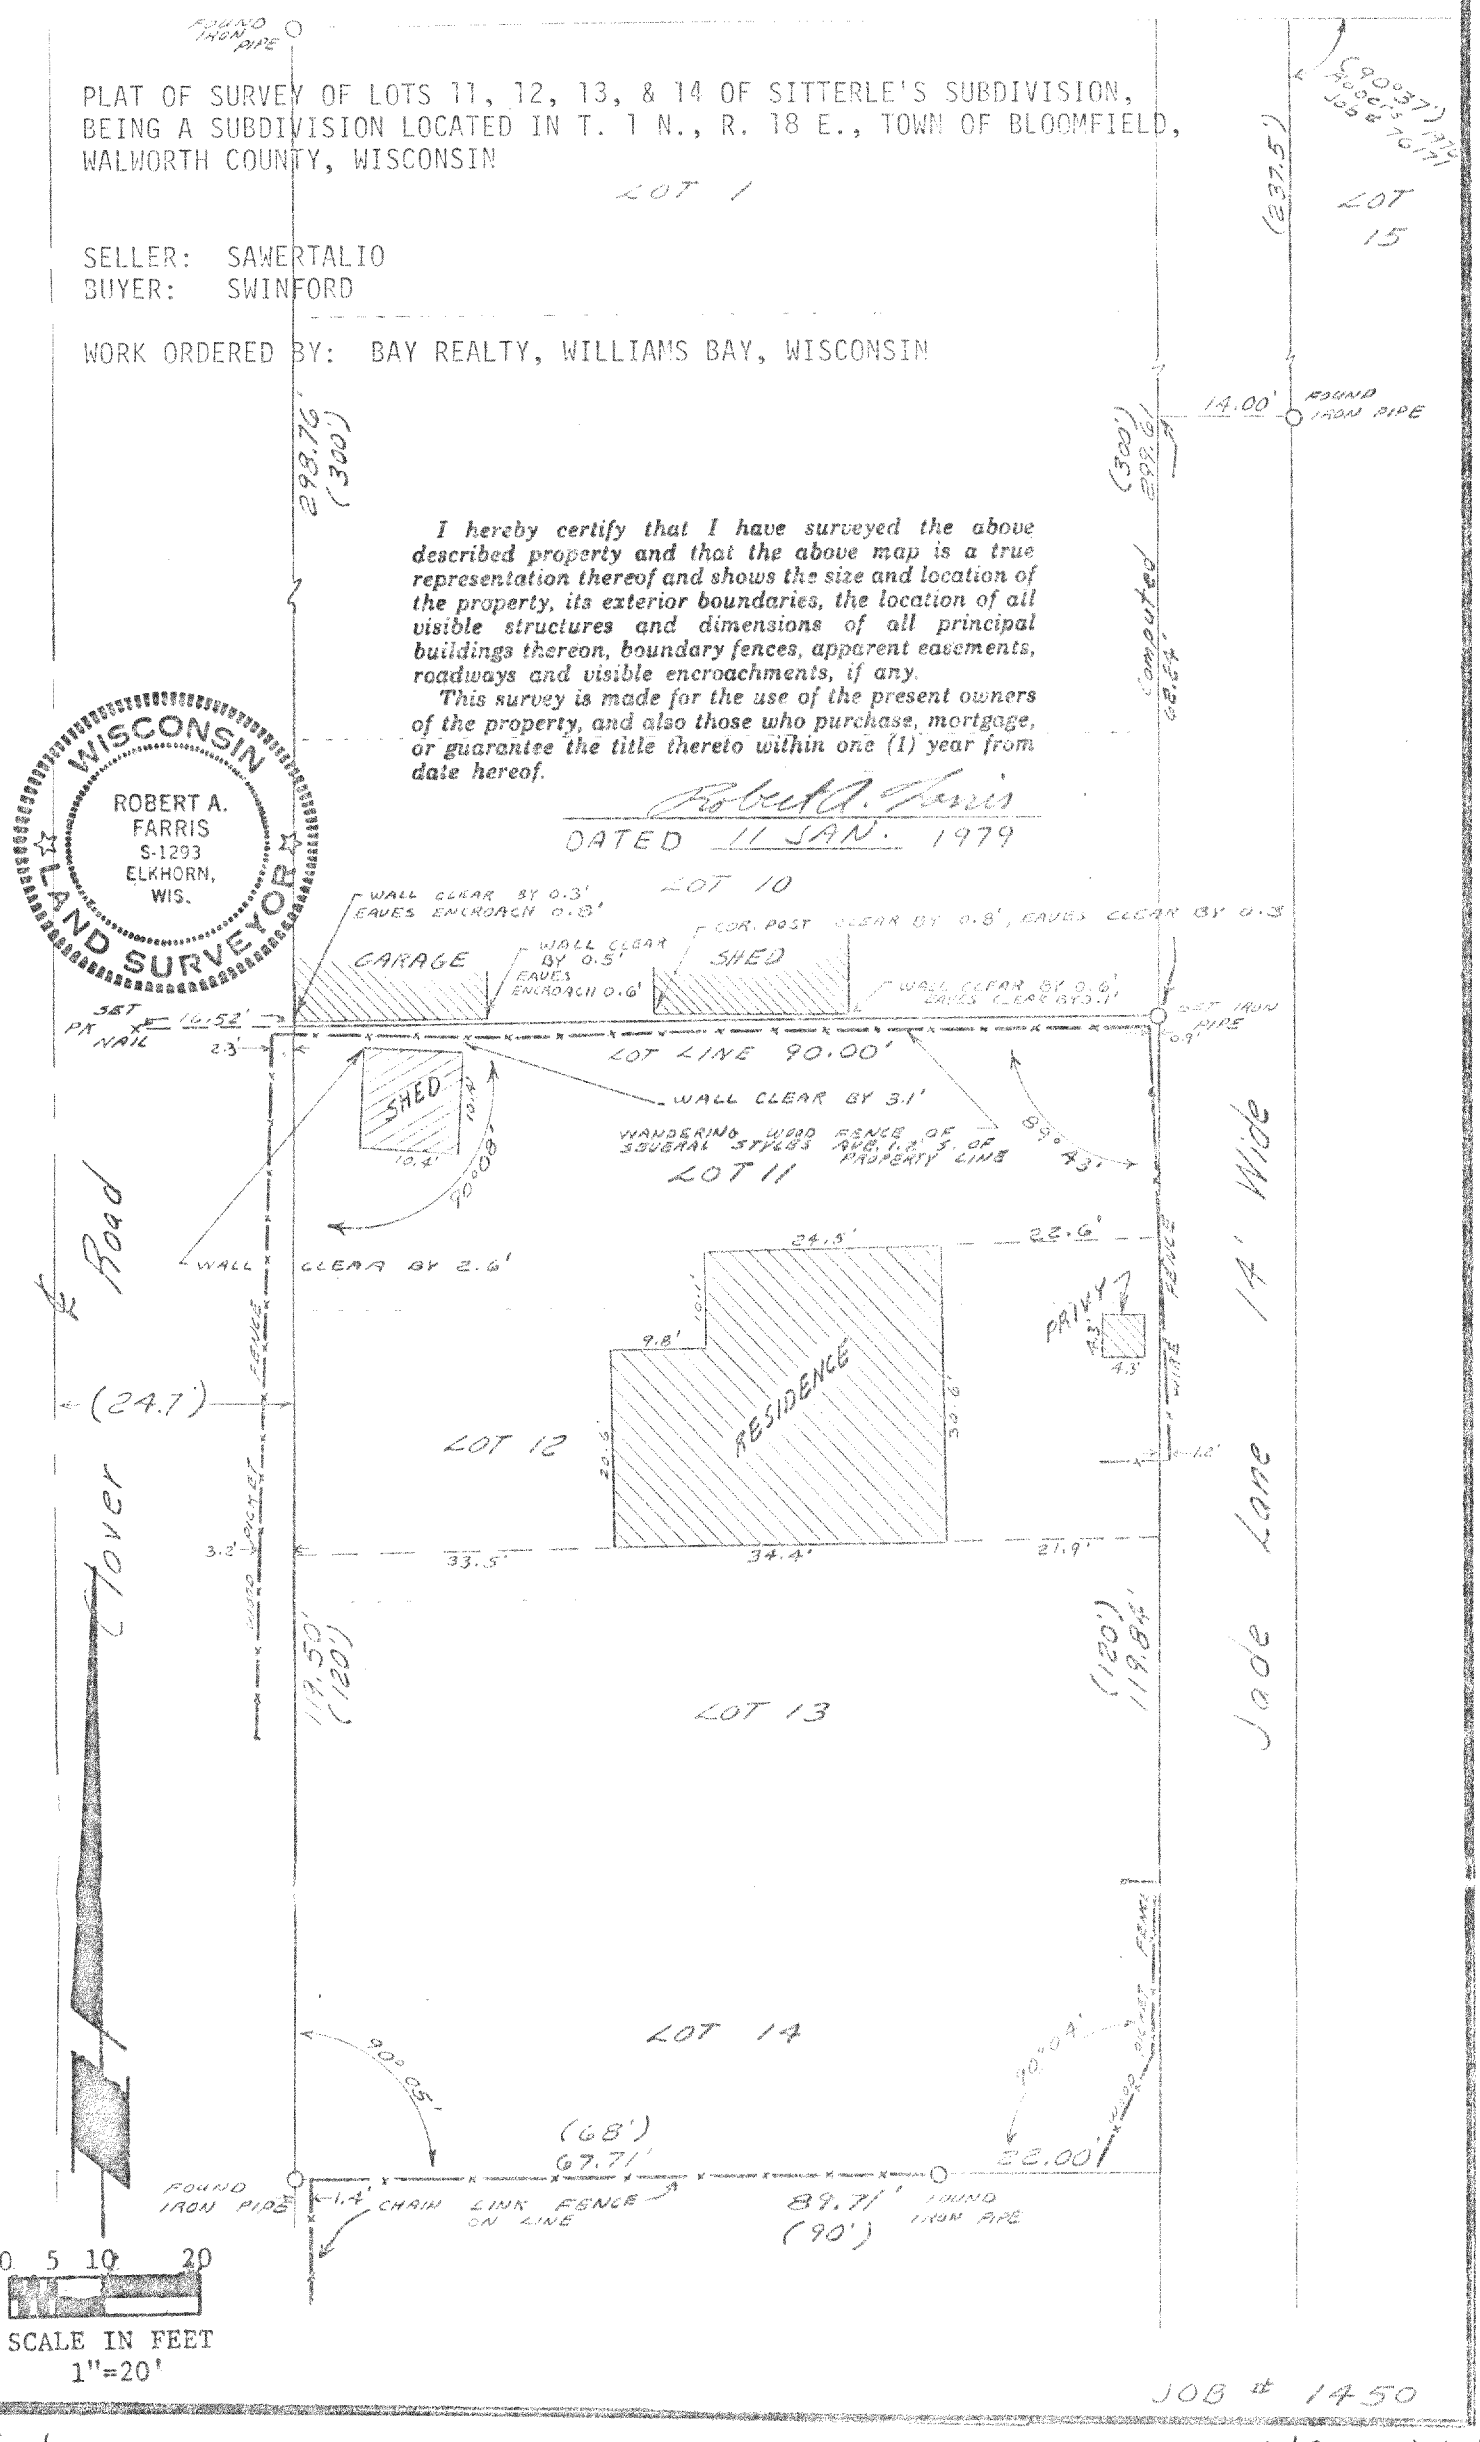

JOB # 1450

MS-6

118-606F