
50-28

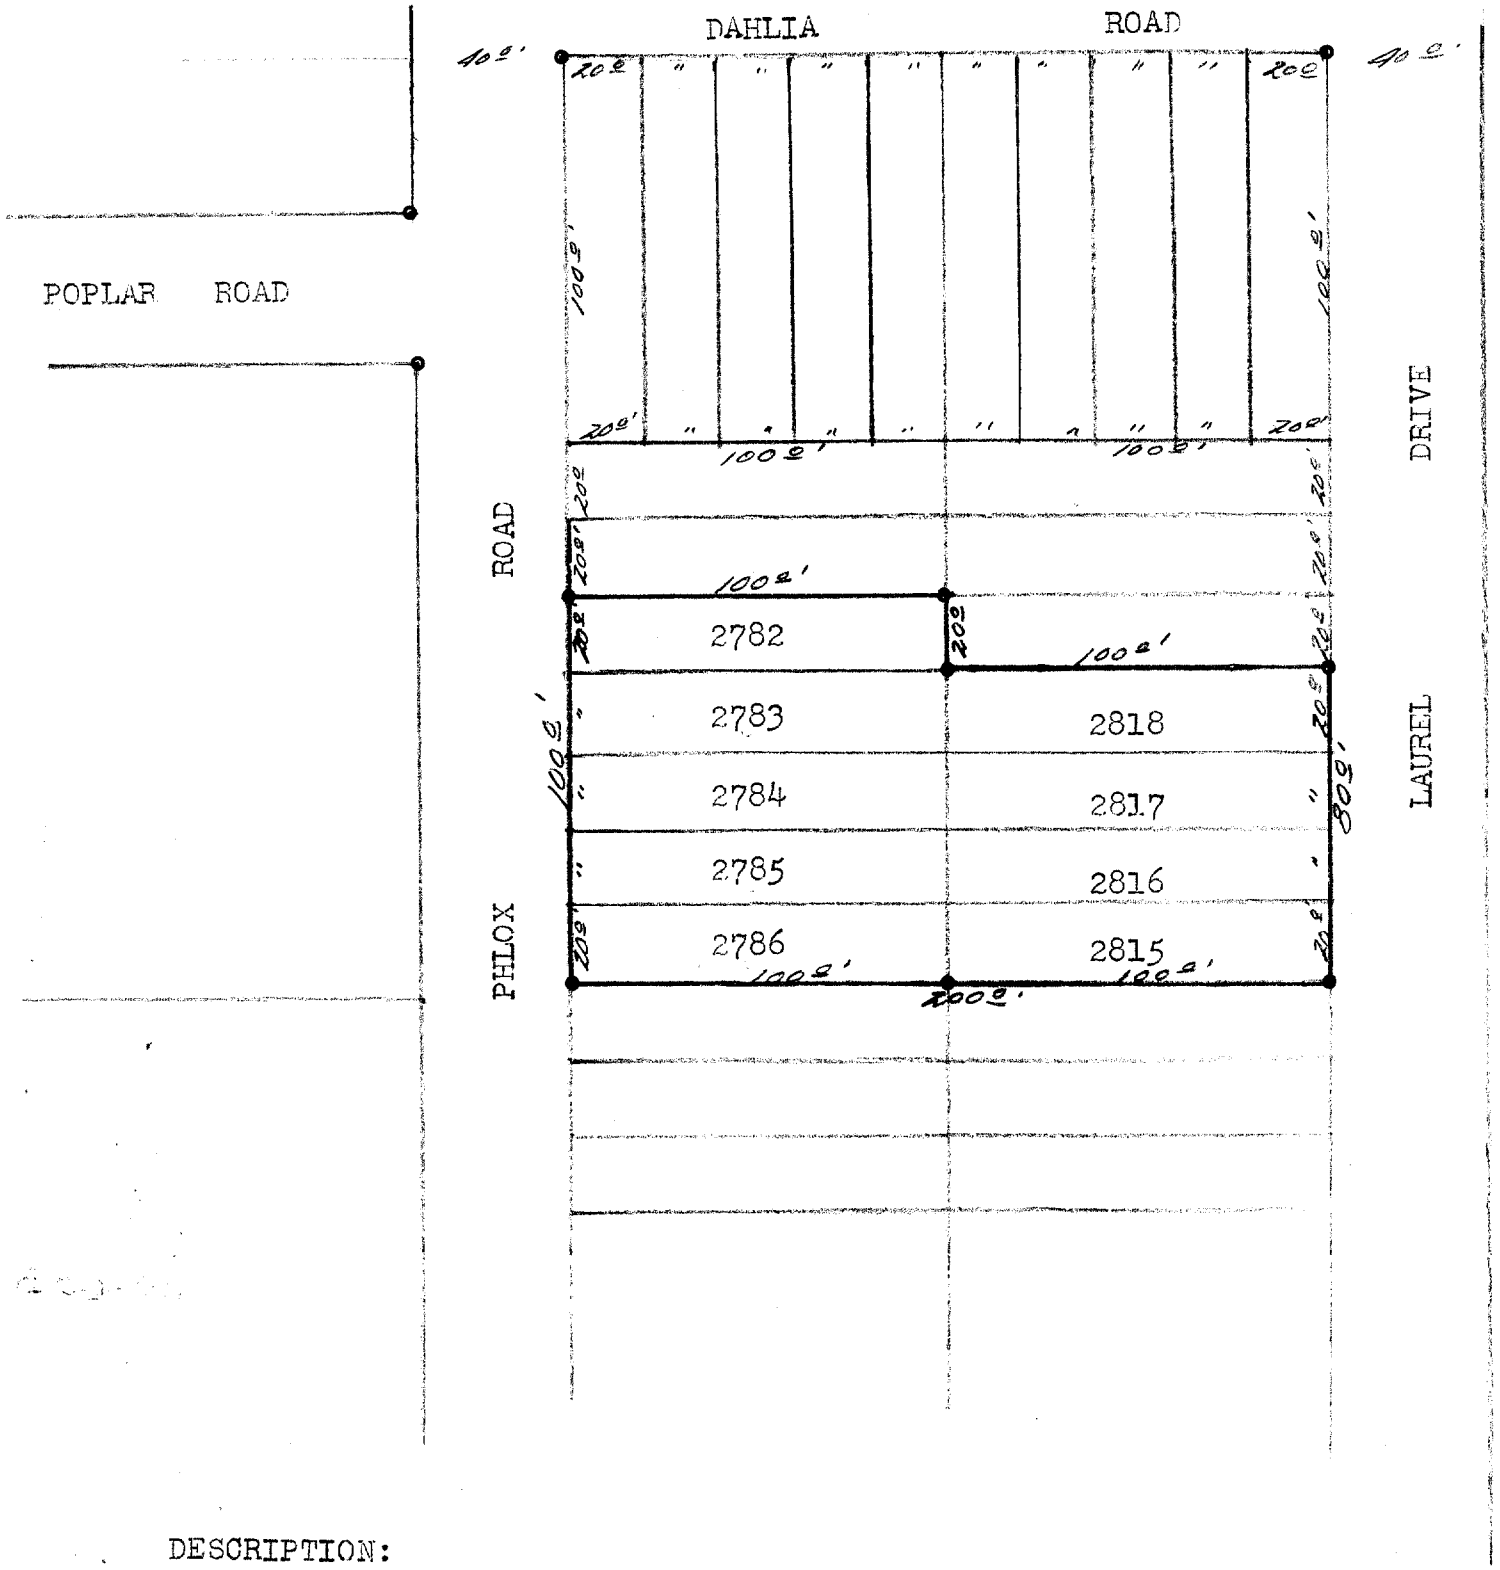

DESCRIPTION:

Lots 2782, 2783, 2784, 2785, 2786, 2815, 2816, 2817 and 2818 of Section 2, Pell Lake, Town of Bloomfield, Walworth County, Wisconsin.

CERTIFICATE:

I, hereby certify that I, have on this the 17th day of October 1950, surveyed the above described property, according to the official records on file in the office of the Recorder of Deeds in and for Walworth County, Wisconsin, and find that the measurements and bearings of the boundary lines of said property as taken at the site on this day, substantially agree with those in said official record and that no encroachments exist. SIGNED AND SEALED ON THIS THE 17TH DAY OF OCTOBER 1950.

Joseph M. Biagi. Professional Eng'r.
Elkhorn Wisconsin.

118-60B