












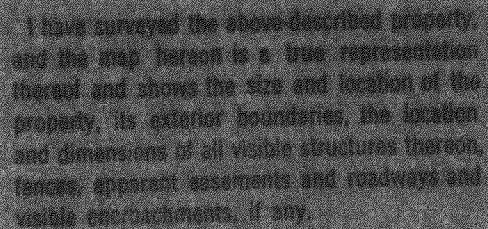

This survey is made for the exclusive use of the present owners of the property, and also those who purchase, mortgage, or guarantee the title thereto, within one year from date hereof.

Dated at Burlington, this 9th day
of November 1979

John F. Dogan, Land Surveyor 3 242

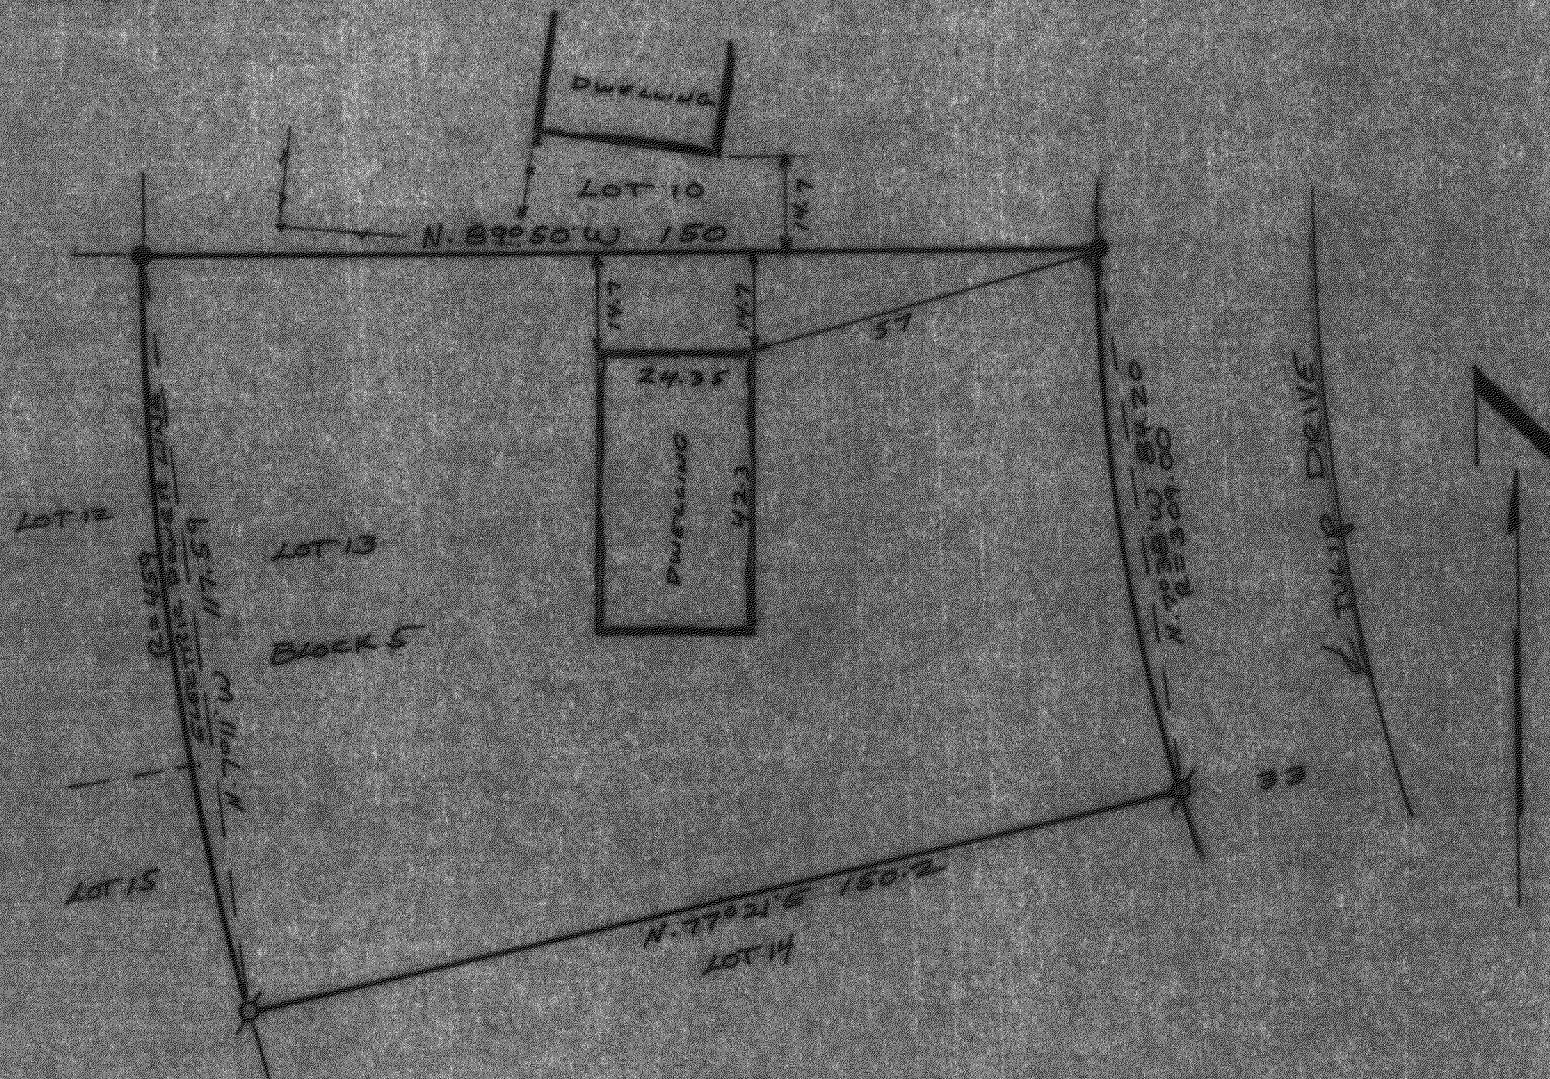

MR 6-47

118-614 DRAWER 4-E-3