
FARRIS, HANSEN & COOPER, INC.
ENGINEERING, SURVEYING AND LAND PLANNING
715 W. WALWORTH ST. - P.O. BOX 487 - ELKHORN, WI 53121

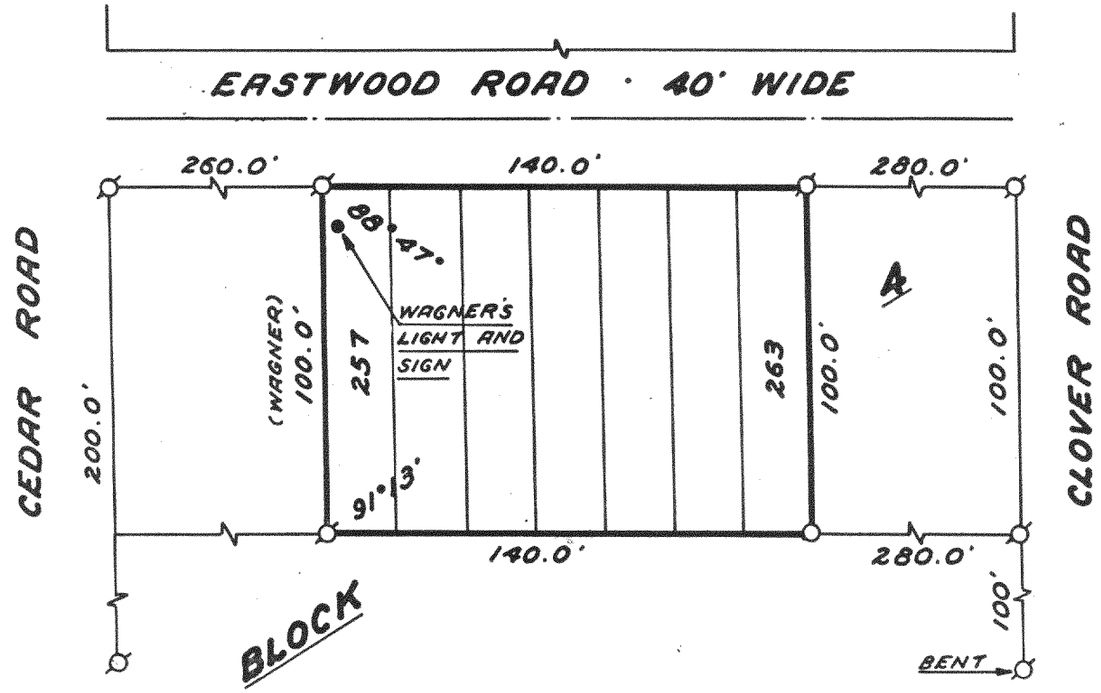

PLAT OF SURVEY OF

Lots 257-263, Block 4, Pell Lake Highlands, Town 1 North, Range 18 East, Town of Bloomfield, Walworth County, Wisconsin.

ORDERED BY: Jan Spencer
Bay Realty

OWNER: Albert Herrmann

BUYER: Boguslaw Zlotek

LEGEND

⌀—Iron Pipe Found


○—1" x 24" Iron Pipe Set

I HEREBY CERTIFY that I have surveyed the property described hereon and that this Plat of Survey is a true and accurate representation of the lot lines to the best of my professional knowledge and belief.

Robert A. Farris

Robert A. Farris, RLS No. 1293

Dated this 26 day of July 1979.

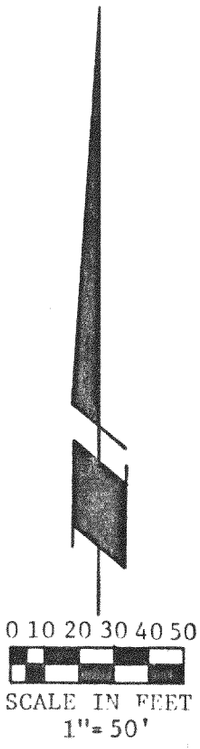



PROJ. NO. 1563

118-615F