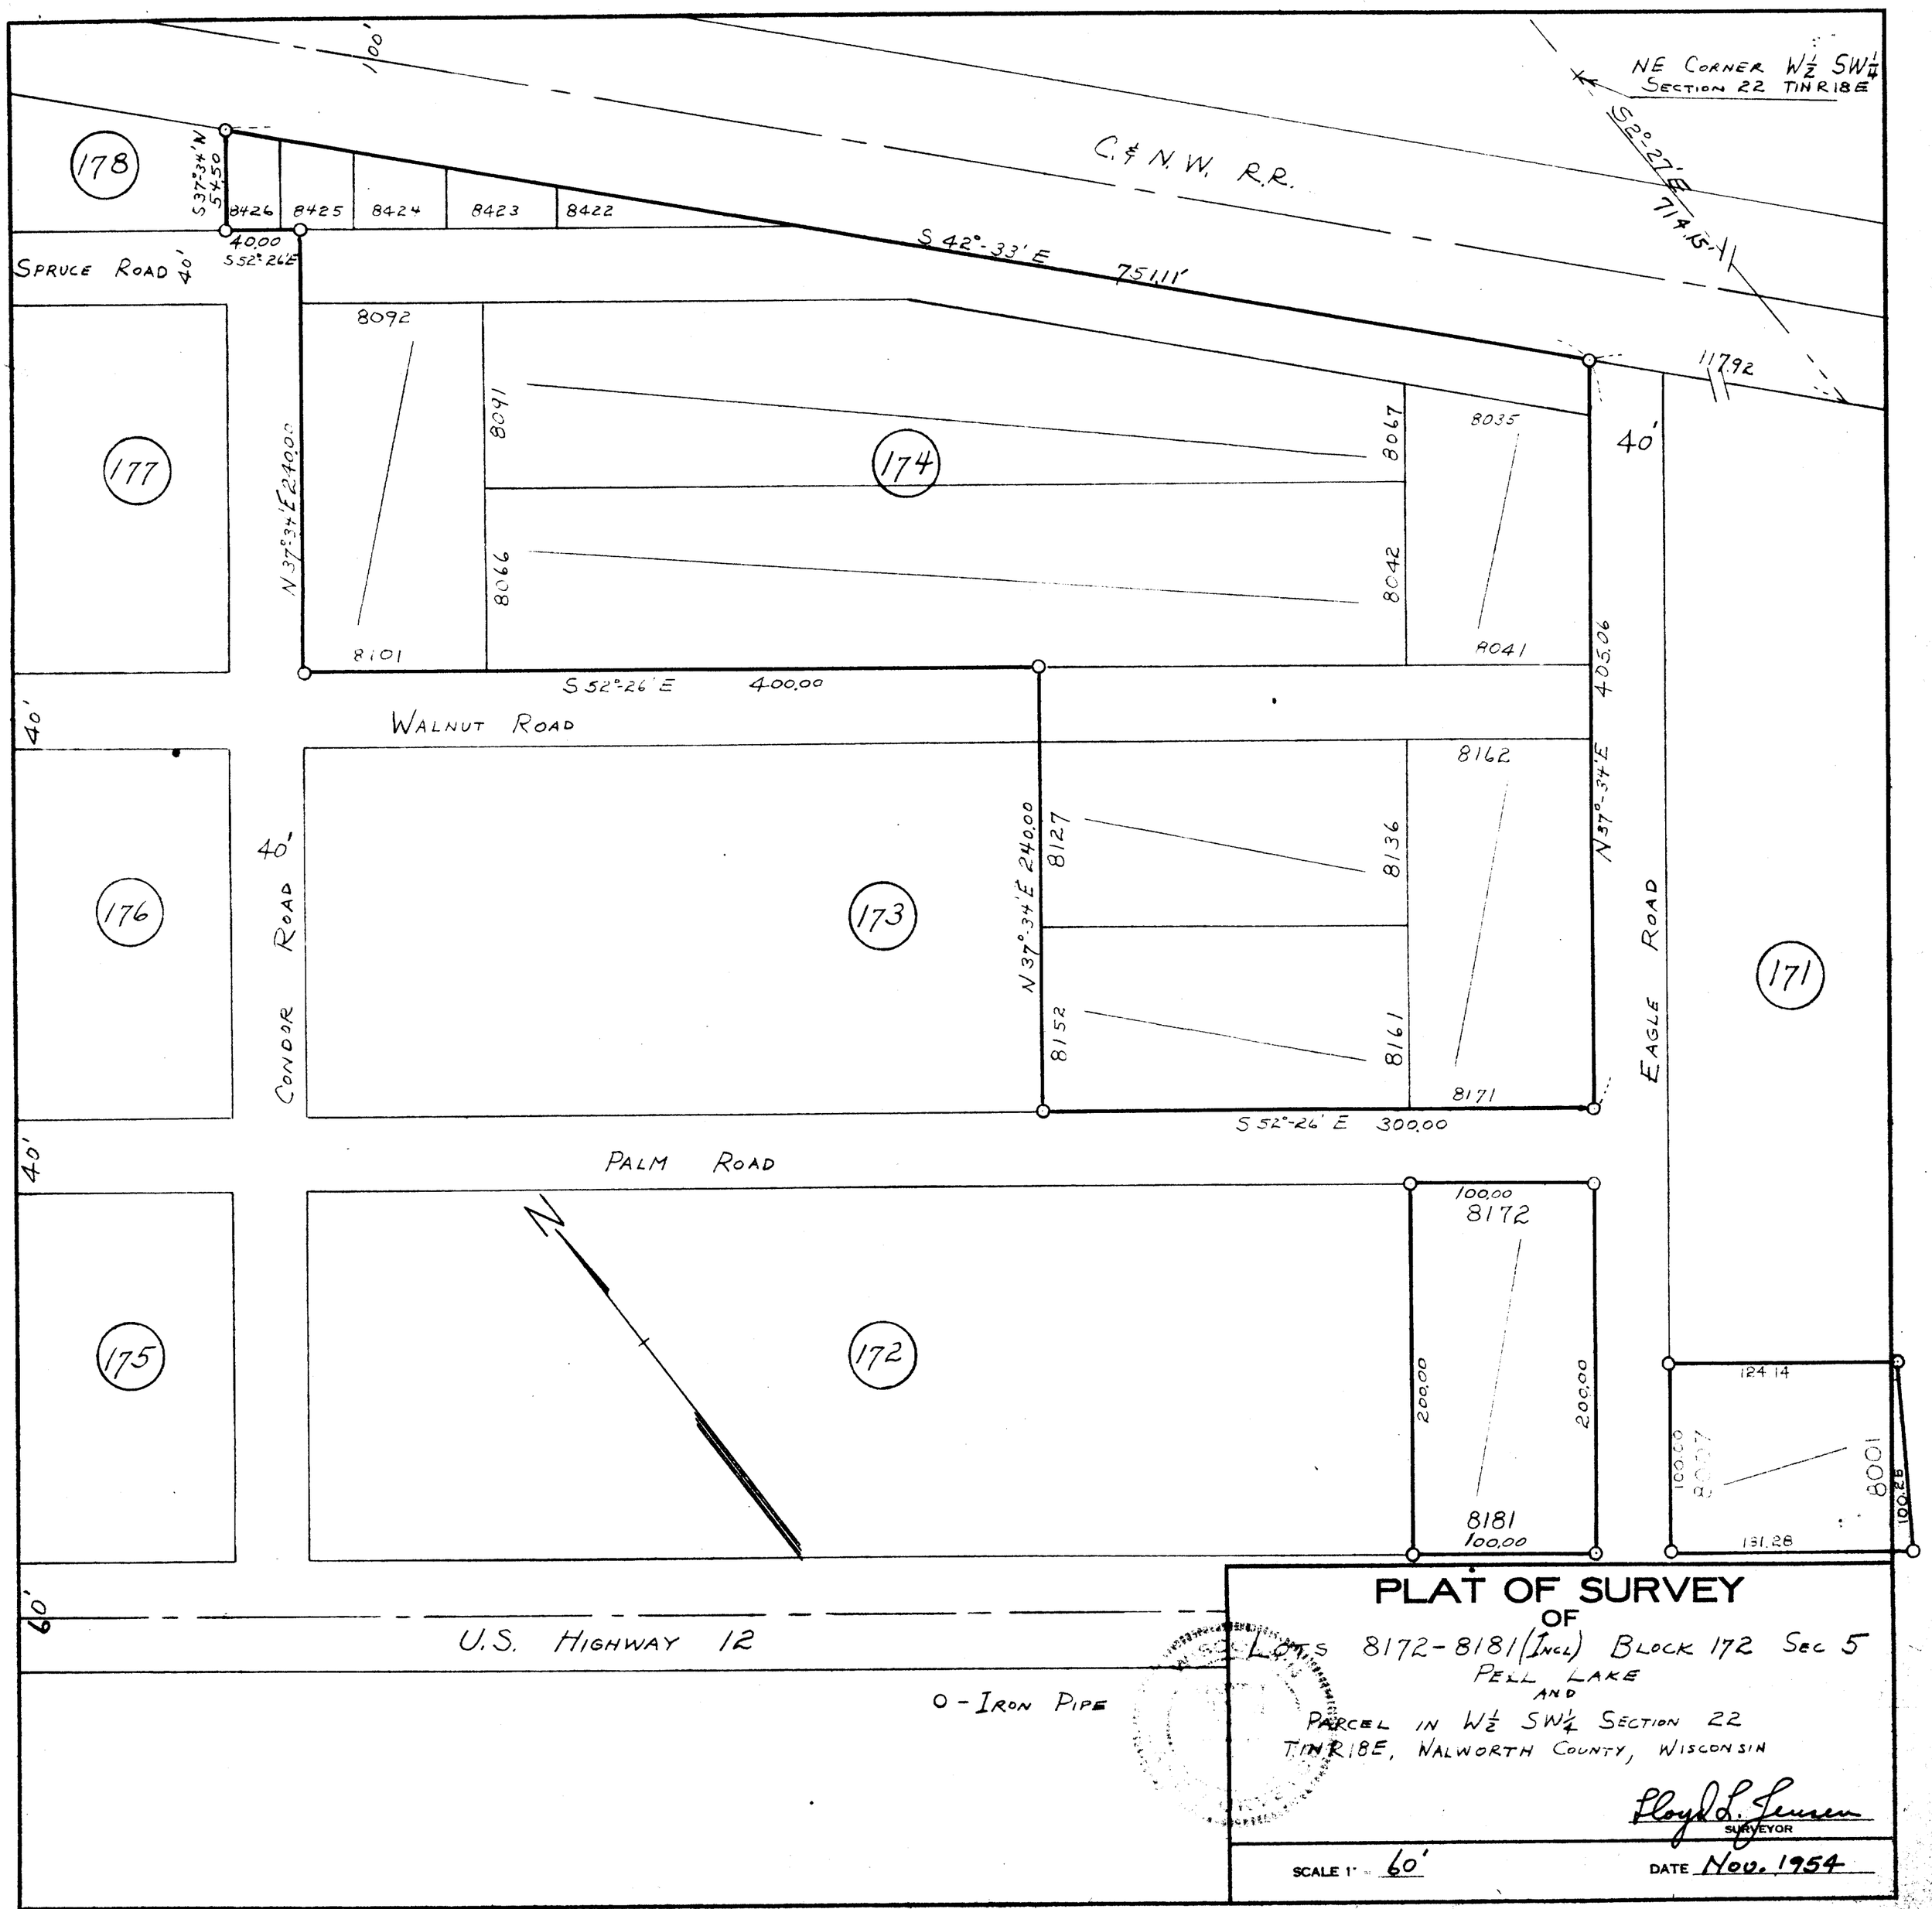

PLAT OF SURVEY

OF

LOTS 8172-8181 (INCL) BLOCK 172 SEC 5
PELL LAKE
AND
PARCEL IN W½ SW¼ SECTION 22
T1N R18E, WALWORTH COUNTY, WISCONSIN

Floyd L. Jensen
SURVEYOR

SCALE 1" = 60'

DATE Nov. 1954

NO. 177H - 400 - 3-10-53

118-621