
DUNHAM & RASMUSSEN
SURVEYING & ENGINEERING
DELAVAN, WISCONSIN



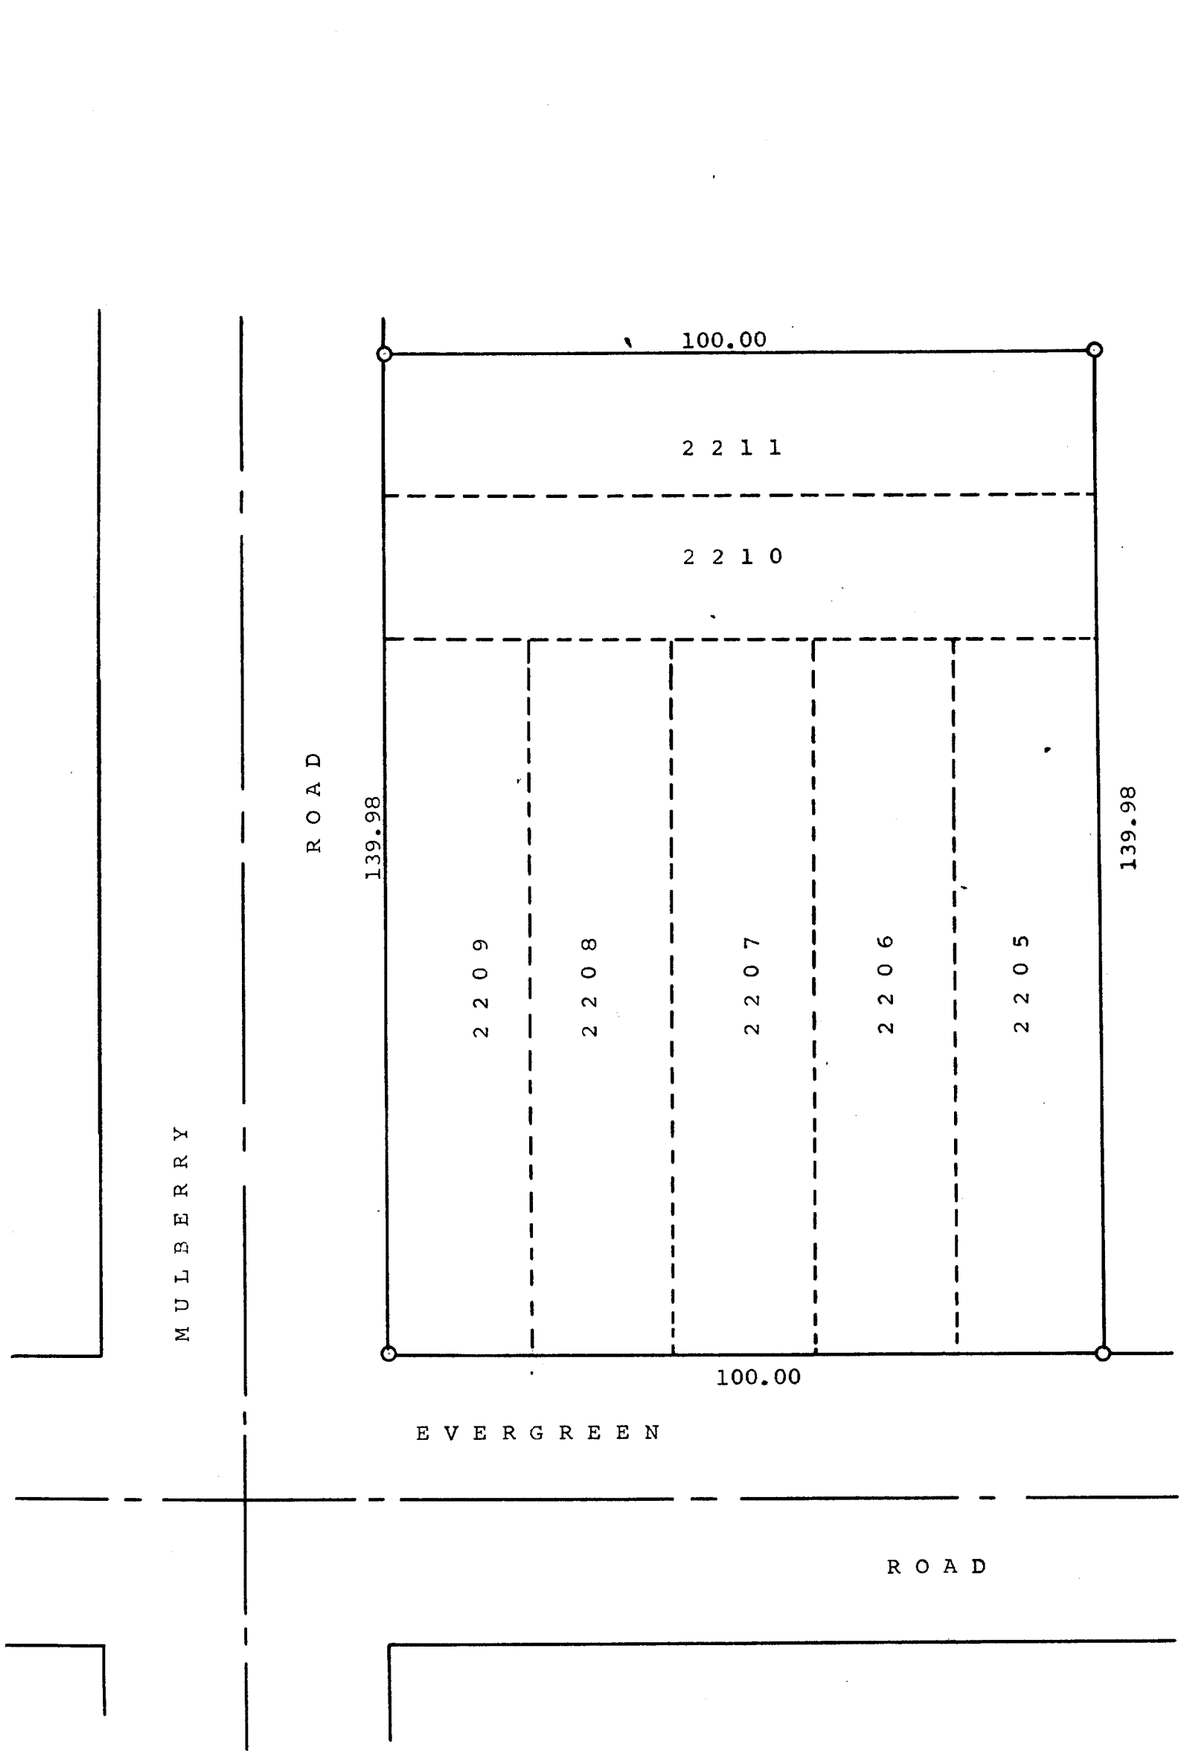

Scale--1"=20'
O = Iron Pipe

Plat of survey of Lots 2205-2211 Inclusive of Pell Lake Subdivisions, Town of Bloomfield, Walworth County, Wisconsin
October 12, 1961

George T. Dunham

George T. Dunham, Surveyor

118-63