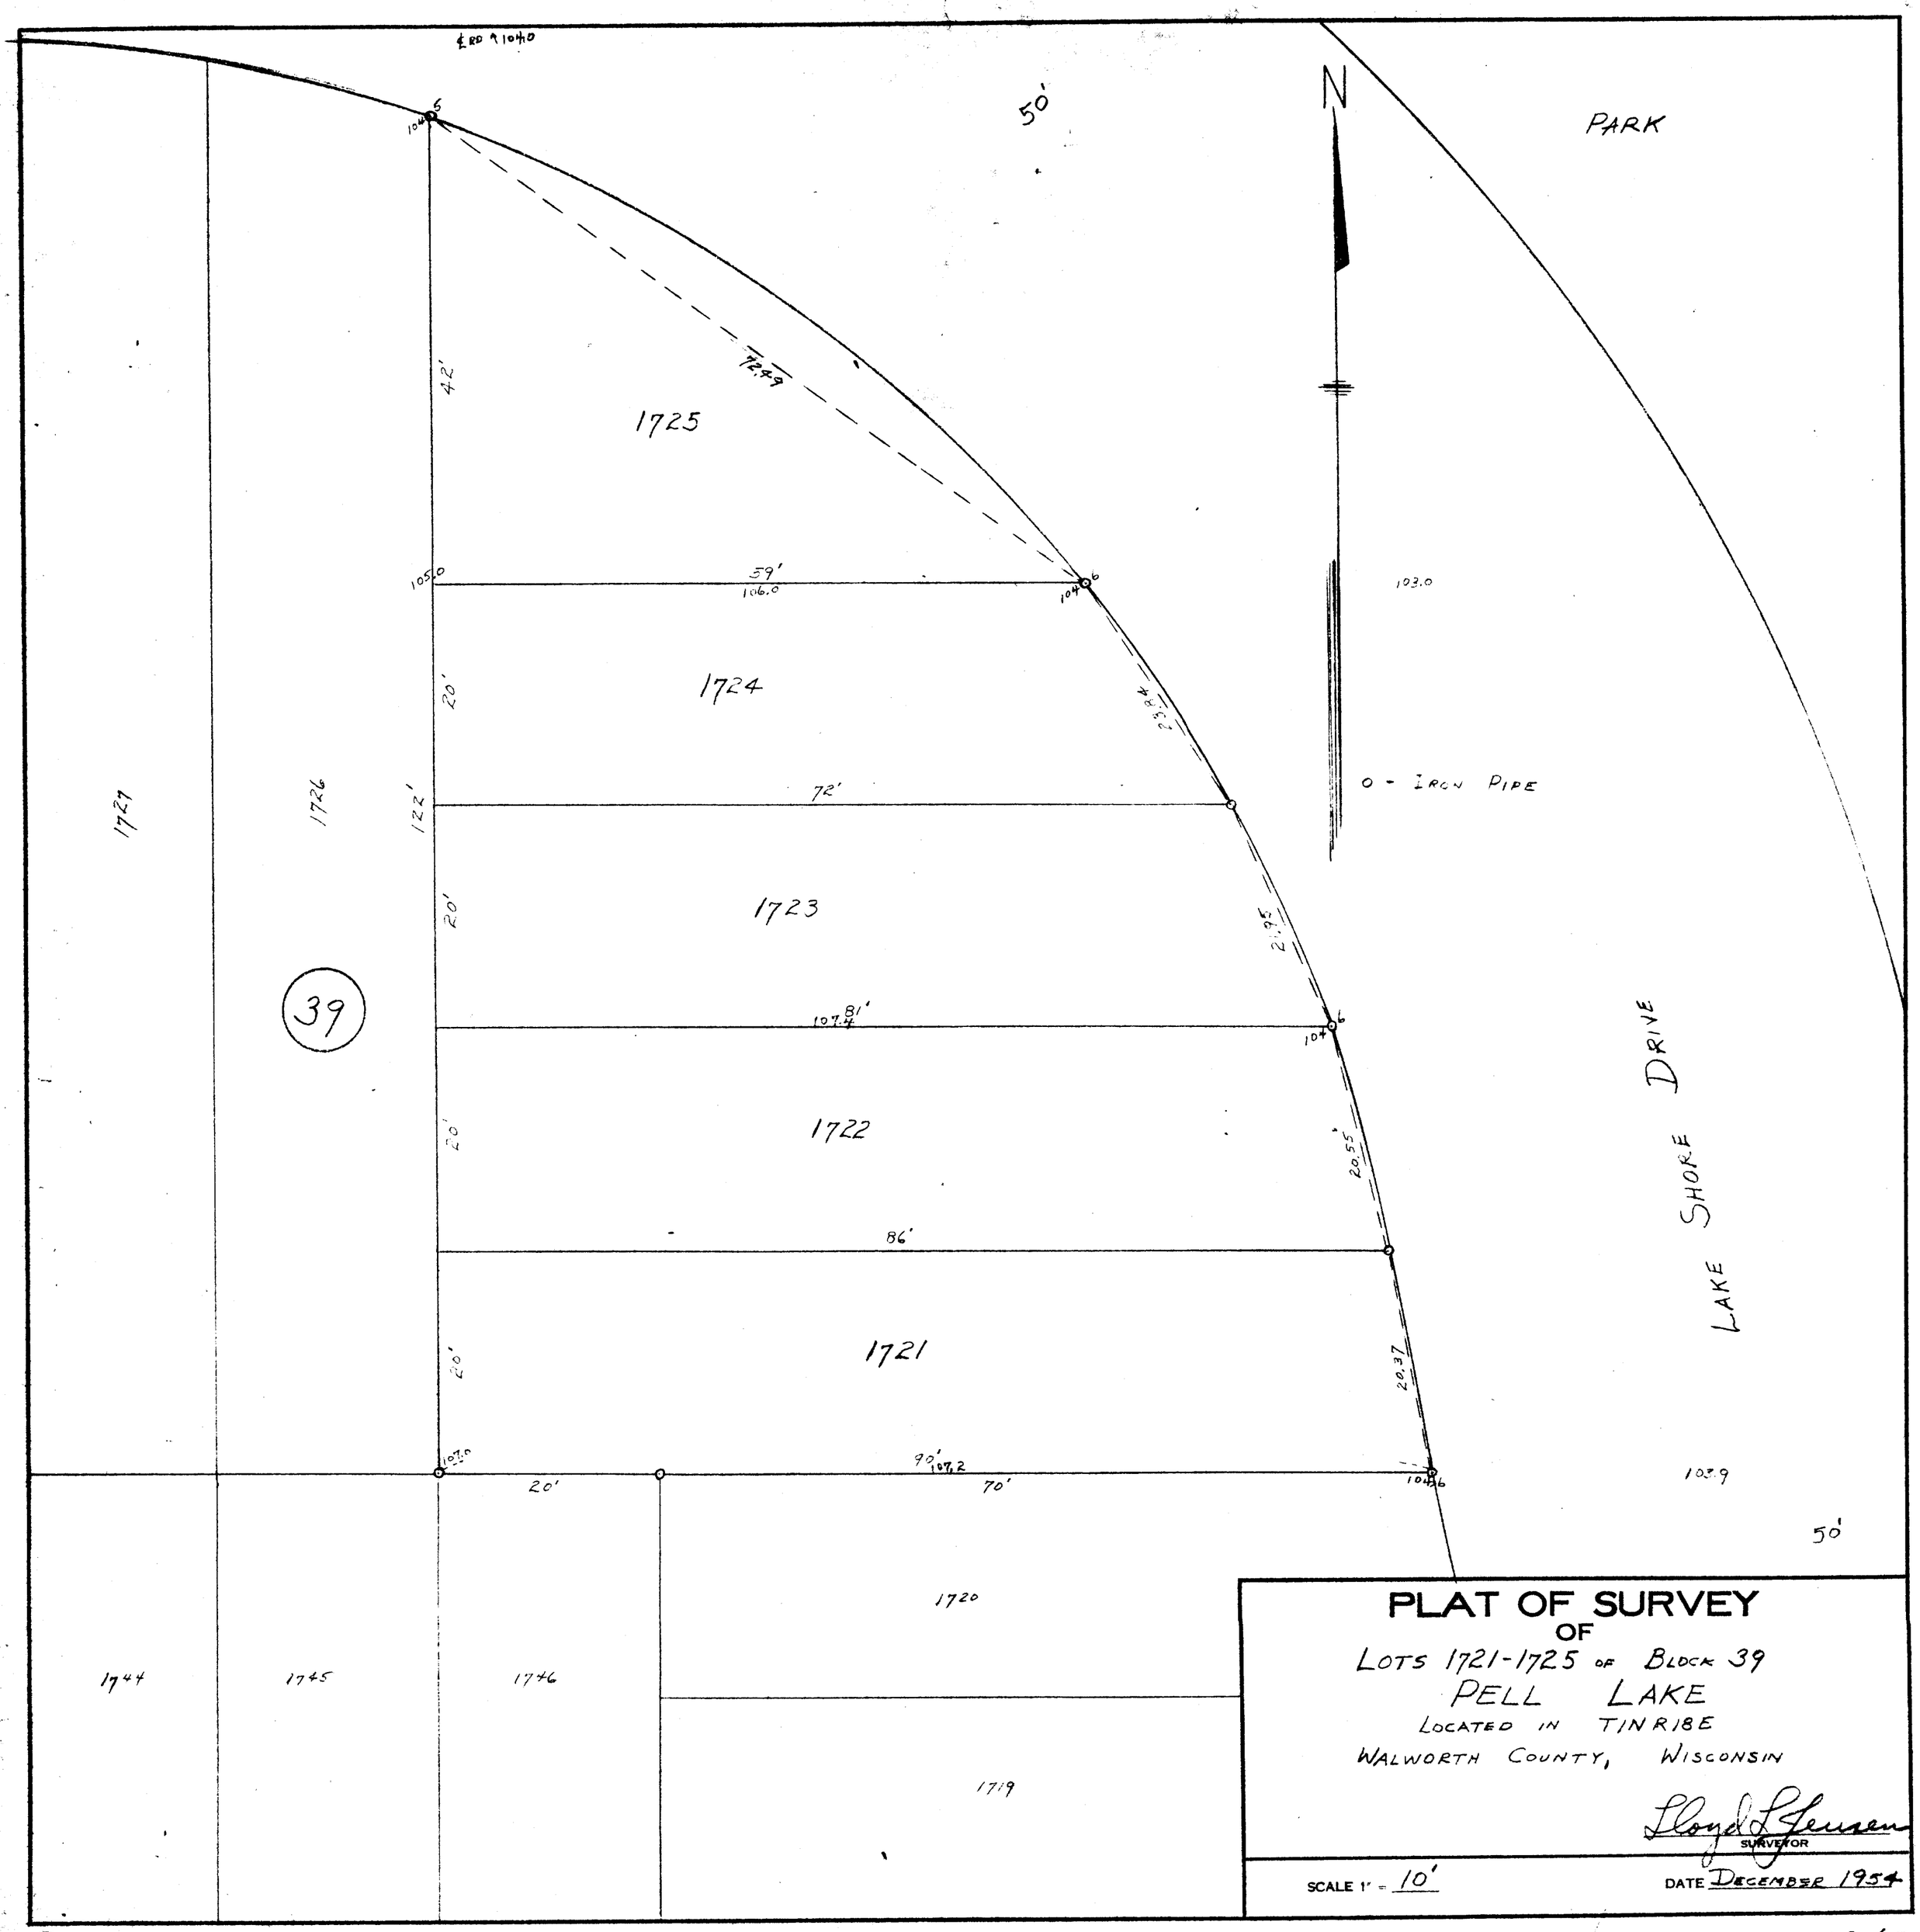

PLAT OF SURVEY
OF
LOTS 1721-1725 OF BLOCK 39
PELL LAKE
LOCATED IN T1N R18E
WALWORTH COUNTY, WISCONSIN

Lloyd L Jensen
SURVEYOR

SCALE 1" = 10'

DATE DECEMBER 1954

NO. 177H—400—3-10-53

118-63-1