
KOLB LAND CONSULTING, INC.

LAND SURVEYING · SUBDIVIDING · LAND PLANNING

LAKE GENEVA, WISCONSIN 53147 WHITEWATER, WISCONSIN 53190

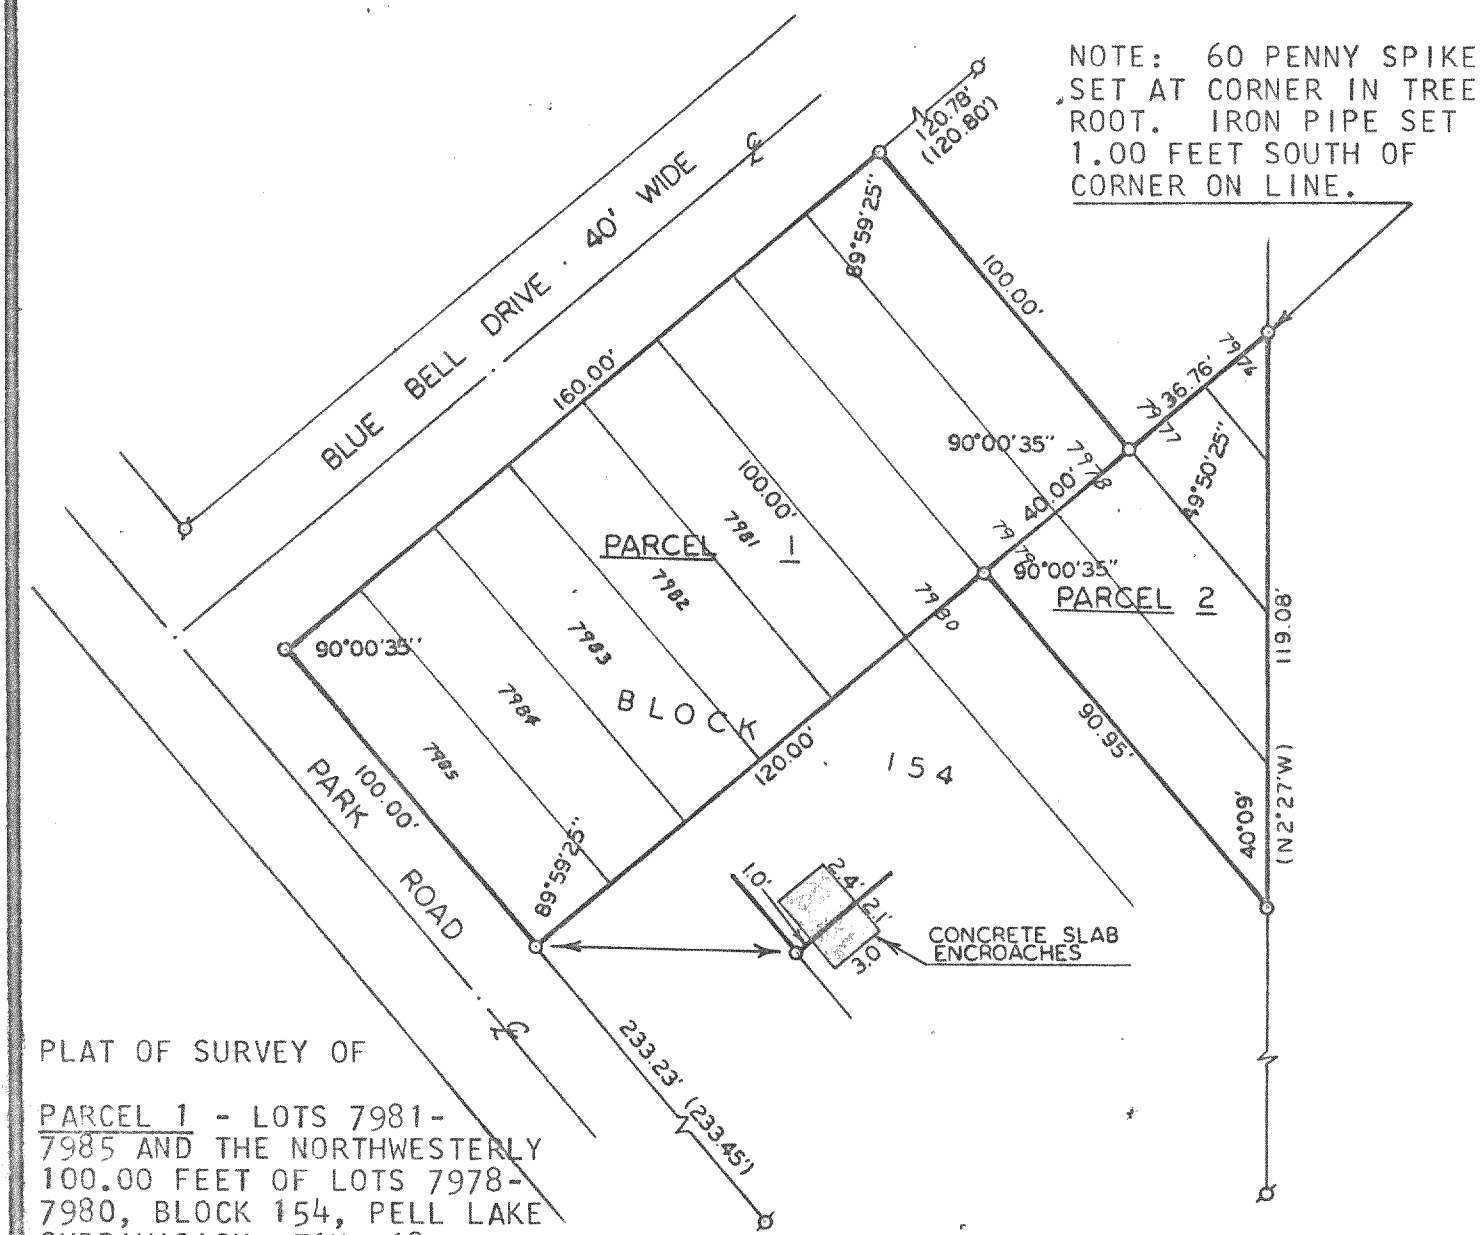

NOTE: 60 PENNY SPIKE SET AT CORNER IN TREE ROOT. IRON PIPE SET 1.00 FEET SOUTH OF CORNER ON LINE.

PLAT OF SURVEY OF

PARCEL 1 - LOTS 7981-7985 AND THE NORTHWESTERLY 100.00 FEET OF LOTS 7978-7980, BLOCK 154, PELL LAKE SUBDIVISION, T1N,R18E, WALWORTH COUNTY, WISCONSIN.

PARCEL 2 - LOTS 7976-7979, EXCEPTING THE NORTHWESTERLY 100.00 FEET, ALL IN BLOCK 154, PELL LAKE SUBDIVISION, T1N,R18E, WALWORTH COUNTY, WISCONSIN.

ORDERED BY: TONY SIENKOWSKI
RT. 3, BOX 464
LAKE GENEVA, WI
53147

WISCONSIN HAROLD H. KOLB S-187 LAKE GENEVA, WIS. LAND SURVEYOR

SCALE - 1"=40'

LEGEND
- ⌀ - IRON PIPE FOUND
- o - IRON PIPE SET
- ( ) - RECORDED AS

I, HAROLD H. KOLB, DO HEREBY CERTIFY THAT I HAVE SURVEYED THE PROPERTY HEREON DESCRIBED ACCORDING TO THE OFFICIAL RECORDS, AND THAT THE PLAT HEREON IS A CORRECT REPRESENTATION OF THE LOT LINES TO THE BEST OF MY KNOWLEDGE AND BELIEF.

Harold H. Kolb

HAROLD H. KOLB
WISCONSIN REGISTERED LAND SURVEYOR, S-187

DATE May 10, 1982

118-632-K