
KOLB LAND CONSULTING, INC.

LAND SURVEYING · SUBDIVIDING · LAND PLANNING

LAKE GENEVA, WISCONSIN 53147

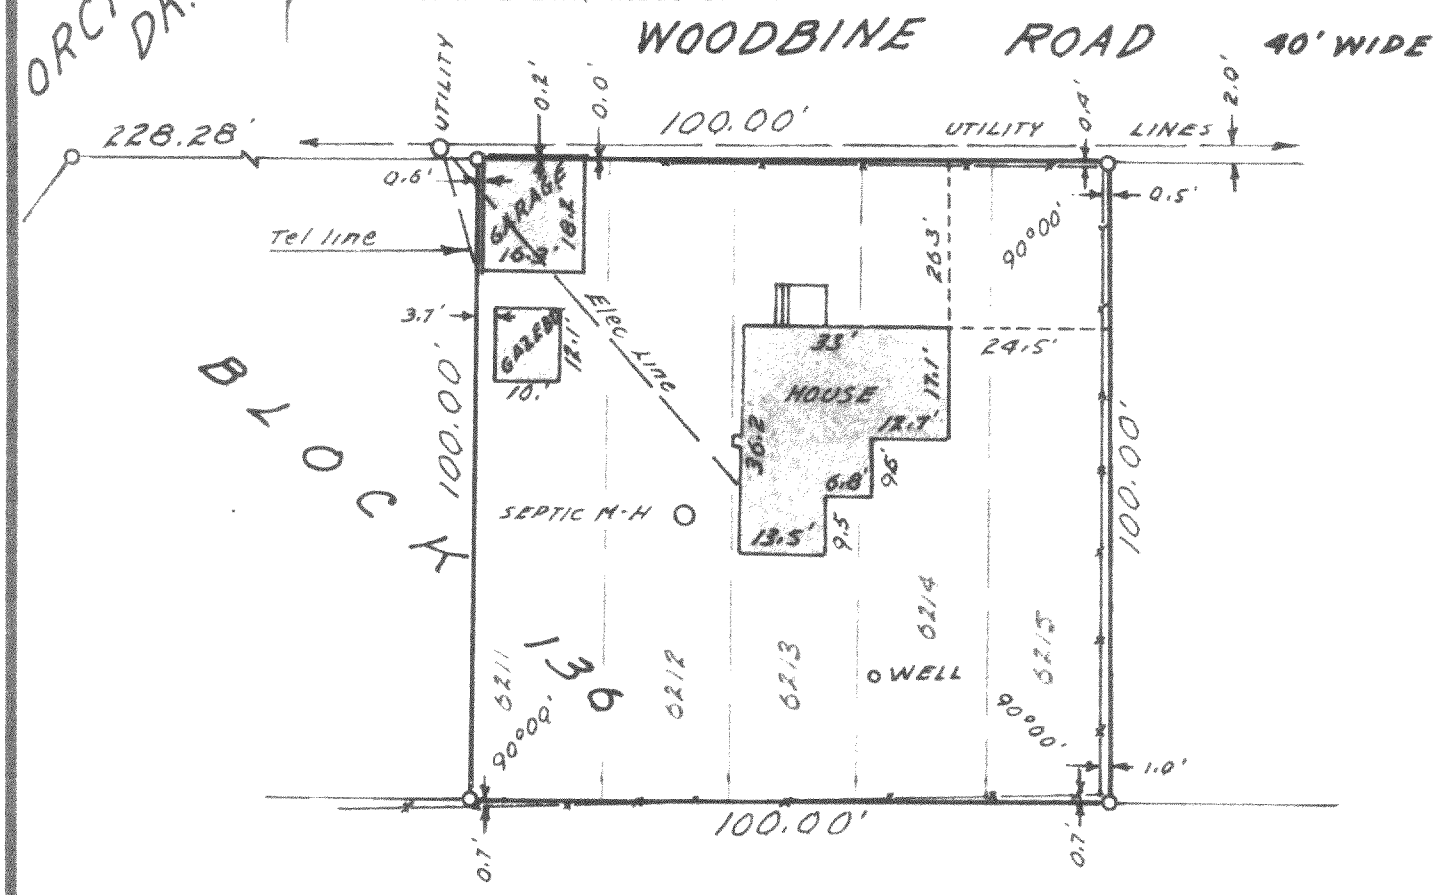

PLAT OF SURVEY OF

LOTS 6211-6215, BLOCK 136, SECTION 4 OF PELL LAKE SUBDIVISION, BEING A SUBDIVISION LOCATED IN SECTION 15, T 1 N, R 18 E, WALWORTH COUNTY, WISCONSIN.

SCALE 1"=30'

LEGEND

O IRON PIPE FOUND

—x—FENCE

ORDERED BY: BANCO MORTGAGE COMPANY
3333 N. MAYFAIR ROAD
MILWAUKEE, WI. 53226

FOR: MICHEAL KATZENBERG
W 1037 WOODBINE ROAD
PELL LAKE, WI. 53157

I HEREBY CERTIFY THAT I HAVE SURVEYED THE ABOVE DESCRIBED PROPERTY AND THAT THE ABOVE MAP IS A TRUE REPRESENTATION THEREOF AND SHOWS THE SIZE AND LOCATION OF THE PROPERTY, IT'S EXTERIOR BOUNDARIES, THE LOCATION OF ALL VISIBLE STRUCTURES AND DIMENSIONS OF ALL PRINCIPAL BUILDINGS THEREON, BOUNDARY FENCES, APPARENT EASEMENTS, ROADWAYS AND VISIBLE ENCROACHMENTS, IF ANY.

THIS SURVEY IS MADE FOR THE USE OF THE PRESENT OWNERS OF THE PROPERTY, AND ALSO THOSE WHO PURCHASE, MORTGAGE, OR GUARANTEE THE TITLE THERETO WITHIN ONE (1) YEAR FROM THE DATE HEREOF.

WISCONSIN

Harold W. Kolb

WISCONSIN REGISTERED LAND SURVEYOR, S-187

DATE MARCH 7, 1983

118-633-K

1-18-PL 1951 & 2