


KOLB LAND CONSULTING, INC.
LAKE GENEVA, WISCONSIN

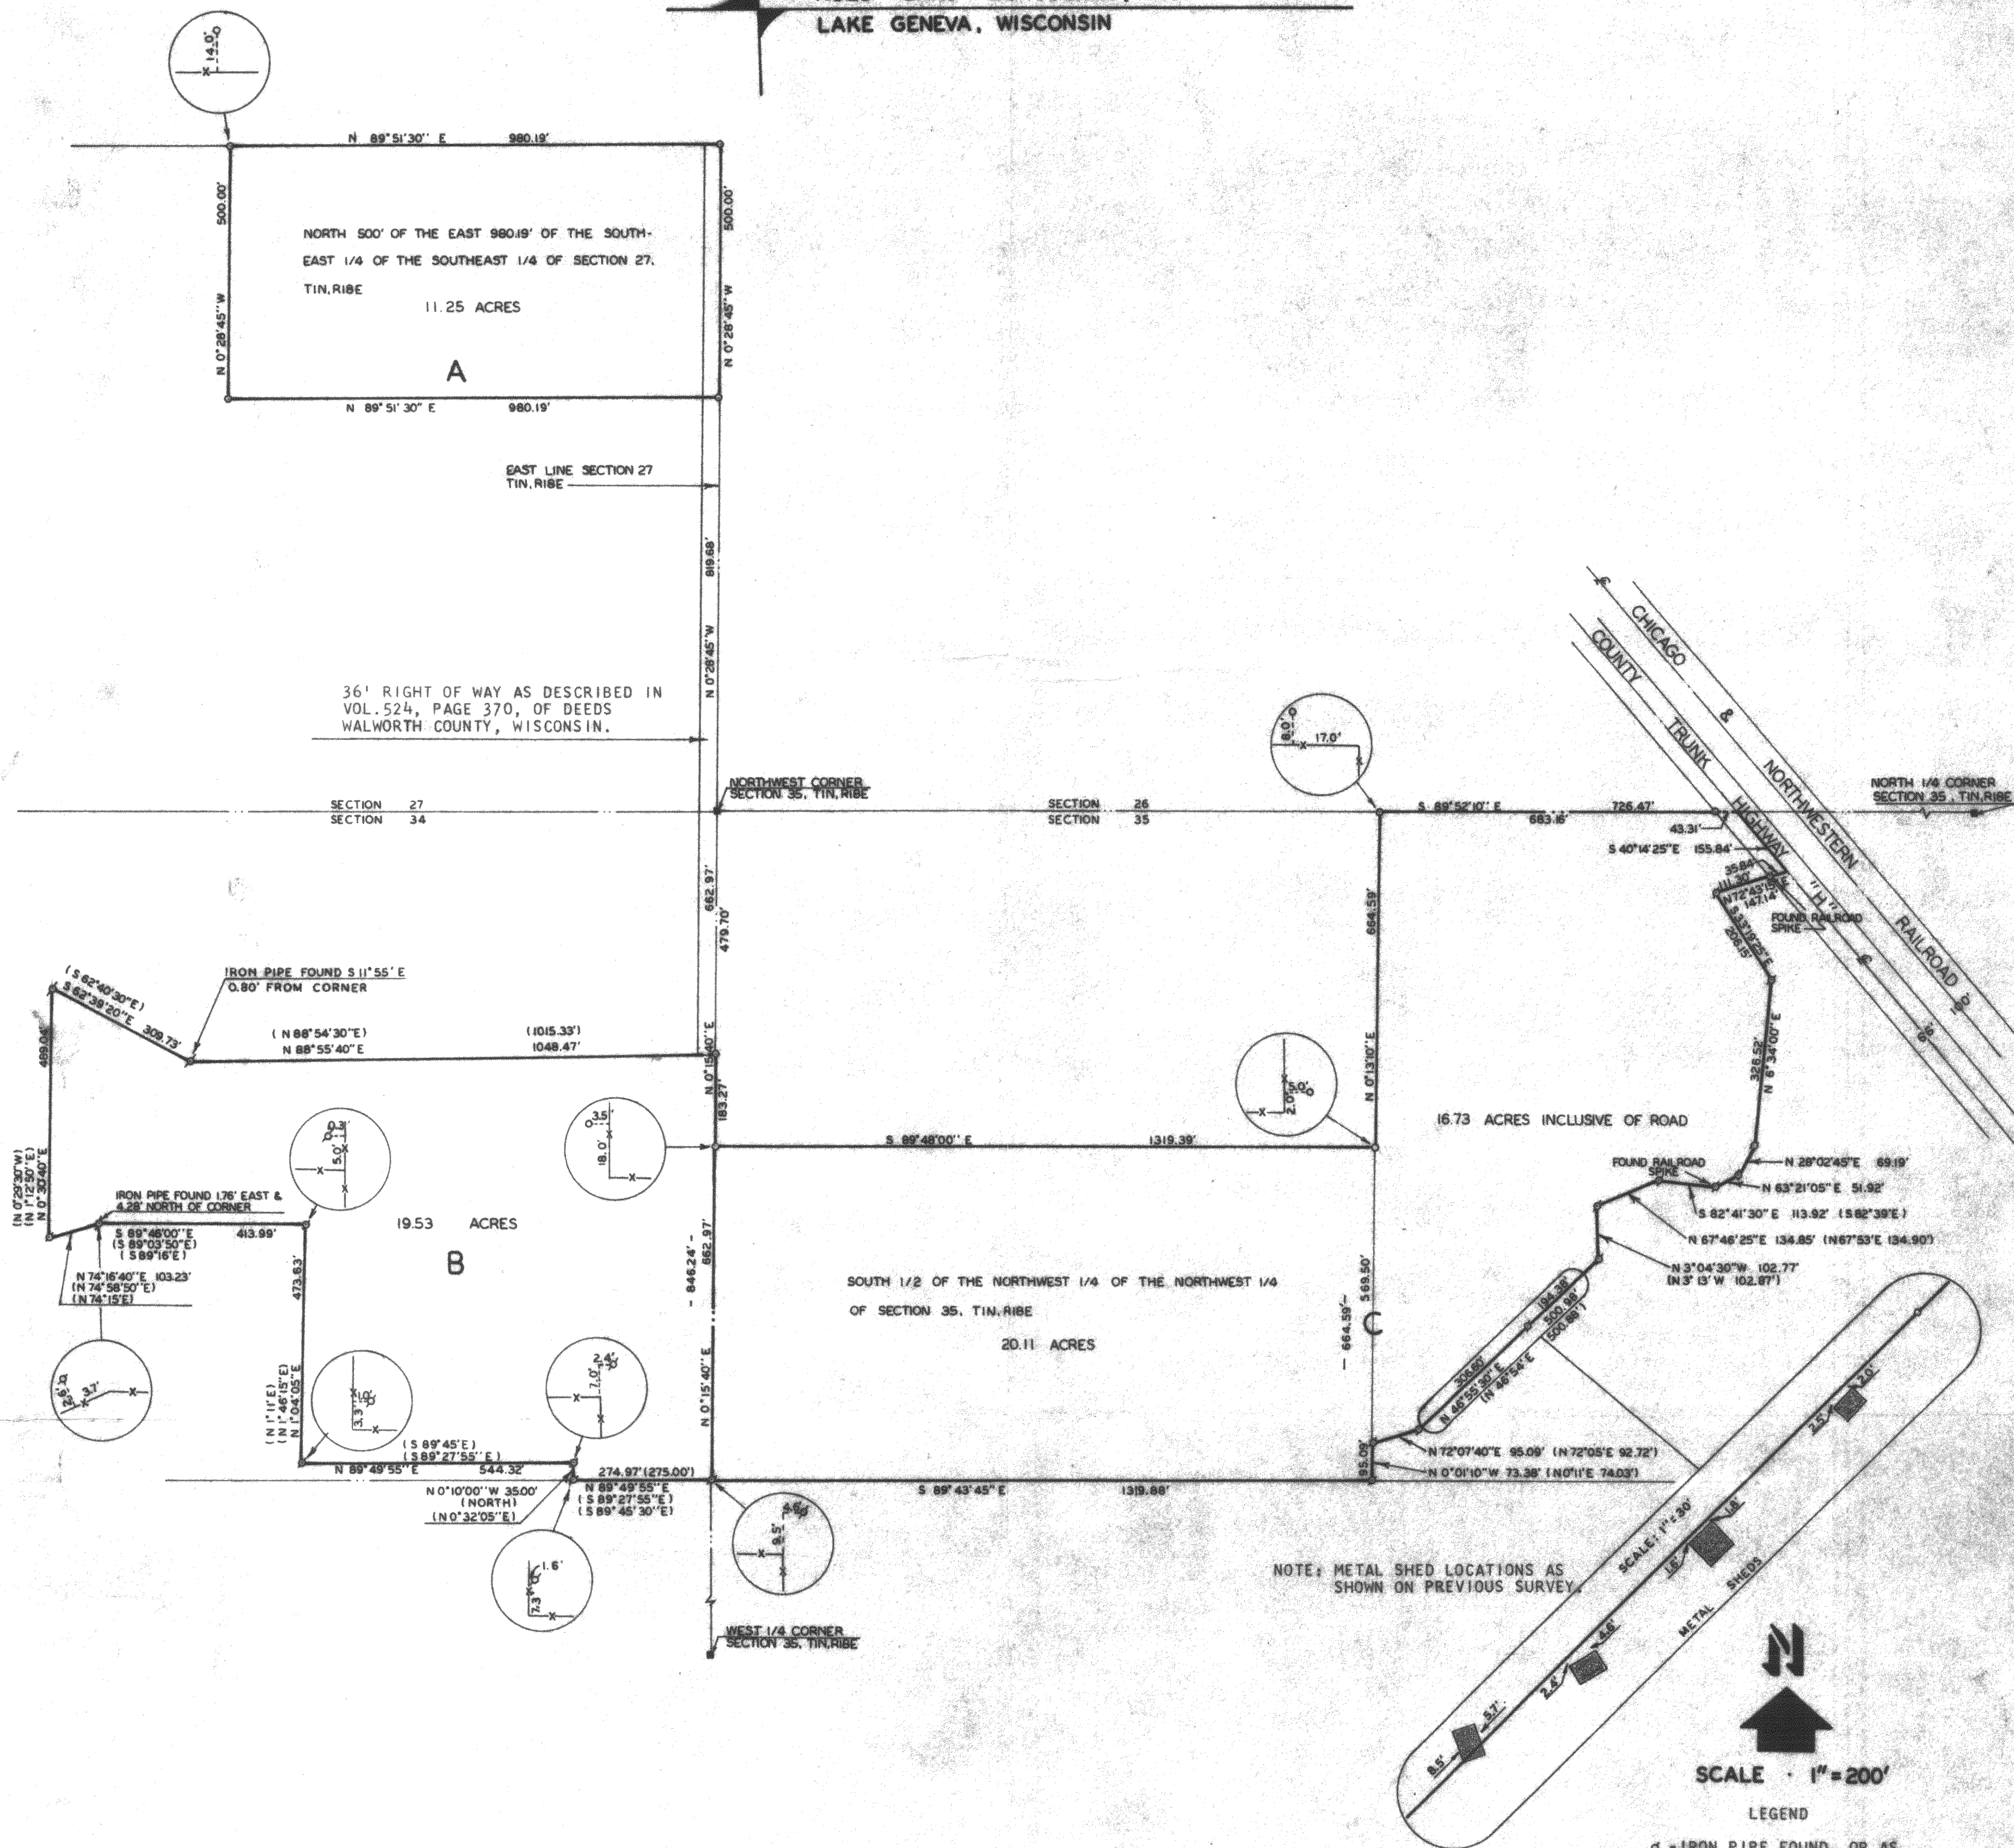

PLAT OF SURVEY OF

THREE PARCELS OF LAND LOCATED IN THE SOUTHEAST 1/4 OF SECTION 27, THE NORTHEAST 1/4 OF SECTION 34 AND THE NORTHWEST 1/4 OF SECTION 35, ALL IN T.1N., R.18.E., WALWORTH COUNTY, WISCONSIN AND DESCRIBED AS FOLLOWS:


PARCEL A. COMMENCING AT THE SOUTHEAST CORNER OF SAID SECTION 27, THENCE N0°28'45"W 819.68 FEET TO THE PLACE OF BEGINNING; THENCE S89°51'30"E 980.19 FEET; THENCE N0°28'45"W 500.00 FEET; THENCE N89°51'30"E 980.19 FEET; THENCE S0°28'45"E 500.00 FEET TO THE PLACE OF BEGINNING, CONTAINING 11.25 ACRES OF LAND.

PARCEL B. COMMENCING AT THE NORTHEAST CORNER OF SAID SECTION 34, THENCE S0°15'40"W 479.70 FEET TO THE PLACE OF BEGINNING; THENCE S0°15'40"W 846.24 FEET; THENCE S89°49'55"W 274.97 FEET; THENCE N0°10'00"W 35.00 FEET; THENCE S89°49'55"W 544.32 FEET; THENCE N1°04'05"E 473.63 FEET; THENCE N89°46'00"W 413.99 FEET; THENCE S74°16'40"W 103.23 FEET; THENCE N0°30'40"E 489.04 FEET; THENCE S62°39'20"E 309.73 FEET; THENCE N88°55'40"E 1048.47 FEET TO THE PLACE OF BEGINNING, CONTAINING 19.53 ACRES OF LAND.

PARCEL C. COMMENCING AT THE NORTHWEST CORNER OF SAID SECTION 35, THENCE S0°15'40"W 662.97 FEET TO THE PLACE OF BEGINNING; THENCE S89°48'00"E 1319.39 FEET; THENCE N0°13'10"E 664.59 FEET; THENCE S89°52'10"E 726.47 FEET; THENCE S40°14'25"E 155.84 FEET; THENCE S72°43'15"W 147.14 FEET; THENCE S33°19'25"E 206.15 FEET; THENCE S6°34'00"W 326.52 FEET; THENCE S28°02'45"W 69.19 FEET; THENCE S63°21'05"W 51.92 FEET; THENCE N82°41'30"W 113.92 FEET; THENCE S67°46'25"E 134.85 FEET; THENCE S3°04'30"E 102.77 FEET; THENCE S46°55'30"W 500.98 FEET; THENCE S72°07'40"W 95.09 FEET; THENCE S0°01'10"E 73.38 FEET; THENCE N89°43'45"W 1319.88 FEET; THENCE N0°15'40"E 662.97 FEET TO THE PLACE OF BEGINNING, CONTAINING 36.84 ACRES OF LAND.

NOTE: BEARINGS ASSUMED FROM PREVIOUS SURVEY RECORDS.
FENCE LINE DETAILS ARE NOT DRAWN TO SCALE.

ORDERED BY: JOHN Z. SEBASTIAN
4613 N. WESTERN AVENUE
CHICAGO, ILLINOIS 60625

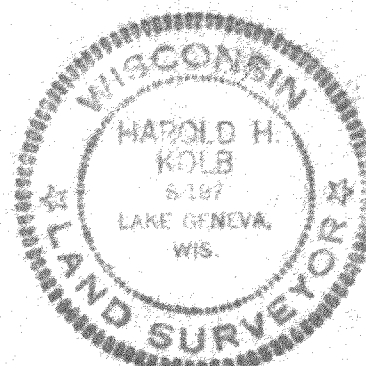

I, HAROLD H. KOLB, DO HEREBY CERTIFY THAT I HAVE SURVEYED THE PROPERTY HEREON DESCRIBED ACCORDING TO THE OFFICIAL RECORDS, AND THAT THE PLAT HEREON IS A CORRECT REPRESENTATION OF THE PROPERTY LINES TO THE BEST OF MY KNOWLEDGE AND BELIEF.

HAROLD H. KOLB
WISCONSIN REGISTERED LAND SURVEYOR, S-187

DATE Jan 6, 1981

TUG C-5A, TUG C-5

B-27-9 B-34-1, B-35-3 and TUG C-4 in Village of Geneva City

118-634