
FARRIS, HANSEN & COOPER, INC.

ENGINEERING, SURVEYING AND LAND PLANNING

715 W. WALWORTH ST. - P.O. BOX 487 - ELKHORN, WI 53121

OFFICE: 414/723-2098

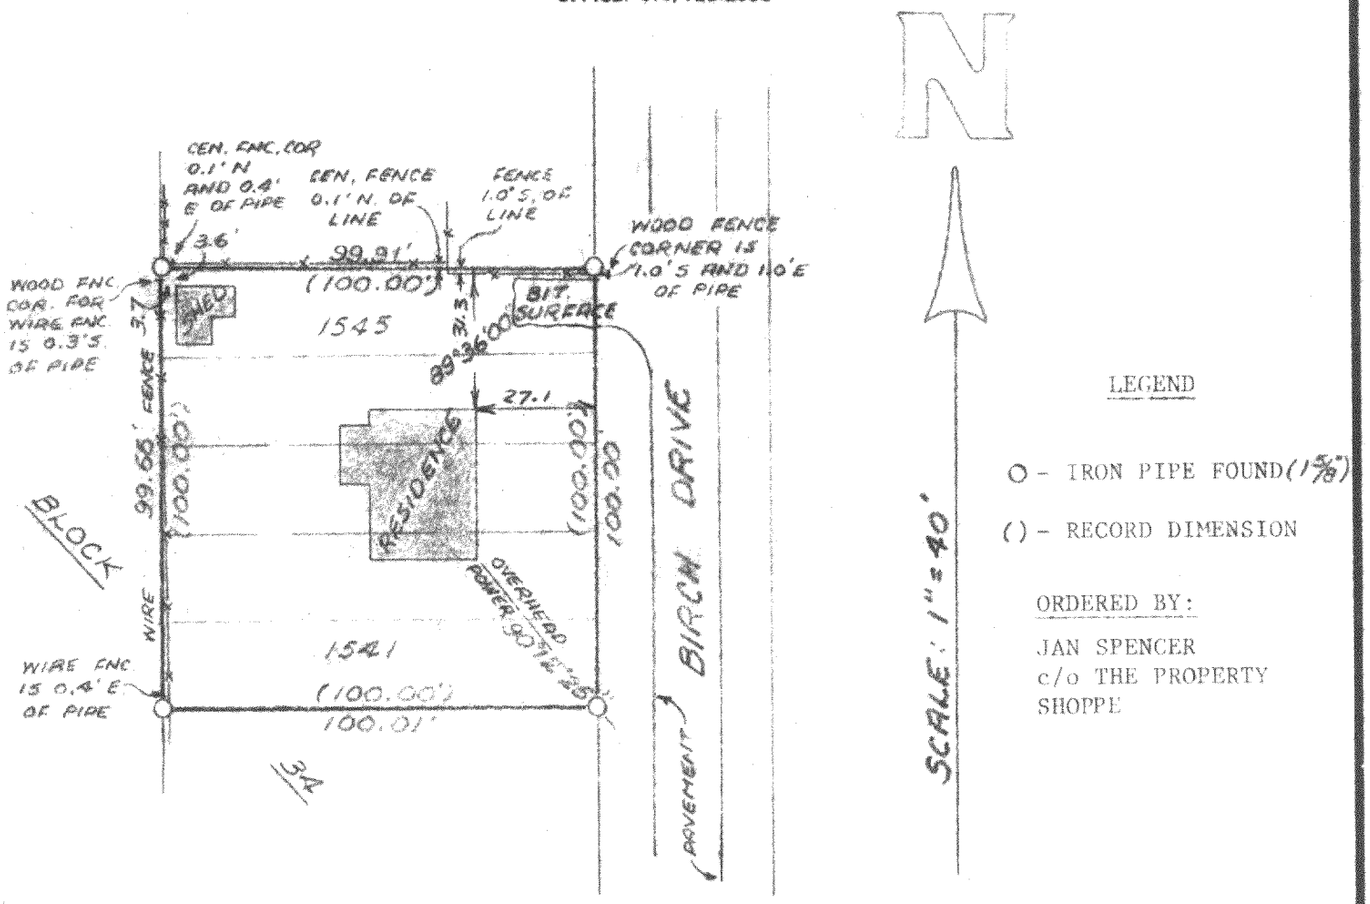

LEGEND

O - IRON PIPE FOUND (1 5/8")

() - RECORD DIMENSION

ORDERED BY:

JAN SPENCER
c/o THE PROPERTY SHOPPE

PLAT OF SURVEY OF

LOTS 1541-1545, BLOCK 34, PELL LAKE SUBDIVISION,
WALWORTH COUNTY, WISCONSIN.

WISCONSIN
ROBERT A. FARRIS
S-1293
ELKHORN, WIS.
LAND SURVEYOR

I HEREBY CERTIFY that at the direction of Jan Spencer I have surveyed the above described lots and that this Plat of Survey is a true and accurate representation of the lot lines and structures shown to the best of my professional knowledge and belief.

Robert A. Farris

Robert A. Farris, R.L.S. No 1293

Dated this 9 day of Nov., 1982

DRAWING NUMBER 2016

118-641-F