PLAT OF SURVEY

LOTS 4836 THRU 4840 IN BLOCK 93 OF PELL LAKE, SECTION 3, A SUBDIVISION LOCATED IN SECTION 15, T. 1 N., R. 18 E. OF THE 4TH P.M., TOWNSHIP OF BLOOMFIELD, COUNTY OF WALWORTH, WISCONSIN.

FOR: JOHN TOVELL

SCALE 1" = 30'

o = IRON PIPE STAKE (SET)

BEARINGS RELATE TO NORTH LINE OF BLOCK 93 WHICH WAS USED AS "EAST".

WISCONSIN
JOHN F. DEGEN
BURLINGTON, WIS.
LAND SURVEYOR


I have surveyed the above-described property, and the map hereon is a true representation thereof and shows the size and location of the property, its exterior boundaries, the location and dimensions of all visible structures thereon, fences, apparent easements and roadways and visible encroachments, if any.

This survey is made for the exclusive use of the present owners of the property, and also those who purchase, mortgage, or guarantee the title thereto, within one year from date hereof.

Dated at Burlington, this 22ND day of JUNE, 1982

John F Degen

John F. Degen, Land Surveyor S 242

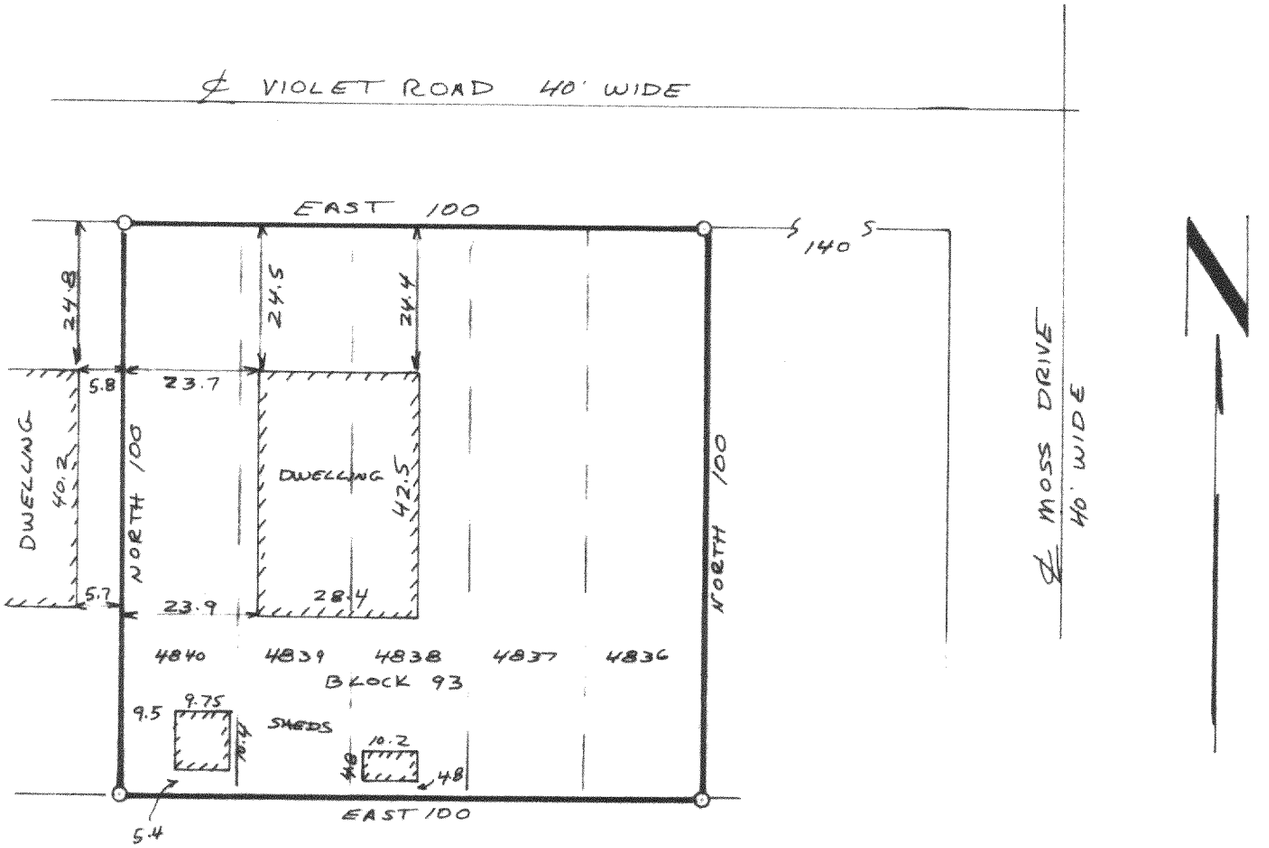

118-643
C-E-4 #5