
KOLB LAND CONSULTING, INC.

LAND SURVEYING · SUBDIVIDING · LAND PLANNING

LAKE GENEVA, WISCONSIN 53147 WHITEWATER, WISCONSIN 53190

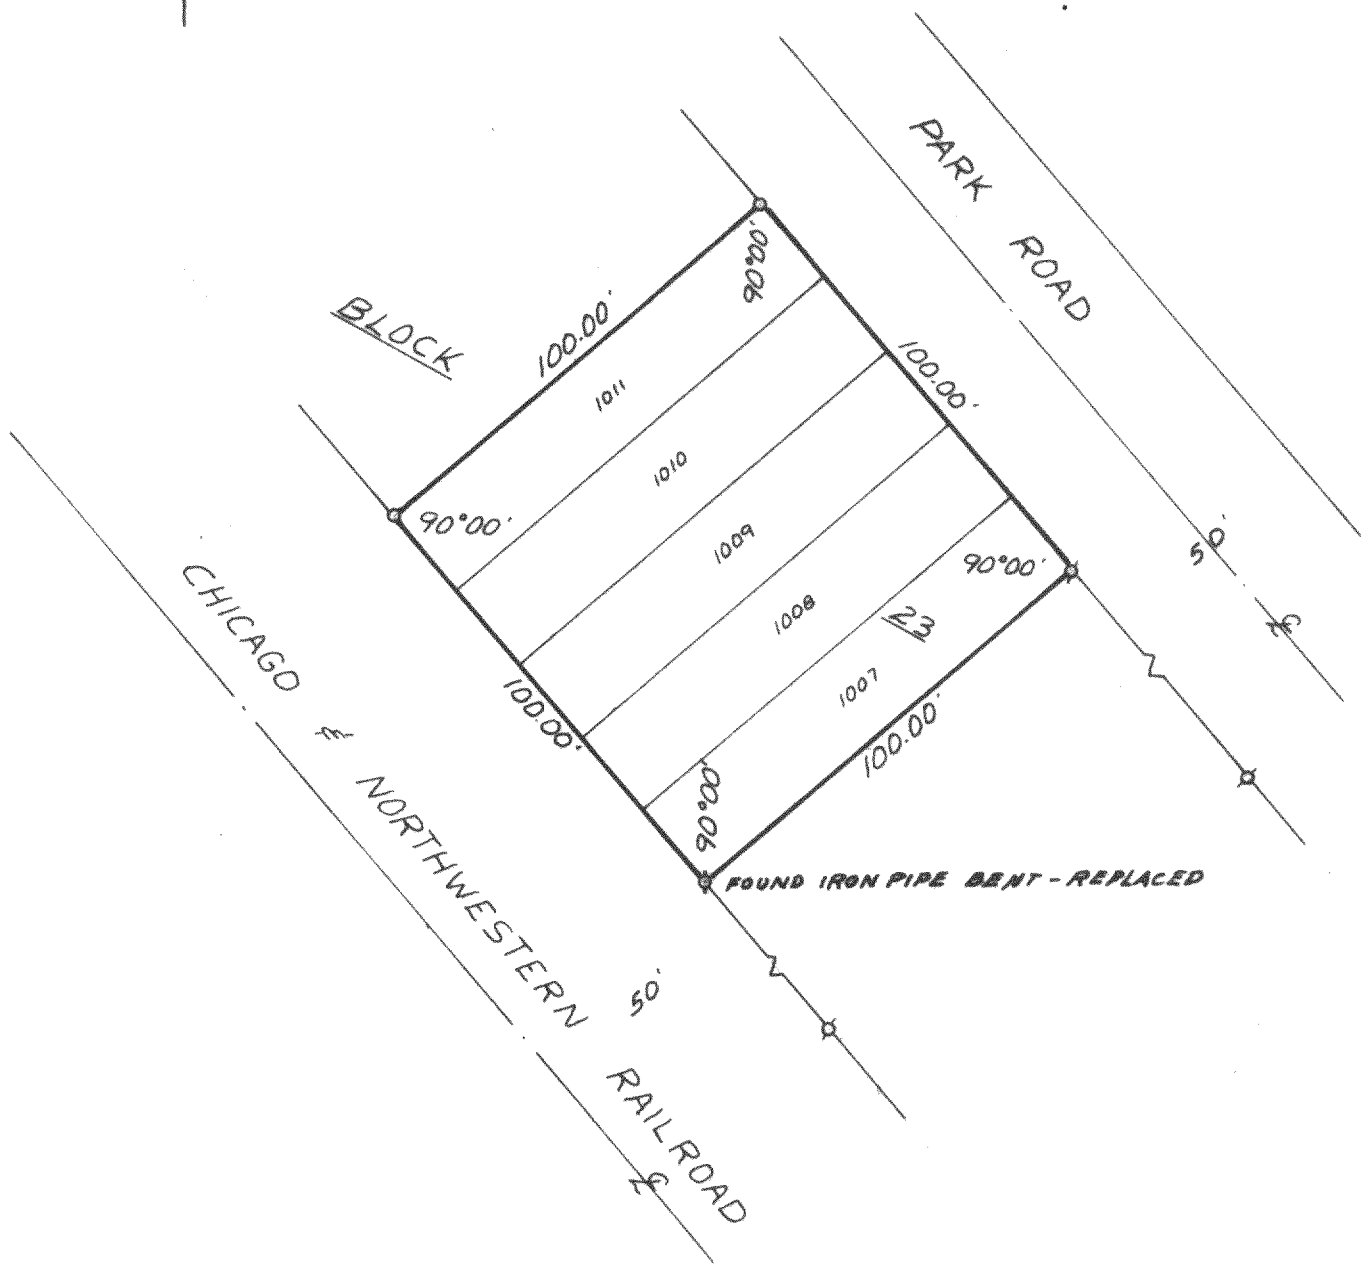

PLAT OF SURVEY OF

LOTS 1007 - 1011, BLOCK 23, PELL LAKE SUBDIVISION, SECTION 1, T1N, R18E, WALWORTH COUNTY, WISCONSIN.

ORDERED BY: HALLMARK REALTY

OWNER: PELL LAKE LUMBER CO.

WISCONSIN HAROLD H KOLB S-187 LAKE GENEVA, WIS LAND SURVEYOR

SCALE - 1"=40'

LEGEND

- ⊠ - IRON PIPE FOUND
- o - IRON PIPE PLACED

I, HAROLD H. KOLB, DO HEREBY CERTIFY THAT I HAVE SURVEYED THE PROPERTY HEREON DESCRIBED ACCORDING TO THE OFFICIAL RECORDS, AND THAT THE PLAT HEREON IS A CORRECT REPRESENTATION OF THE LOT LINES TO THE BEST OF MY KNOWLEDGE AND BELIEF.

Harold H. Kolb

HAROLD H. KOLB
WISCONSIN REGISTERED LAND SURVEYOR, S-187
DATE APRIL 16, 1983

MPL 00223

118-647-K