
DUNHAM SURVEYING, S.C.

SURVEYING & SUBDIVIDING

DELAVAN, WISCONSIN 53115

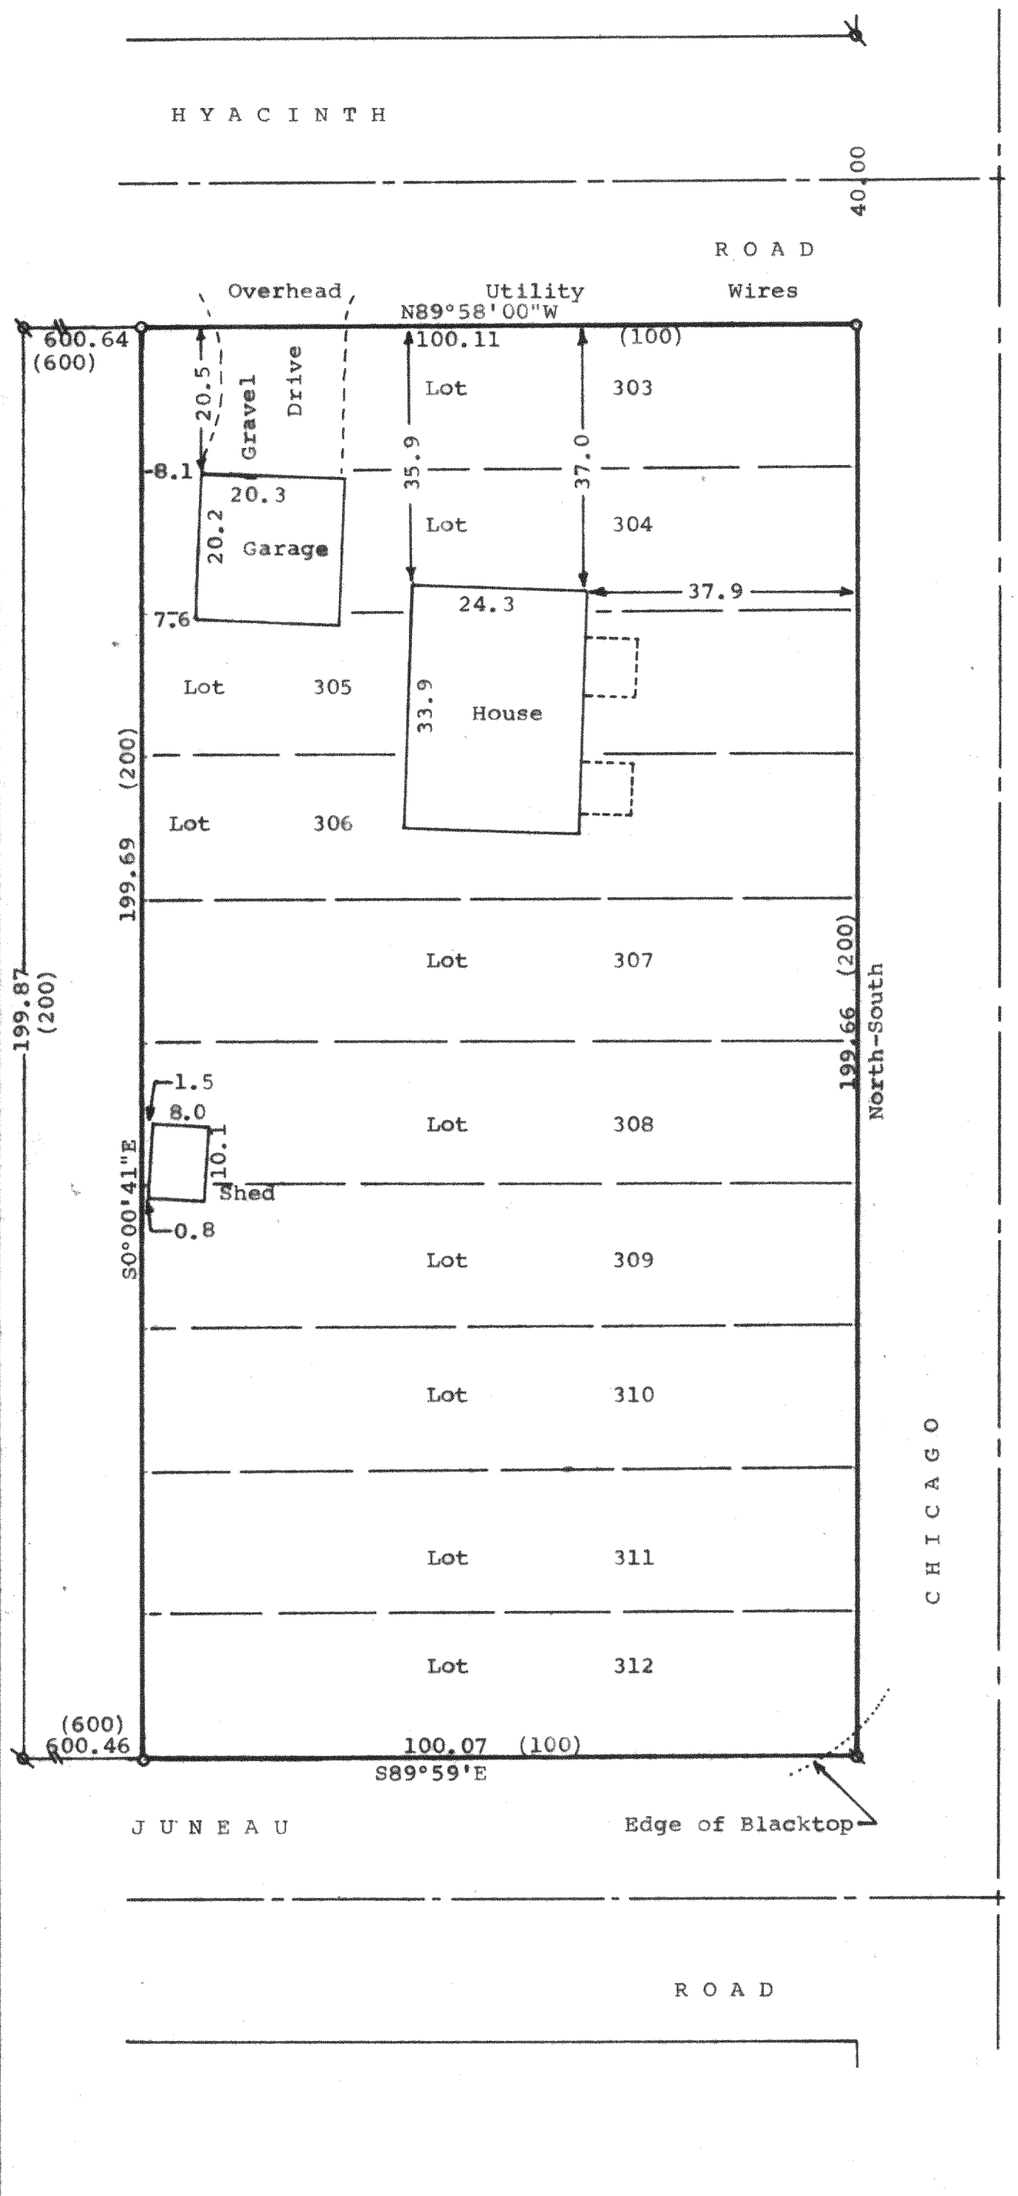

N

Scale - 1" = 20'

● = 1" Dia. Iron Pipe Found

o = 1"x24" Iron Pipe Set

(00) = Recorded Distances

Bearings are based on the West line of Chicago Drive, Assumed bearing of North.

Owner: Robert & Laura Baldys
W849 Hyacinth Road
Pell Lake, Wisconsin

STATE OF WISCONSIN)
SS
COUNTY OF WALWORTH)

I, George T. Dunham, Surveyor, certify that I have surveyed the property described as follows,

Lots 303 to 312 inclusive, Block 6 of Pell Lake Addition, T1N, R18E, Walworth County, Wisconsin,

and that the map shown above is a true representation thereof and shows the size and location of the property, its exterior boundaries, the location of all visible structures and dimensions of all principal buildings thereon, boundary fences, apparent easements, roadways and visible encroachments, if any, and that I have surveyed the property hereon described according to the official records, to the best of my knowledge and belief.

June 14, 1984.

George T. Dunham, Surveyor

WISCONSIN
GEORGE T. DUNHAM
DELAVAN, WIS.
S-306
LAND SURVEYOR

K & E 10-8155

MPLA-00064
" 00065

118-650-D