
KOLB LAND CONSULTING, INC.

LAND SURVEYING · SUBDIVIDING · LAND PLANNING

LAKE GENEVA, WISCONSIN 53147

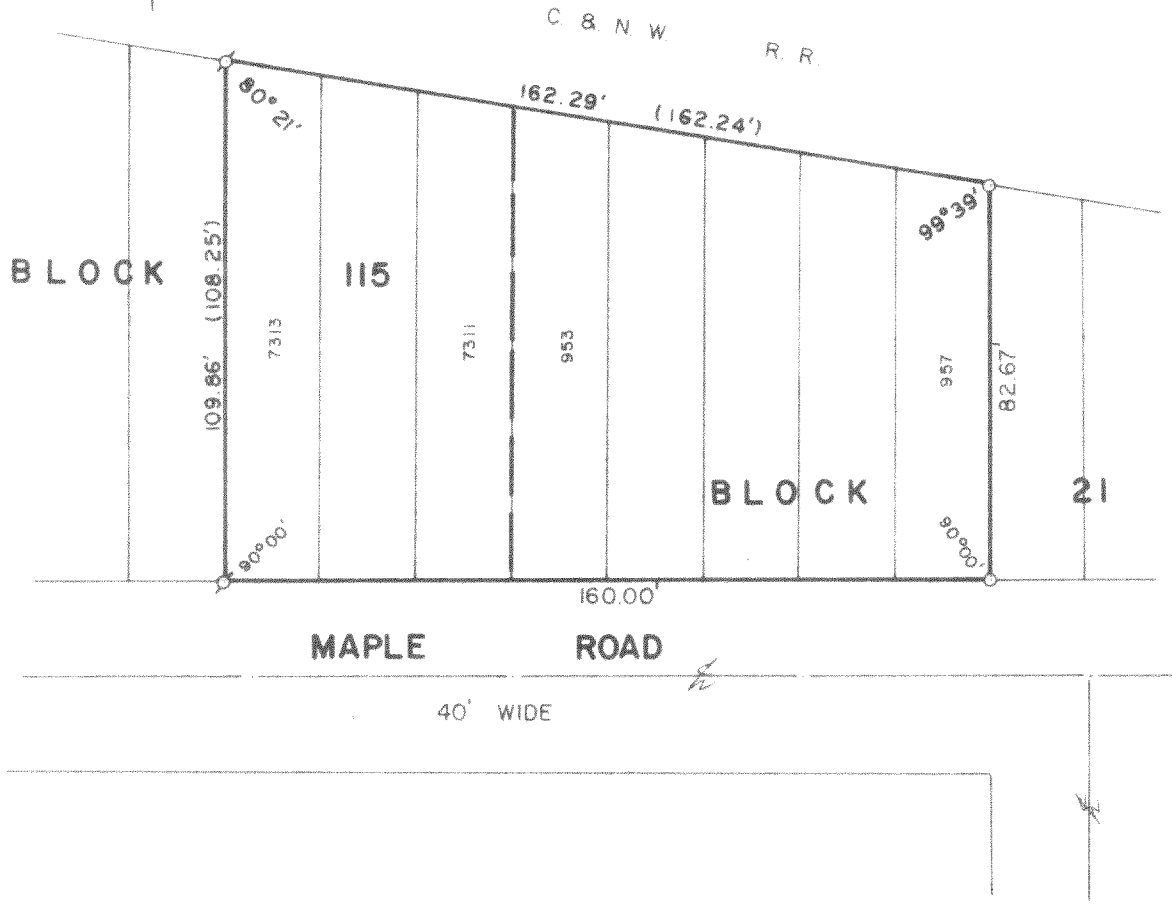

PLAT OF SURVEY OF

LOTS 7311-7313, BLOCK 115 AND LOTS 953-957, BLOCK 21, PELL LAKE SUBDIVISION, T1N,R18E, WALWORTH COUNTY, WISCONSIN.

ORDERED BY: ERVIN BURKETT
BOX 132
PELL LAKE, WI 53157

NOTE: THE RECORDED DISTANCE ON THE EAST LINE OF BLOCK 115 IS 98.24 FEET.
THE RECORDED DISTANCE ON THE WEST LINE OF BLOCK 21 IS 99.34 FEET.

SCALE - 1"=40'

LEGEND
ø - IRON PIPE FOUND
o - IRON PIPE SET
( ) - RECORDED AS

I, HAROLD H. KOLB, DO HEREBY CERTIFY THAT I HAVE SURVEYED THE PROPERTY HEREON DESCRIBED ACCORDING TO THE OFFICIAL RECORDS, AND THAT THE PLAT HEREON IS A CORRECT REPRESENTATION OF THE LOT LINES TO THE BEST OF MY KNOWLEDGE AND BELIEF.

Harold H. Kolb

HAROLD H. KOLB
WISCONSIN REGISTERED LAND SURVEYOR, S- 18

DATE NOVEMBER 2, 1982

MPL 01557A ✓ + MPL-00213 118-653-K