KOLB LAND CONSULTING, INC.

LAND SURVEYING · SUBDIVIDING · LAND PLANNING

LAKE GENEVA, WISCONSIN 53147 WHITEWATER, WISCONSIN 53190

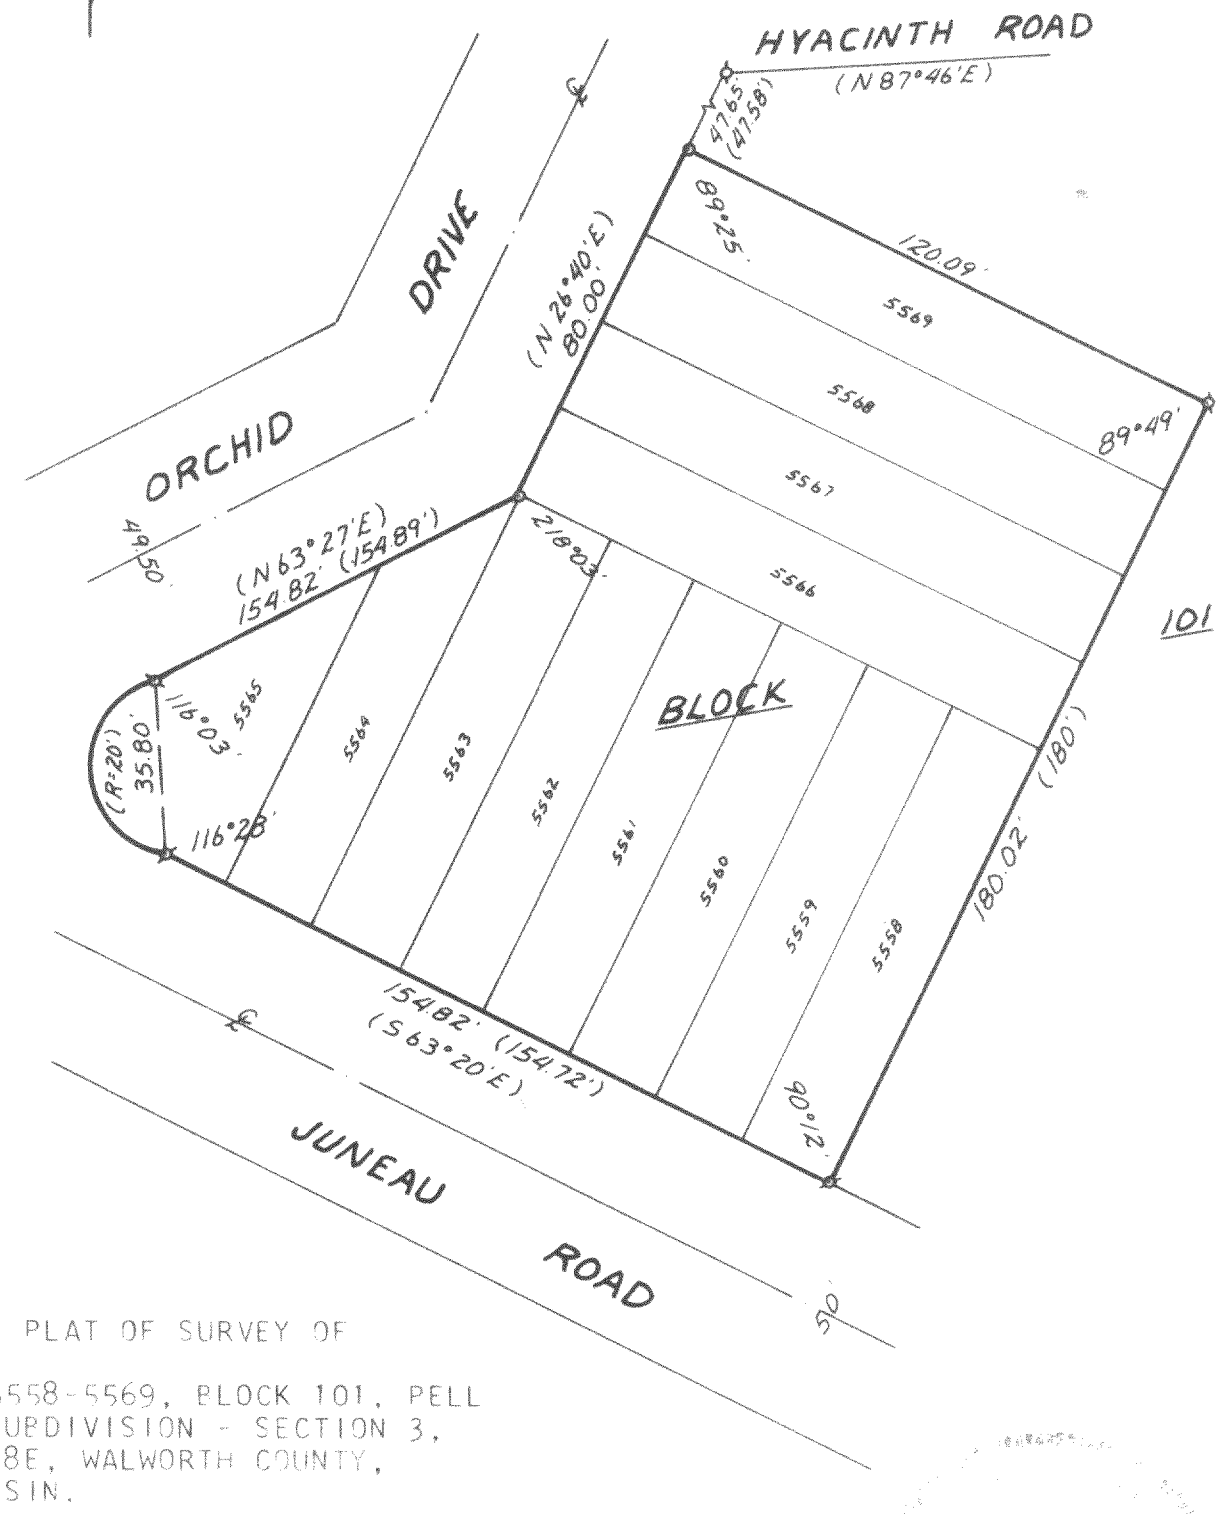

PLAT OF SURVEY OF

LOTS 5558-5569, BLOCK 101, PELL LAKE SUBDIVISION - SECTION 3, T1N, R18E, WALWORTH COUNTY, WISCONSIN.

ORDERED BY: ROBERT USTIANOWSKI
P.O. BOX 277
PELL LAKE, WI 53157

SCALE - 1"=40'

LEGEND

⌀ - IRON PIPE FOUND
o - IRON PIPE SET
( ) - RECORDED AS

I, HAROLD H. KOLB, DO HEREBY CERTIFY THAT I HAVE SURVEYED THE PROPERTY HEREON DESCRIBED ACCORDING TO THE OFFICIAL RECORDS, AND THAT THE PLAT HEREON IS A CORRECT REPRESENTATION OF THE LOT LINES TO THE BEST OF MY KNOWLEDGE AND BELIEF.

Harold H. Kolb

HAROLD H. KOLB
WISCONSIN REGISTERED LAND SURVEYOR, S- 187
DATE MAY 31, 1984

118-658 ✓