
# WALWORTH COUNTY
# SURVEYING & MAPPING
# LAKE GENEVA, WISCONSIN

RECEIVED
JUL 3 0 1985
W. L.

SCALE: 1"=50'

ø -IRON PIPE FOUND
()-RECORDED AS

ORDERED BY: STANICK REALTY
7520 39TH AVE.
KENOSHA, WI

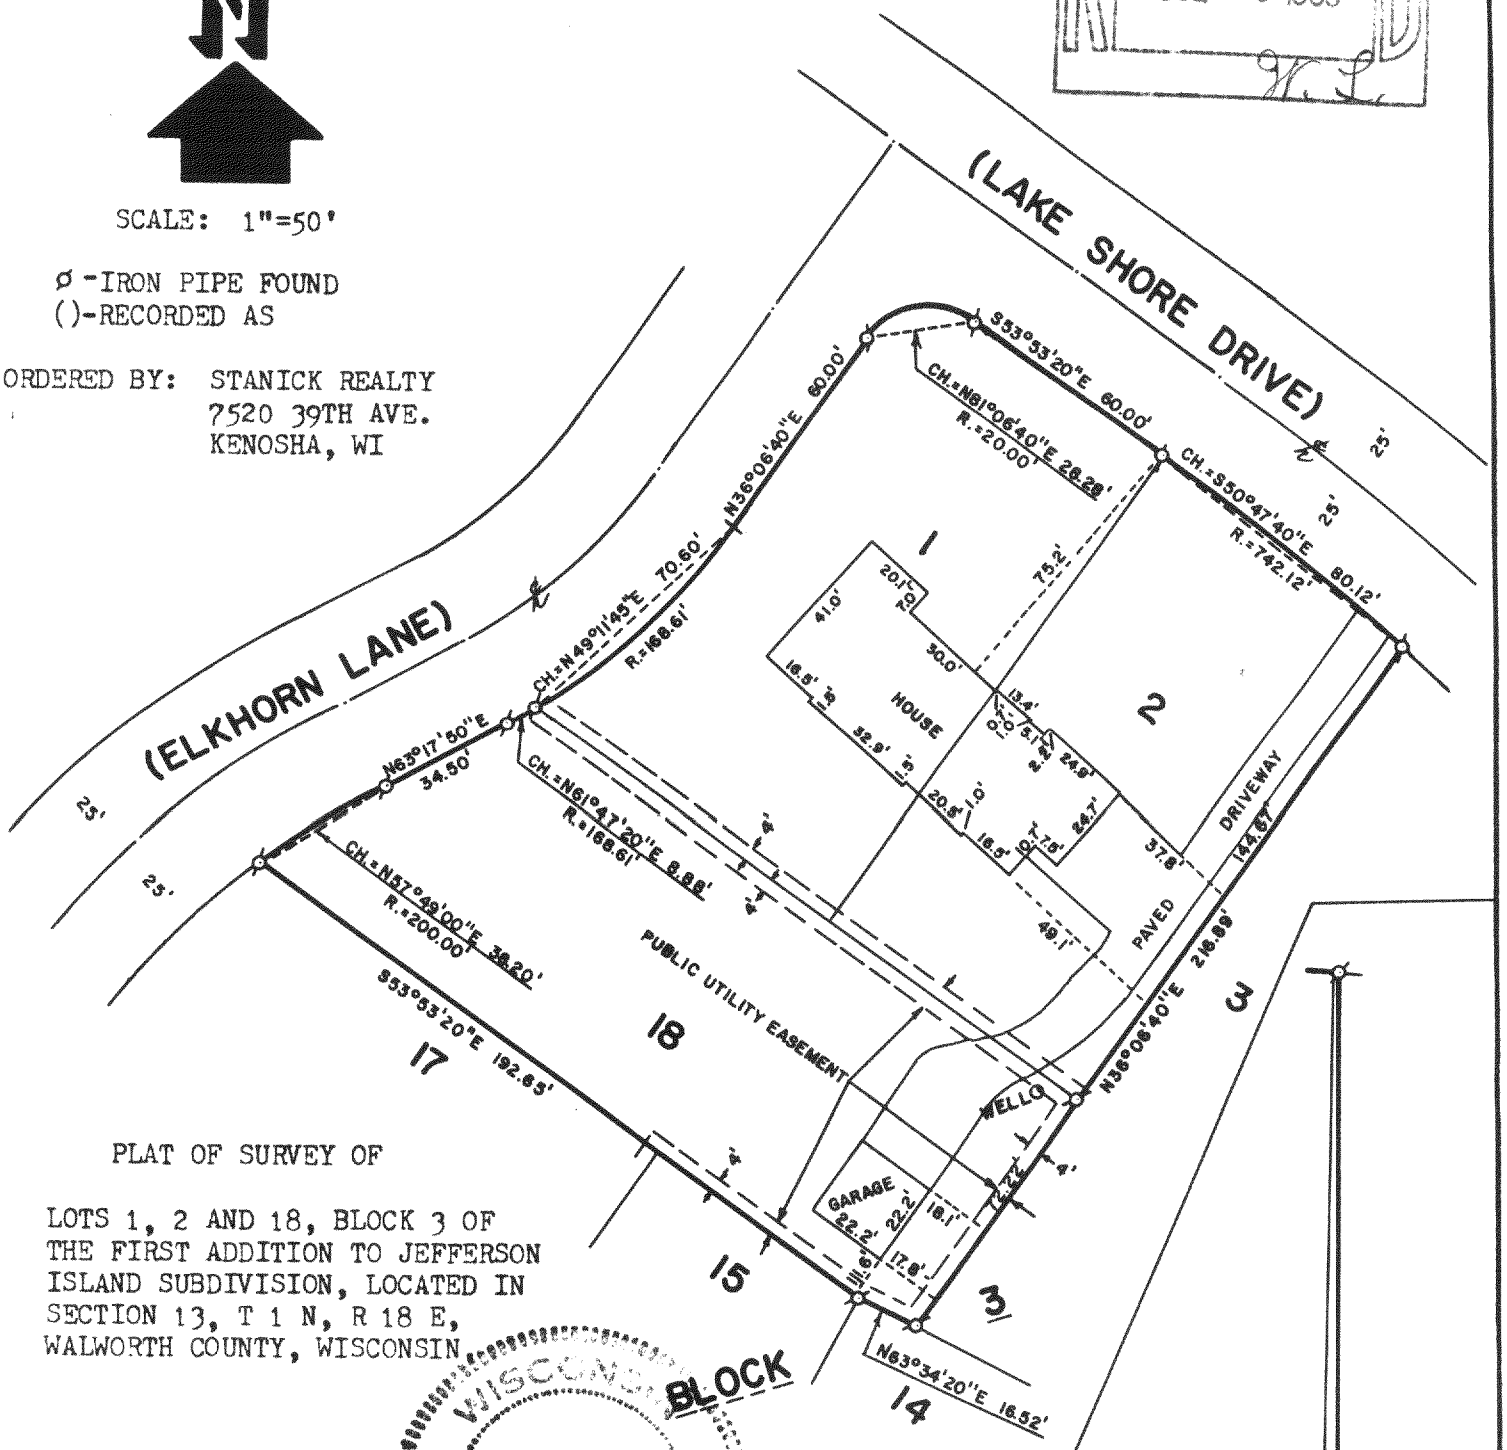



PLAT OF SURVEY OF

LOTS 1, 2 AND 18, BLOCK 3 OF THE FIRST ADDITION TO JEFFERSON ISLAND SUBDIVISION, LOCATED IN SECTION 13, T 1 N, R 18 E, WALWORTH COUNTY, WISCONSIN.

WISCONSIN
ROBERT M
BAERENWALD
Lake Geneva, WI
S-1508
LAND SURVEYOR

INSERT SCALE 1"=20'

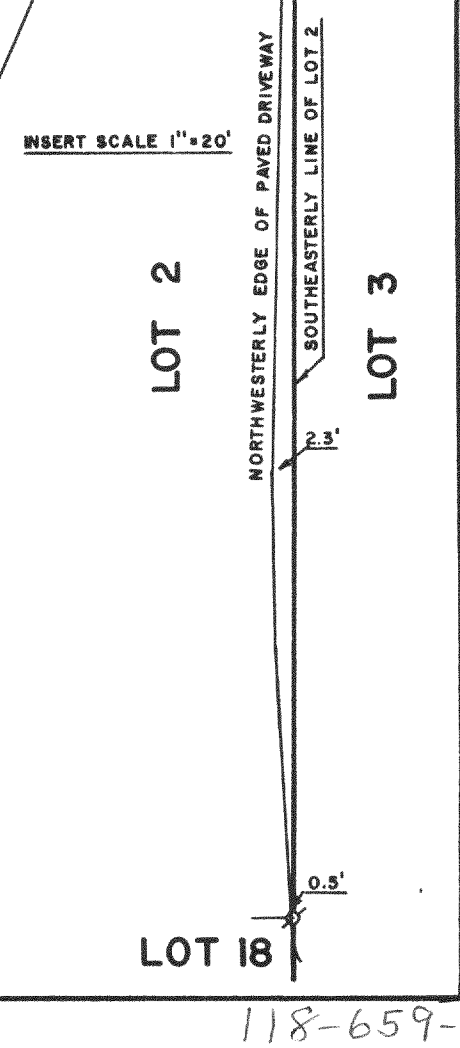


I HEREBY CERTIFY THAT I HAVE SURVEYED THE ABOVE DESCRIBED PROPERTY AND THAT THE ABOVE MAP IS A TRUE REPRESENTATION THEREOF AND SHOWS THE SIZE AND LOCATION OF THE PROPERTY, ITS EXTERIOR BOUNDARIES, THE LOCATION OF ALL VISIBLE STRUCTURES AND DIMENSIONS OF ALL PRINCIPAL BUILDINGS THEREON, BOUNDARY FENCES, APPARENT EASEMENTS, ROADWAYS AND VISIBLE ENCROACHMENTS, IF ANY.

THIS SURVEY IS MADE FOR THE USE OF THE PRESENT OWNERS OF THE PROPERTY AND ALSO THOSE WHO PURCHASE, MORTGAGE, OR GUARANTEE THE TITLE THERETO WITHIN ONE (1) YEAR FROM DATE HEREOF.

Robert M. Baerenwald
ROBERT M. BAERENWALD
WISCONSIN REGISTERED LAND SURVEYOR, S-1508

January 16, 1985
DATE JOB NO. 0187

MJS-17,34

118-659-B