
WALWORTH COUNTY
SURVEYING & MAPPING
LAKE GENEVA, WISCONSIN

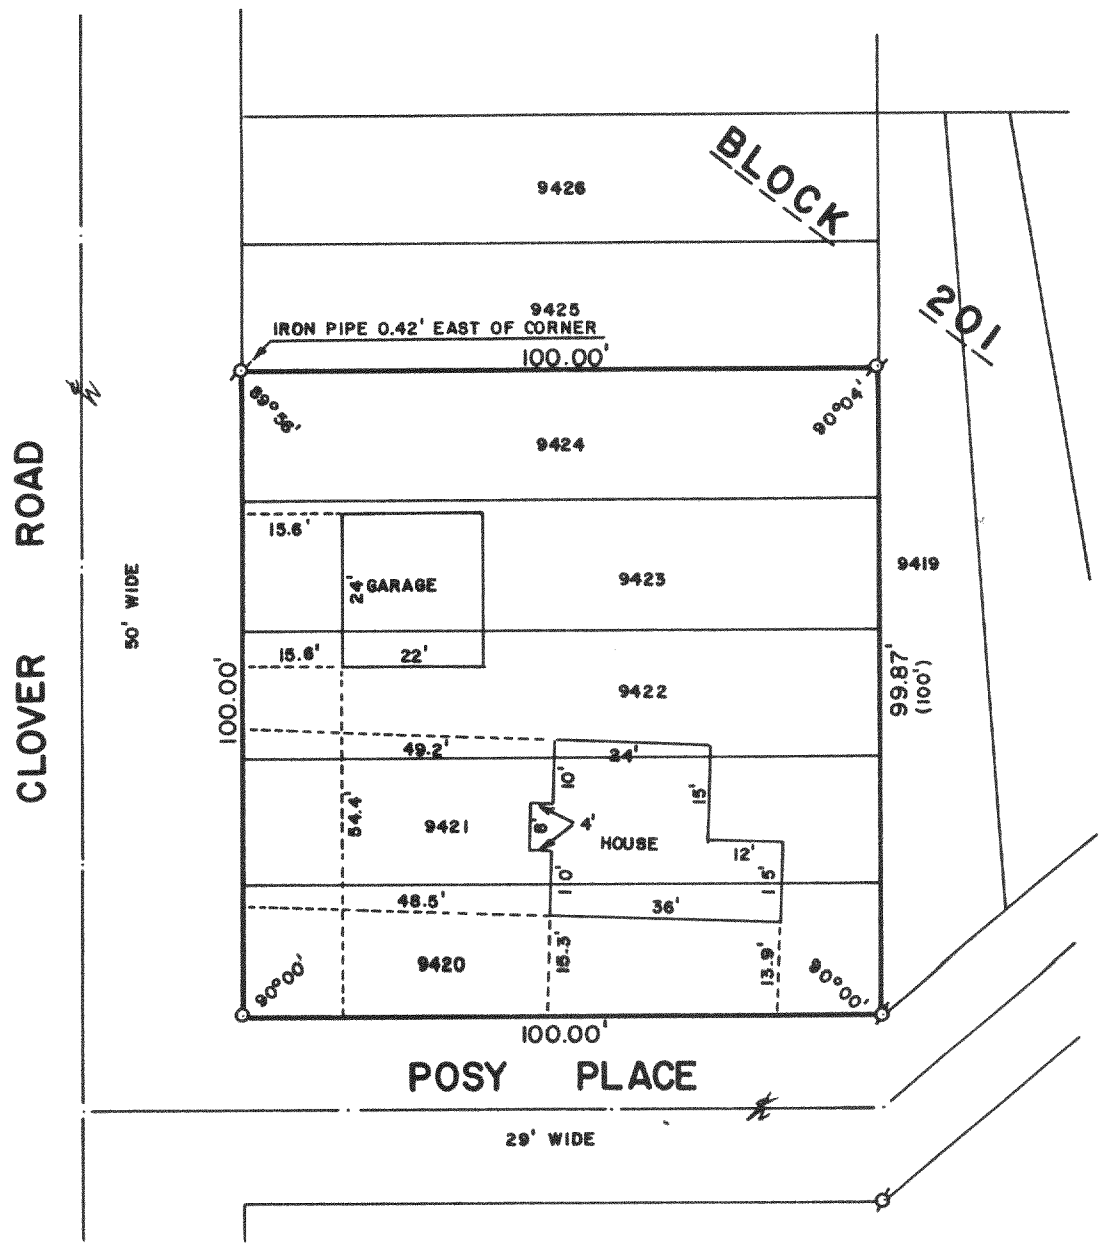

WISCONSIN
ROBERT M
BAERENWALD
Lake Geneva, WI.
S-1508
REGISTERED LAND SURVEYOR

RECEIVED
JUL 30 1985

PLAT OF SURVEY OF

LOTS 9420-9424, BLOCK 201 OF SECTION 6 OF PELL LAKE, A SUBDIVISION LOCATED IN SECTION 15, T 1 N, R 18 E, WALWORTH COUNTY, WISCONSIN.

ORDERED BY: KEEFE REAL ESTATE
P. O. BOX 365
DELAVAN, WISCONSIN 53115

I, ROBERT M. BAERENWALD, DO HEREBY CERTIFY THAT I HAVE SURVEYED THE PROPERTY HEREON DESCRIBED ACCORDING TO THE OFFICIAL RECORDS AND THAT THE PLAT HEREON IS A CORRECT REPRESENTATION OF THE PROPERTY LINES TO THE BEST OF MY KNOWLEDGE AND BELIEF.

Robert M. Baerenwald
ROBERT M. BAERENWALD
WISCONSIN REGISTERED LAND SURVEYOR, S-1508

January 22, 1985
DATE JOB NO. 0191

SCALE: 1"=30'

ø -IRON PIPE FOUND
o -IRON PIPE PLACED
()-RECORDED AS

MPL-01911

118-671-B